


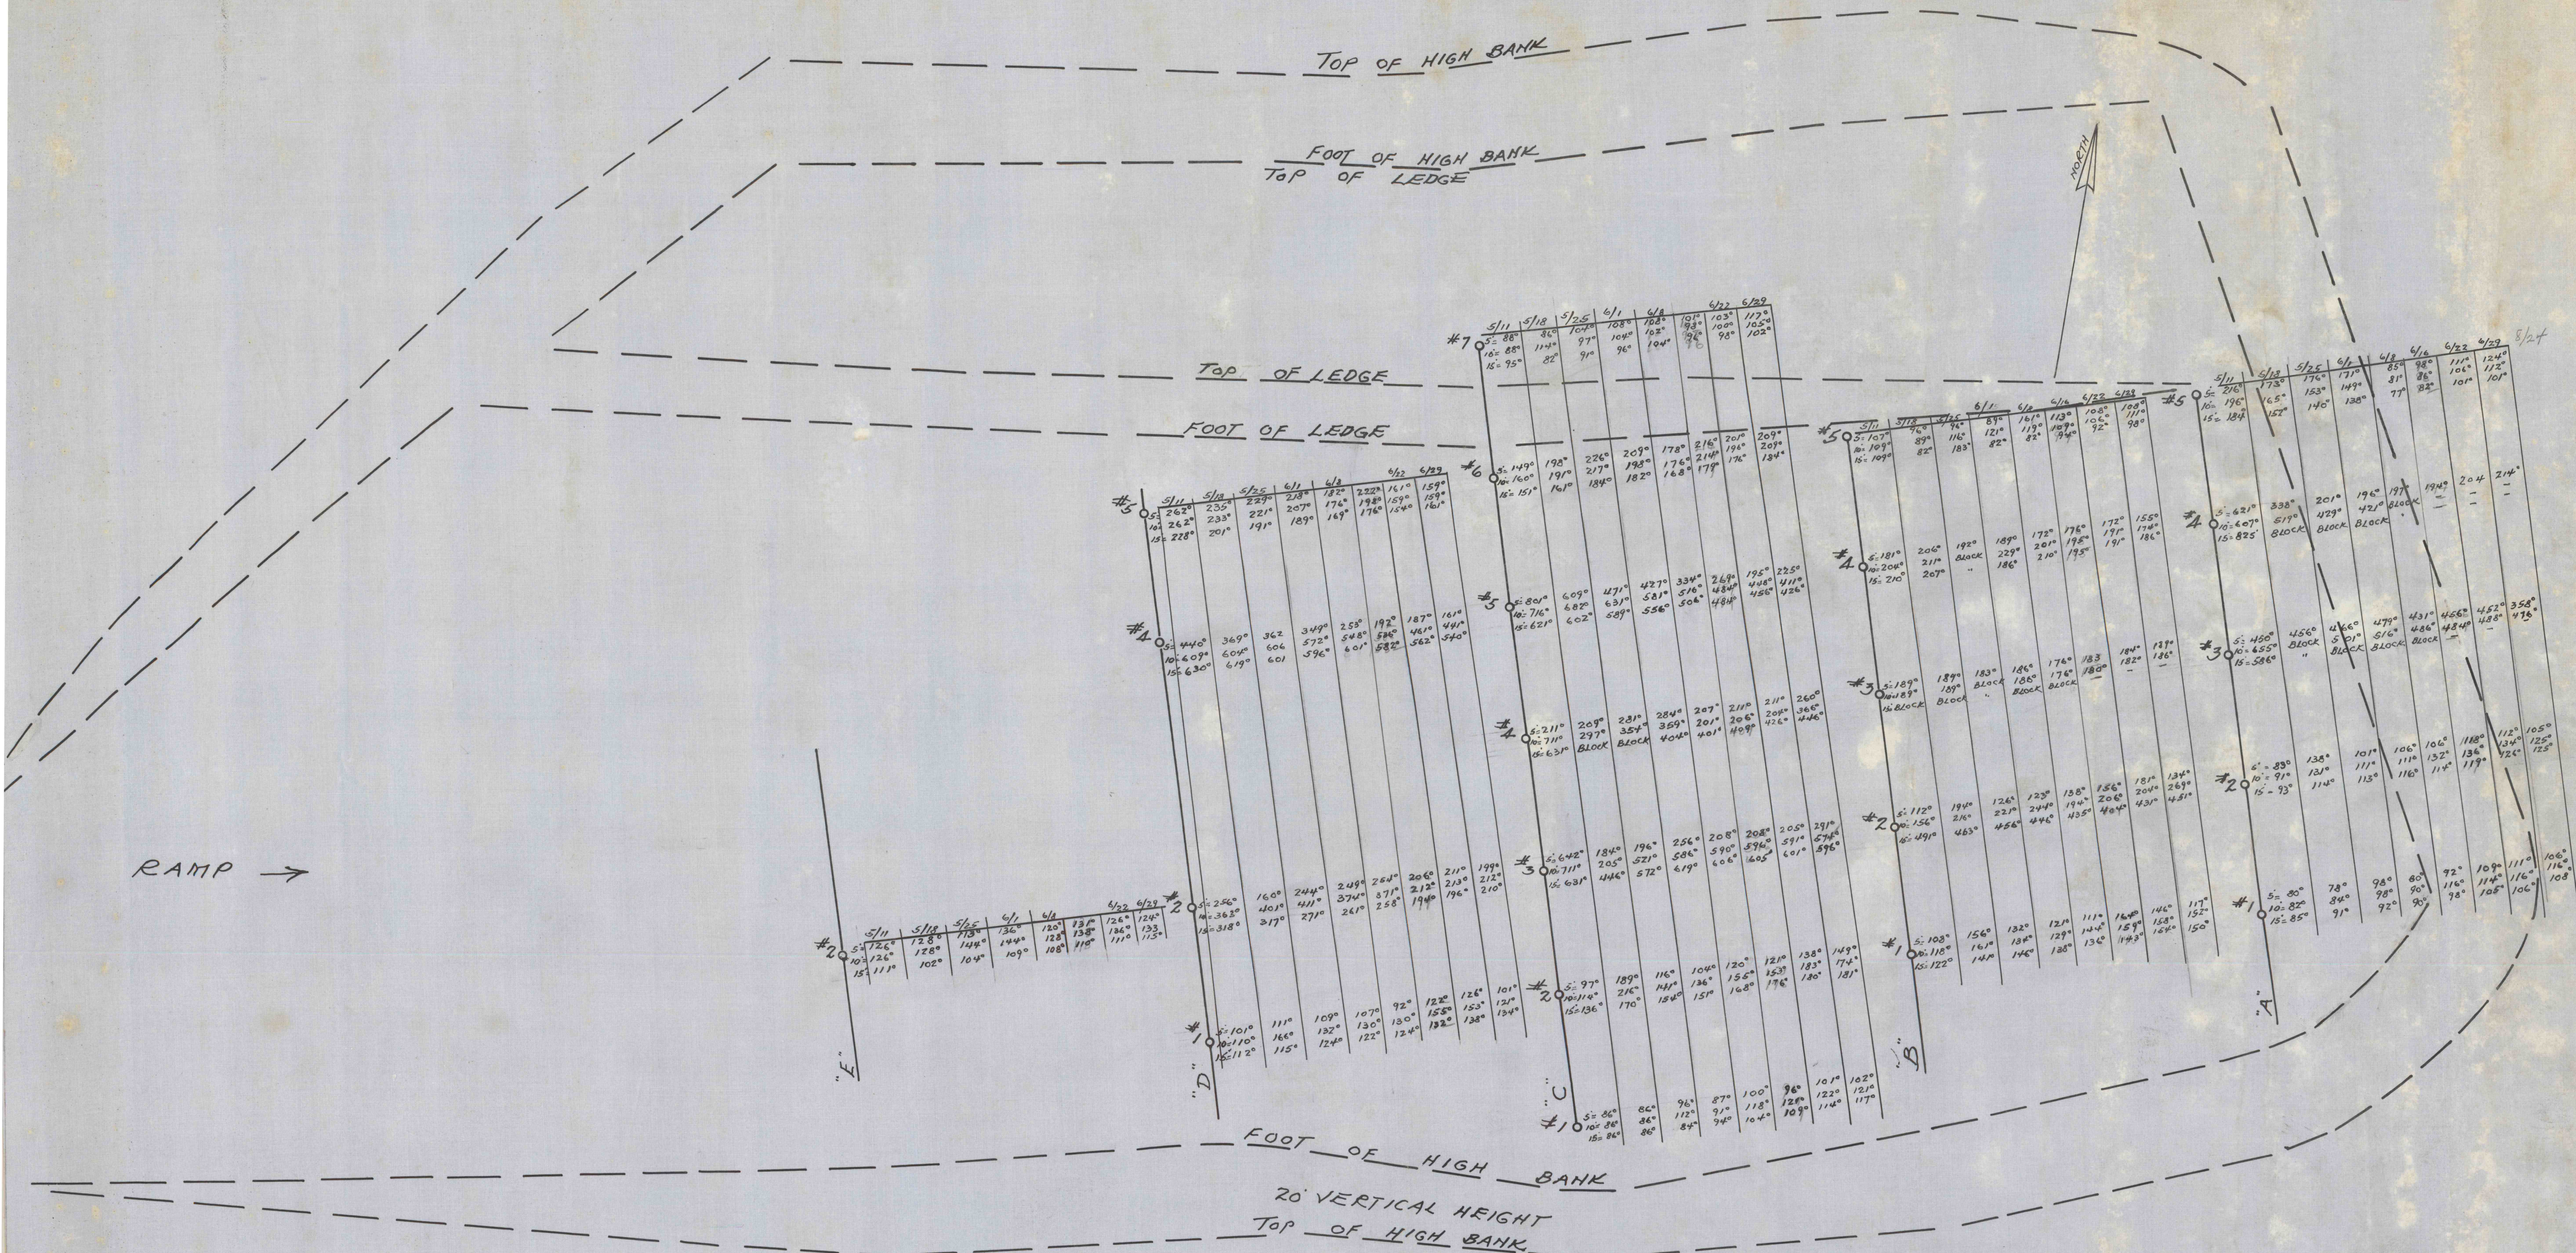

CIRCLES DENOTE 1 1/4" IRON PIPE DRIVEN VERTICALLY INTO BANK
 TEMPERATURES TAKEN AT 5, 10 AND 15' INTERVALS.
 COMPARISON OF TEMPERATURES (TAKEN WEEKLY.)

PACKER NO. 4 REFUSE BANK.
 MAP SHOWING LOCATION OF FIRE AREA
 SCALE 1" = 10'
 GIRARDVILLE, PENNA.

6-4-70
 MAY 11 - JUNE 29 INC.