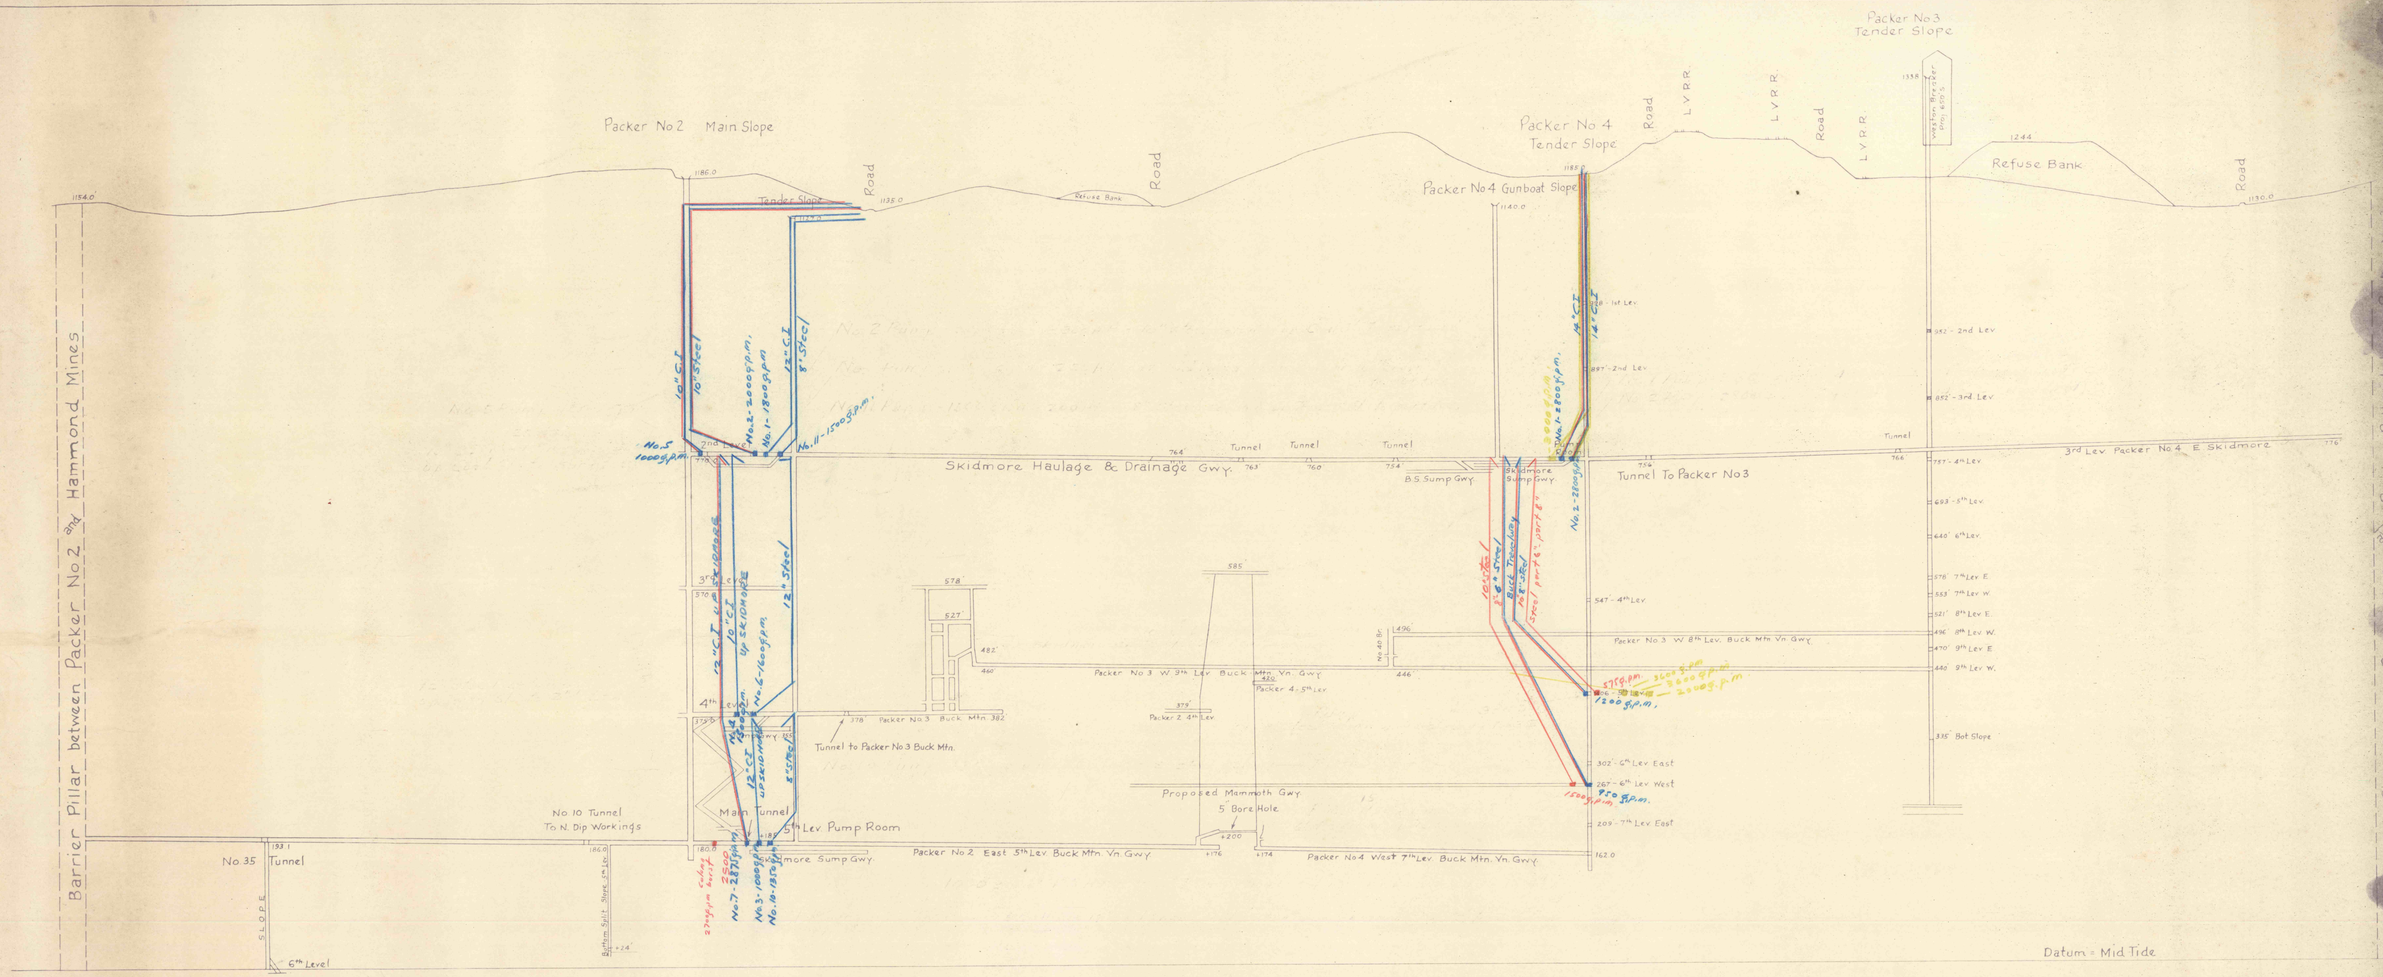


Longitudinal Section Through Packer 2-3-4 Mines

Scale: Hor. 1" = 300'
Ver. 1" = 100'