


SKETCH SHOWING MOVEMENT OF SHAFT

SCALE Vertical 1": 10'
Horizontal 1/2": 1"

Pottsville, Pa.,
May 1, 1946.

W. P. Millington,
MINING ENGINEER & AGENT
GIRARD ESTATE

NORTH

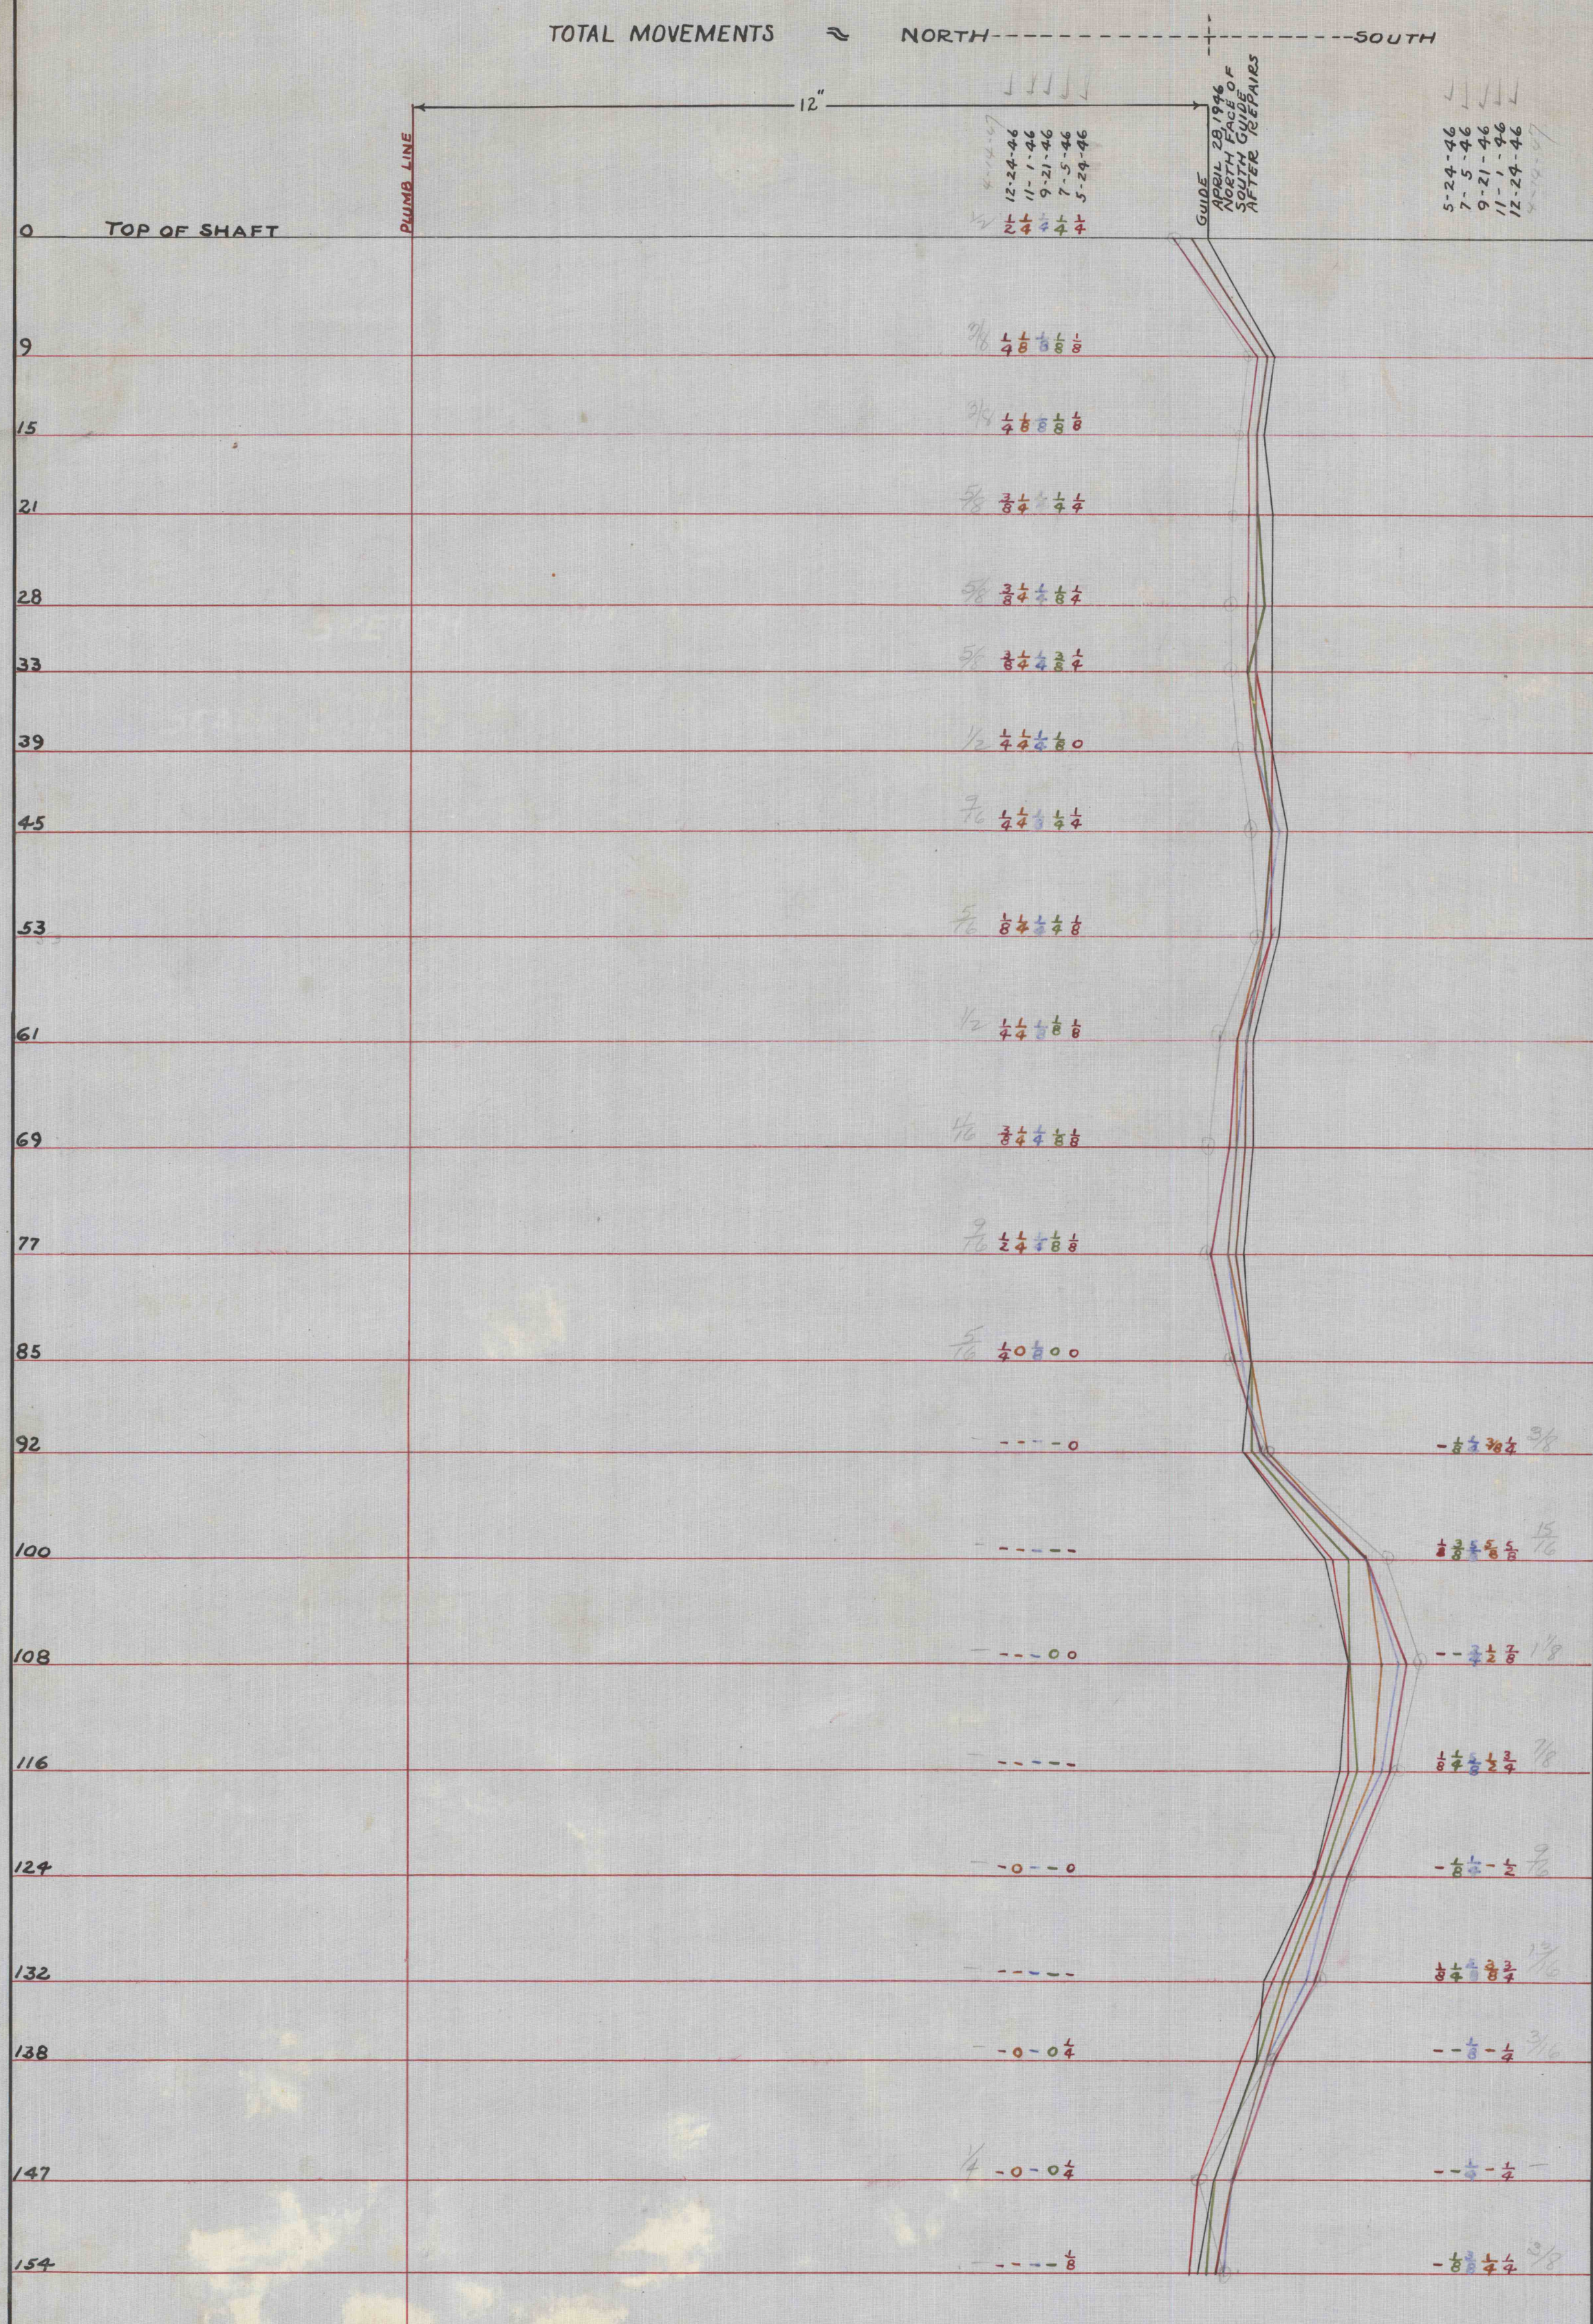

16110 TOP OF PALEOZOIC LEVEL

475 SECOND LEVEL