

J O H N

B R A D Y

T R A C T

J O S E P H

PACKER


COLLIERY No 2

N° 29 MON.

N° 12.13

TENDER SLOPE

PLANE 111

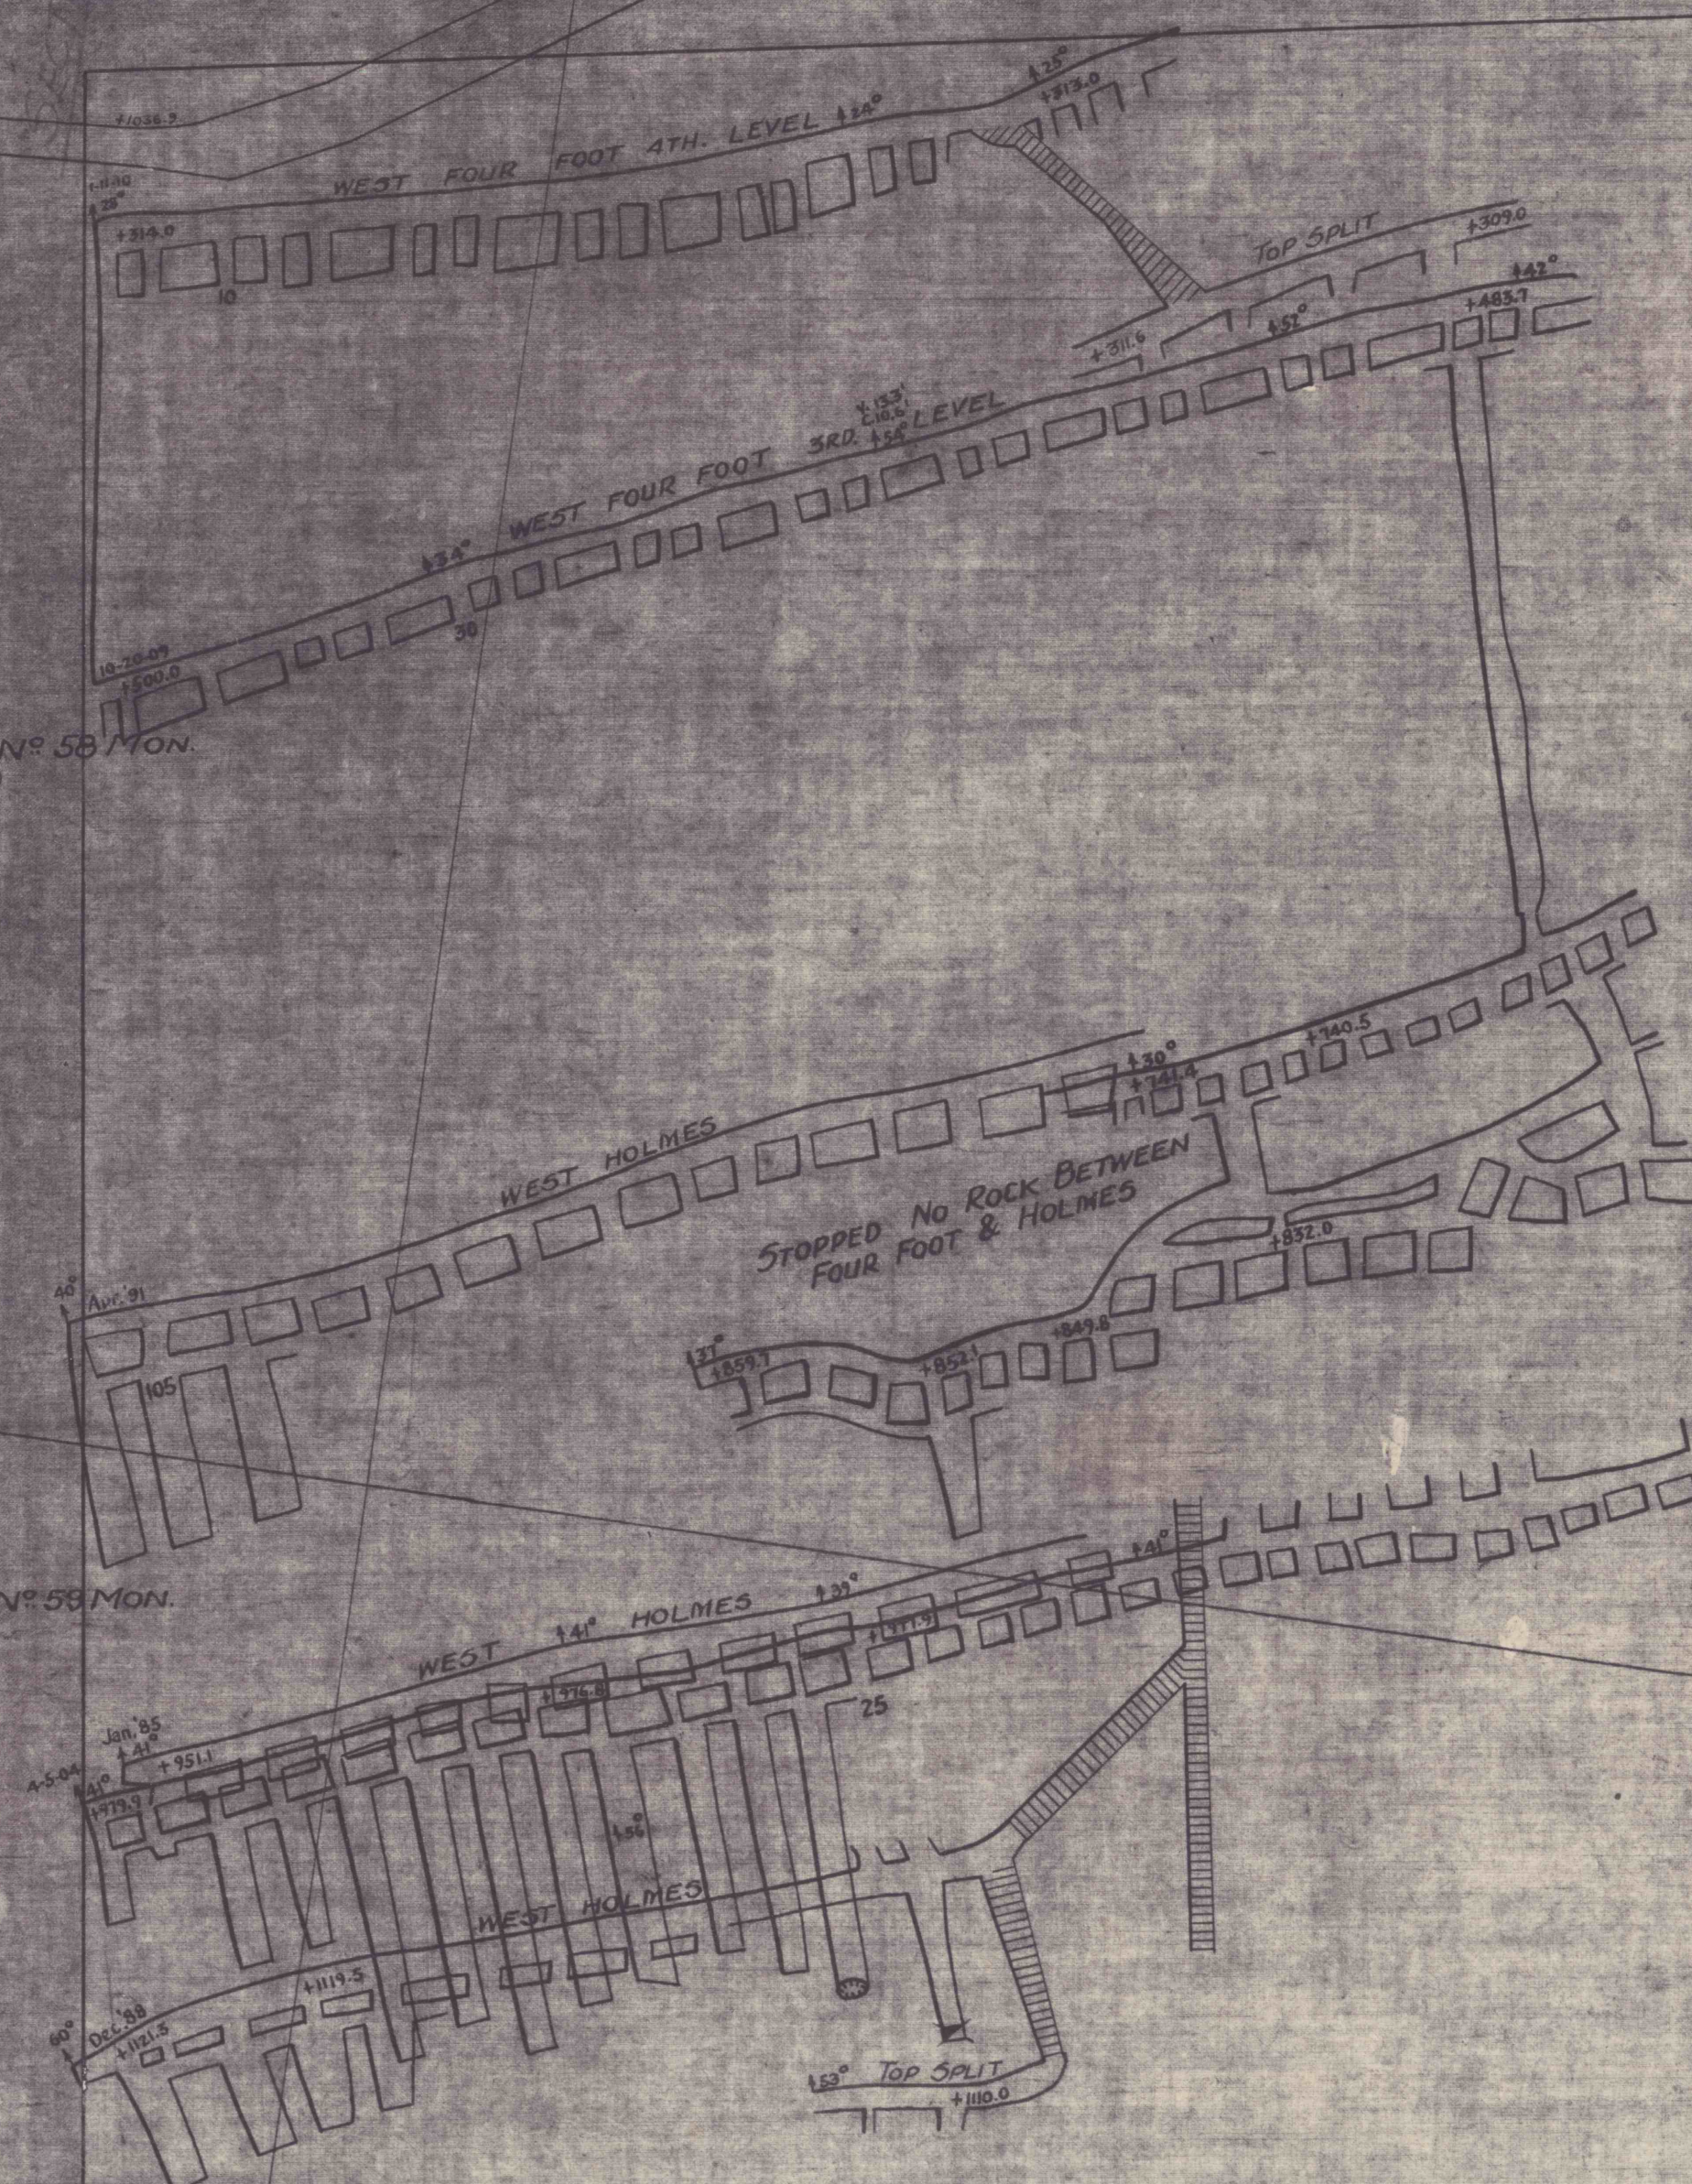

HOLMES V.N.