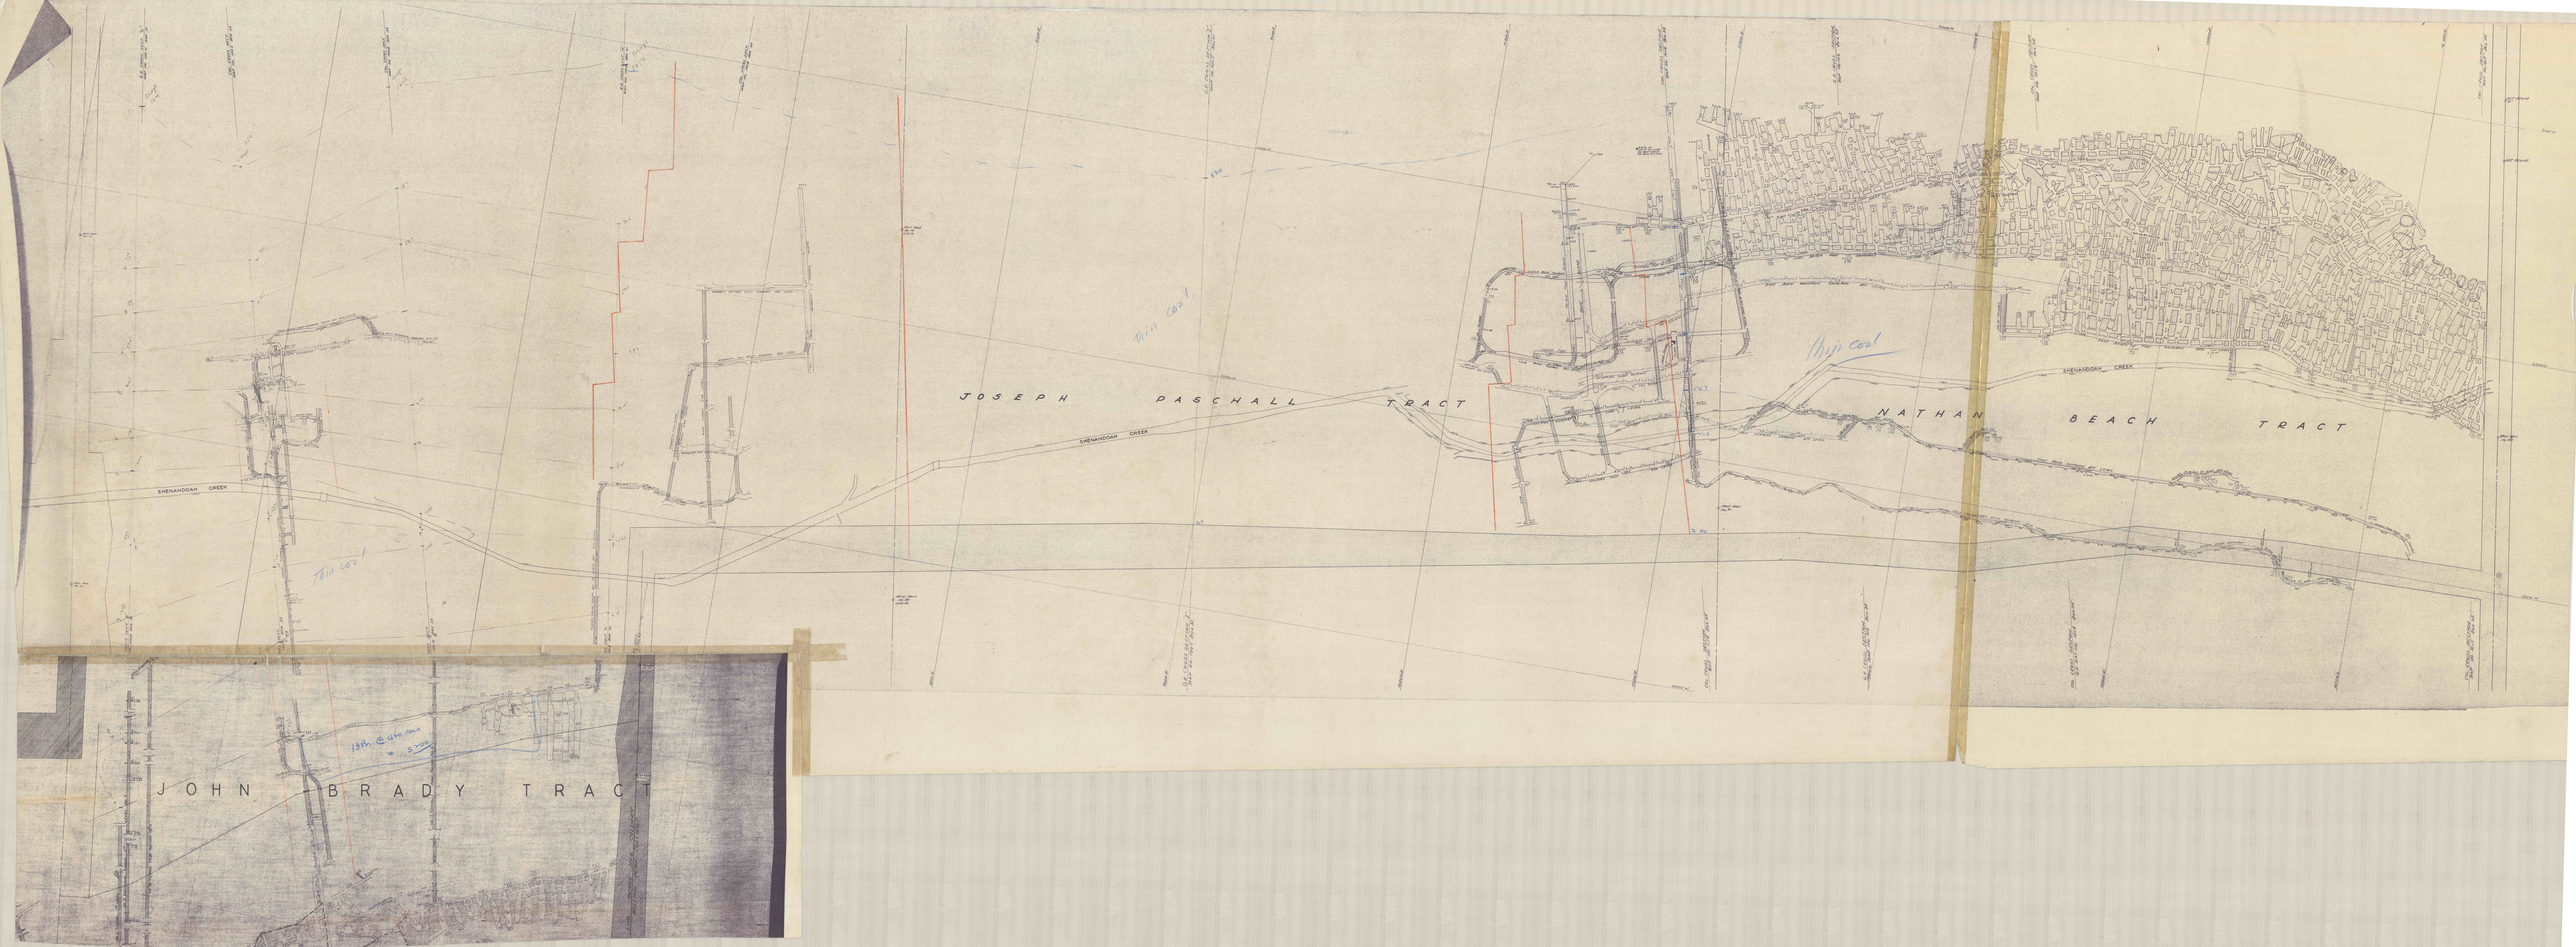
JOHN BRADY TRACT
JOSEPH PASCHALL TRACT
NATHAN BEACH TRACT
SHENANDOAH CREEK