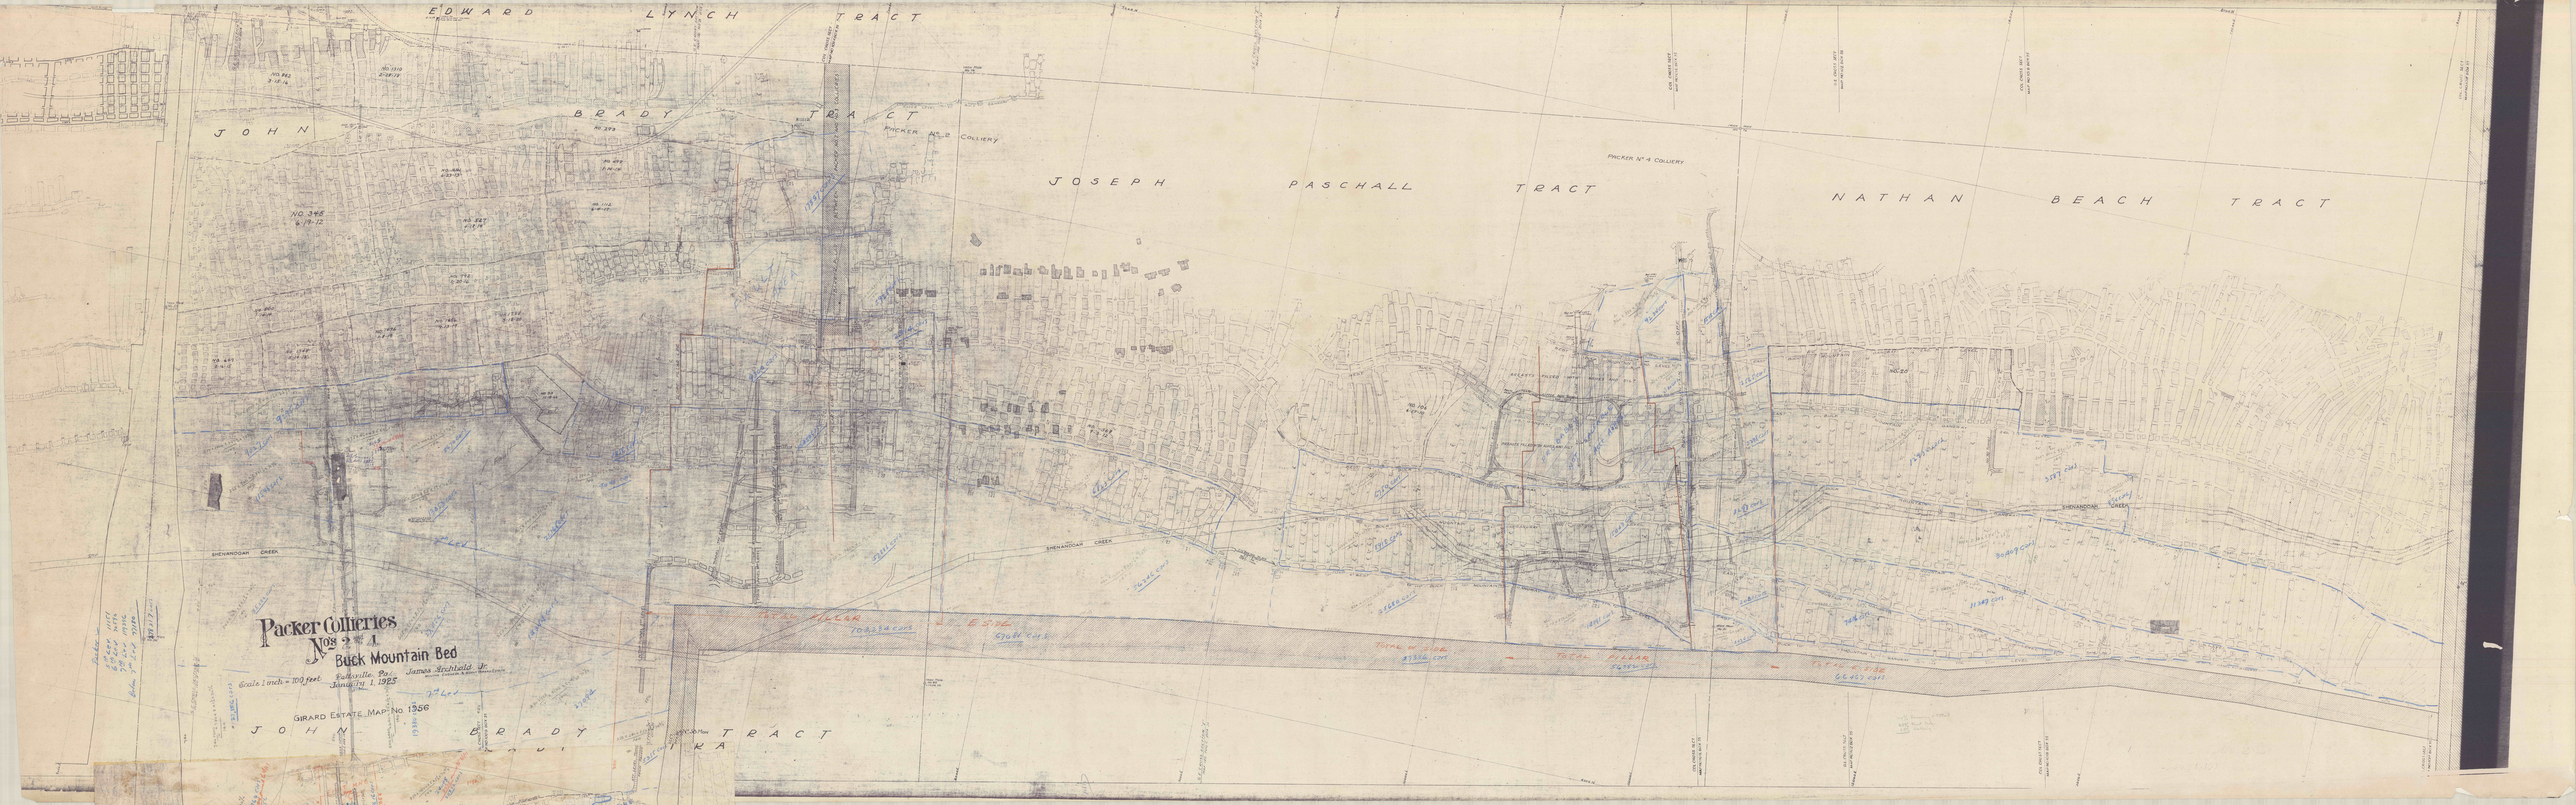

EDWARD LYNCH TRACT
JOHN BRADY TRACT
JOSEPH PASCHALL TRACT
NATHAN BEACH TRACT
PACKER No. 2 COLLIERY
PACKER No. 4 COLLIERY
SHENANDOAH CREEK
Packer Collieries
Nos 2 & 4
Buck Mountain Bed
Scale 1 inch = 100 feet
Pottsville, Pa.
January 1, 1925
James Archbald Jr.
