


MAP No. 1236
Box No. 17

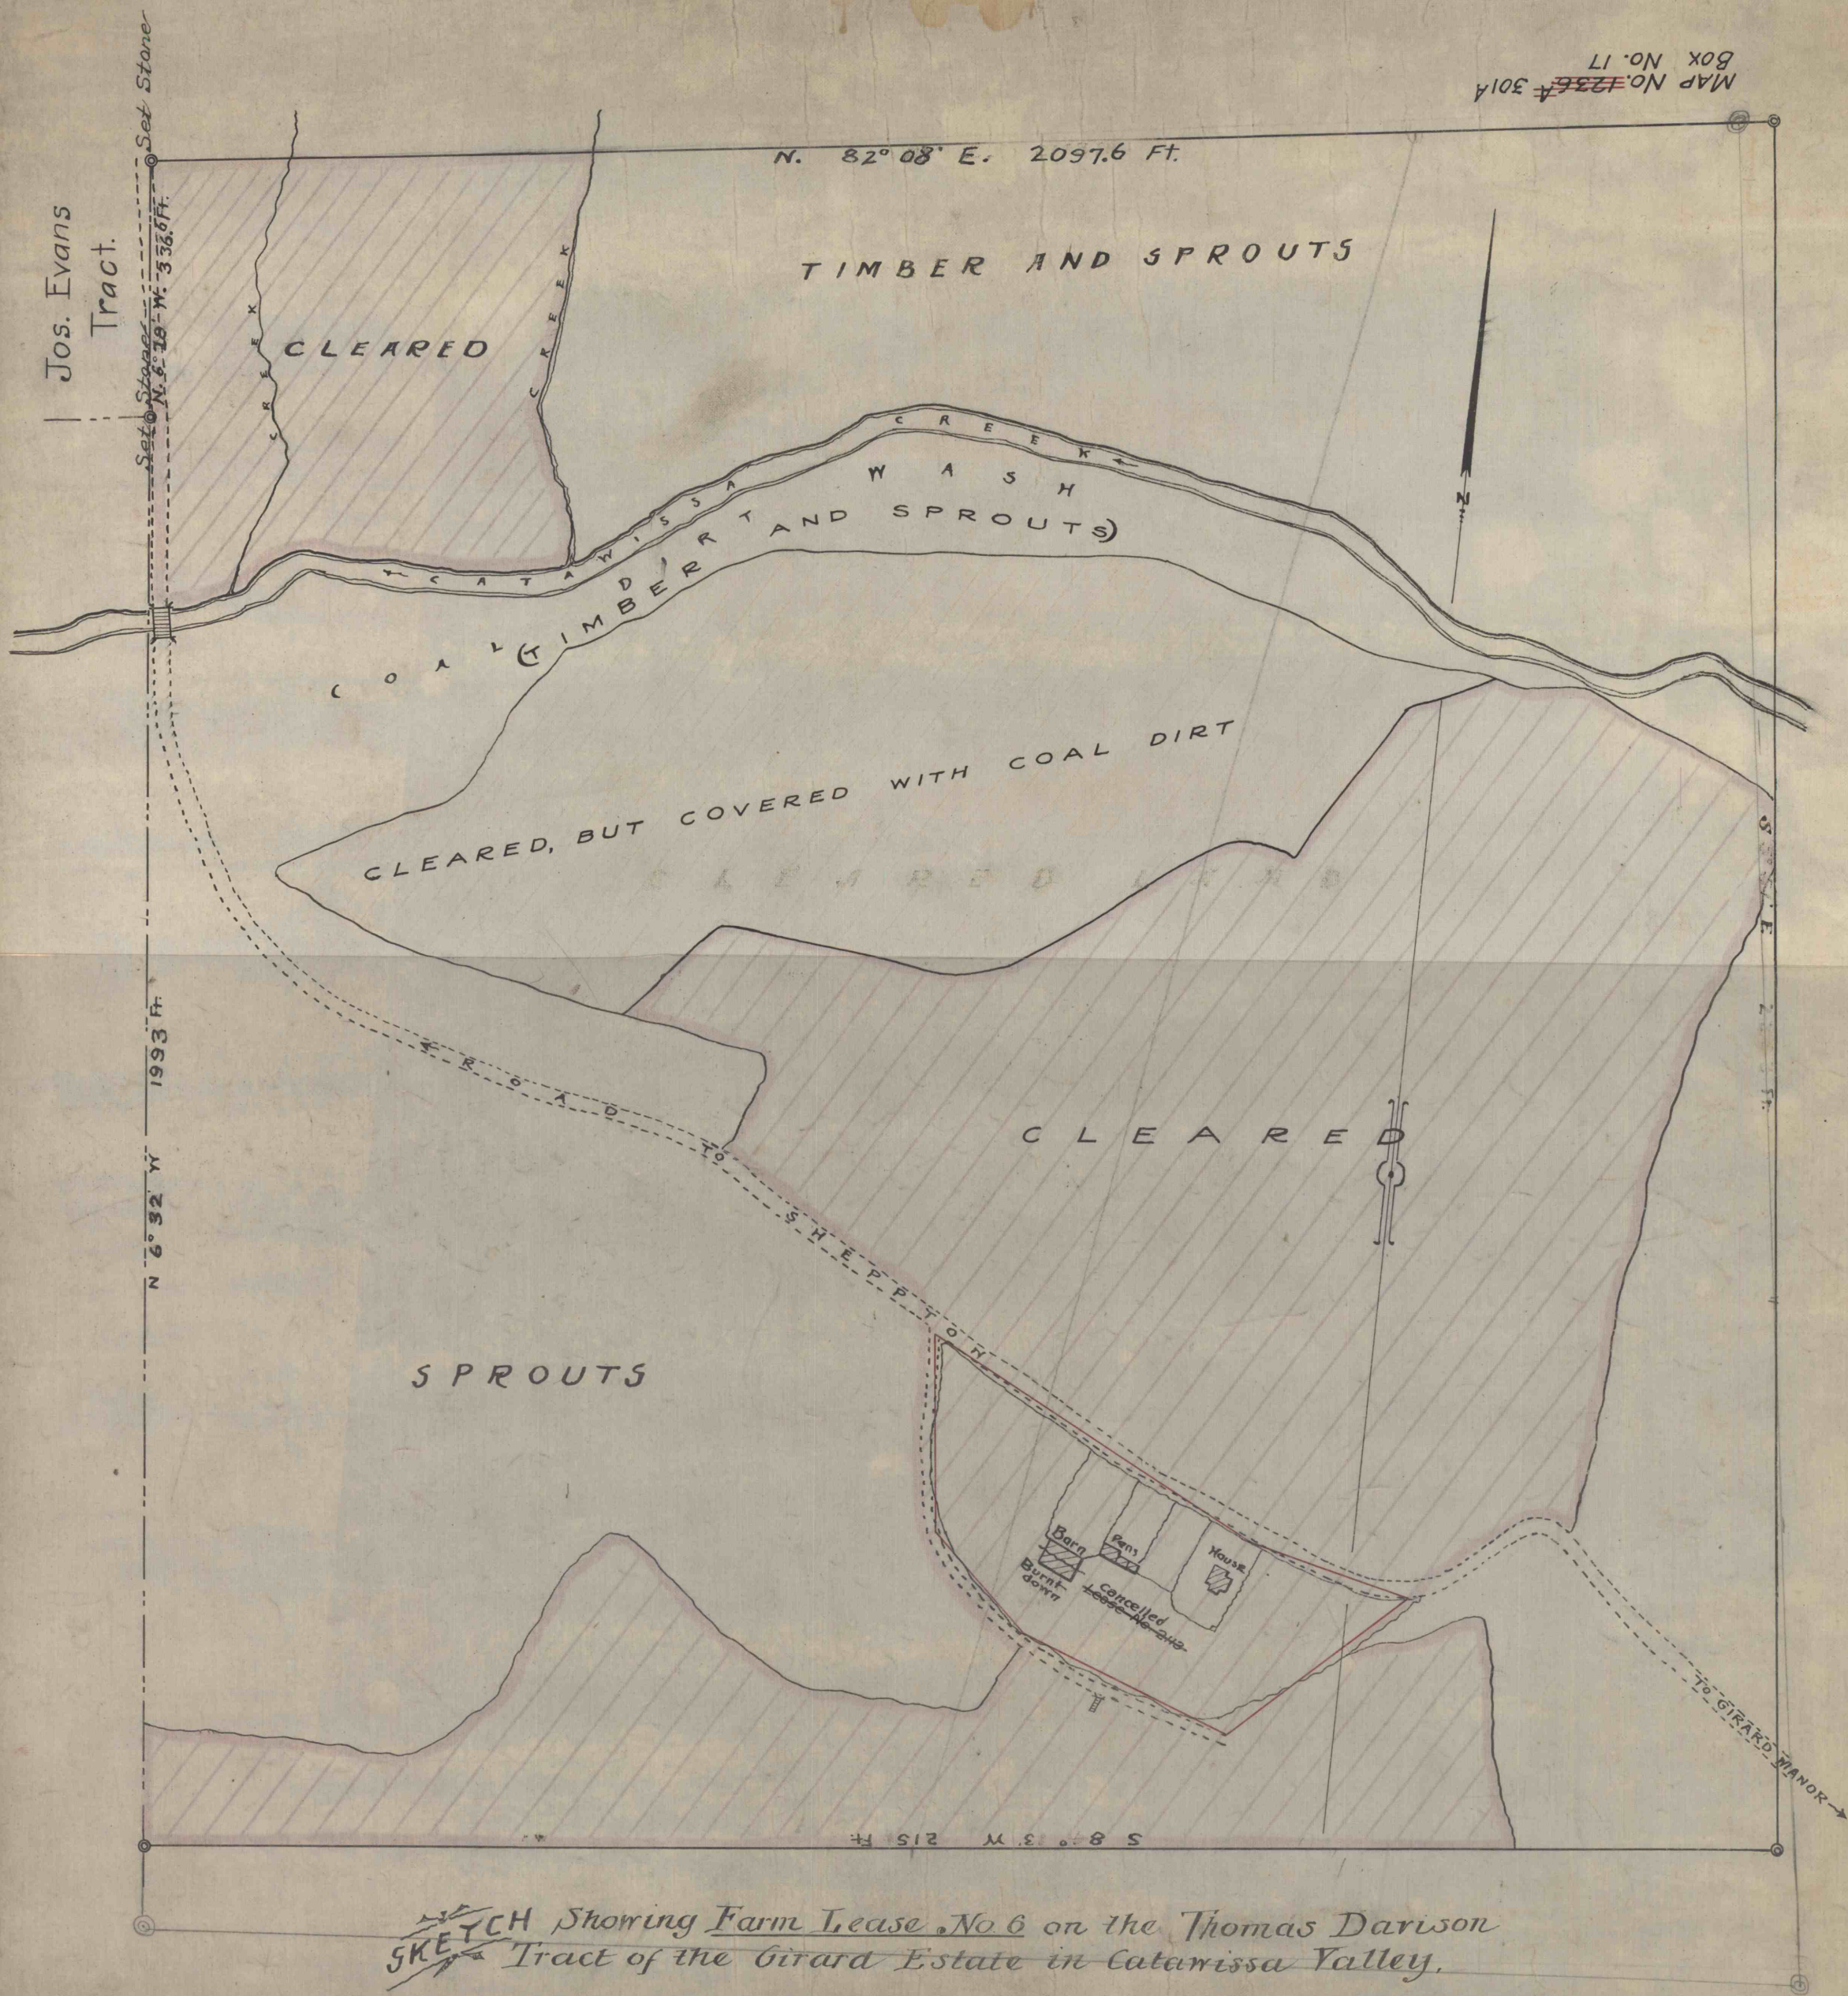

SKETCH Showing Farm Lease No. 6 on the Thomas Darison Tract of the Girard Estate in Catawissa Valley.

Land cleared and under cultivation	41 Acres.
Timber and sprouts	59 "
Land cleared, but covered with coal dirt	13 "

Total 113.00 Acres

Scale 1 in = 200ft - Pottsville, Apr. 29, 1902 - Heber S. Thompson

ENGINEER
GIRARD ESTATE

To accompany and to be made a part of Lease No. _____