


# JOSEPH HOWELL TRACT.

Scale 1 inch = 800 feet.

58.65 c + s.

10.35

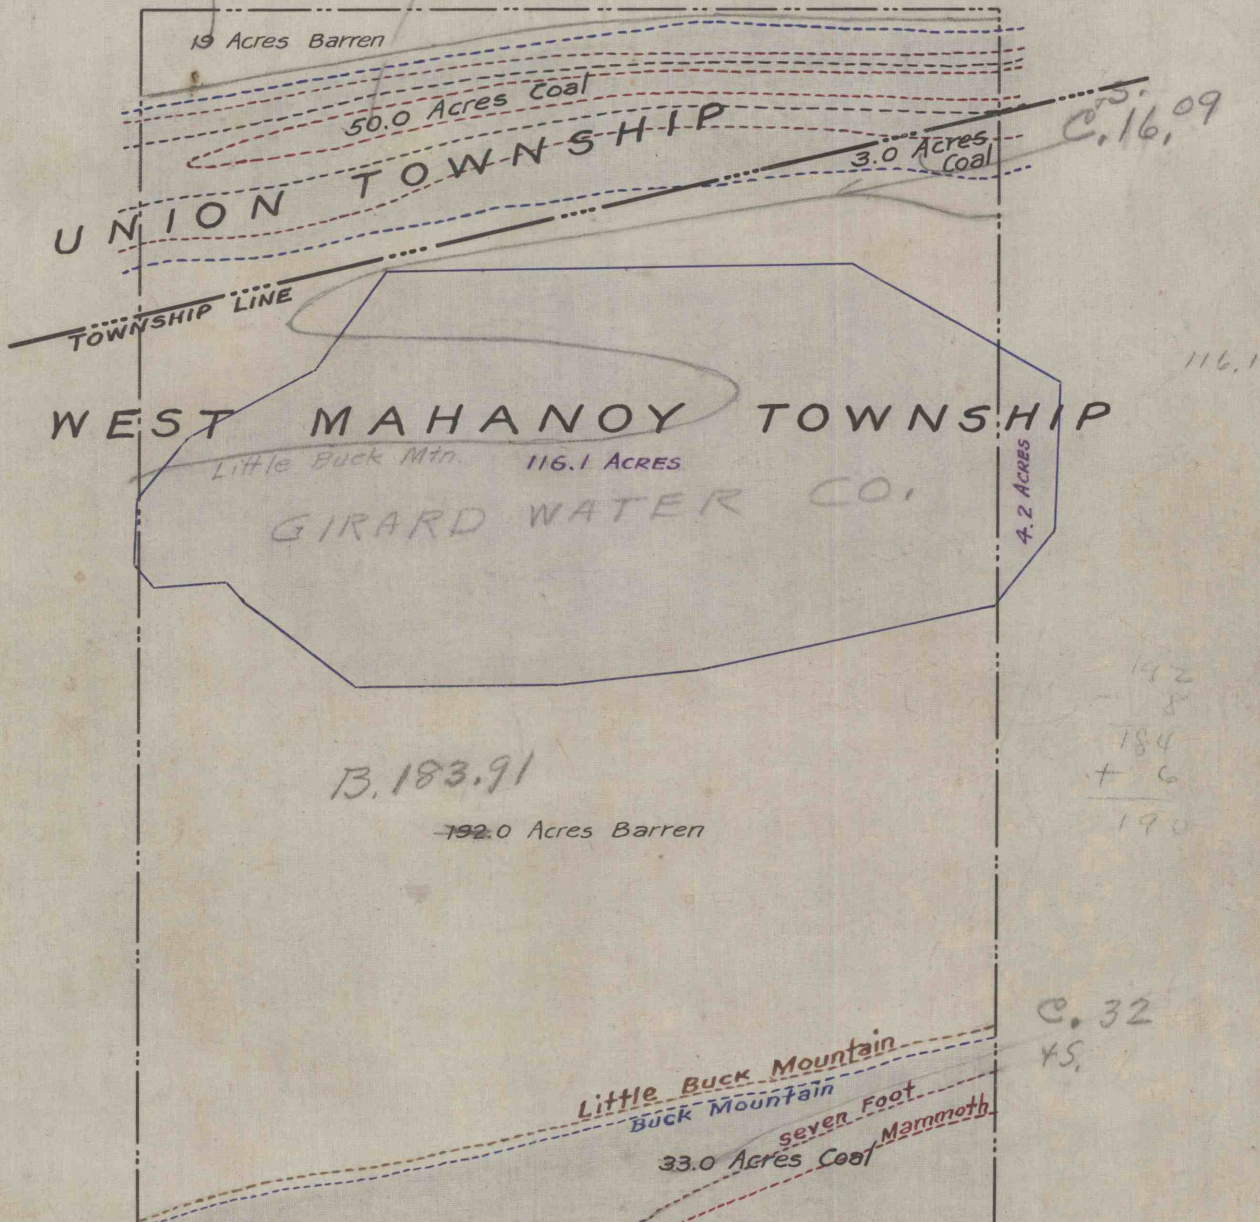

## WEST MAHANAOY TOWNSHIP.

Girard Water Co.

Girard Estate

Total

|            |              |             |
|------------|--------------|-------------|
| ----- Coal | 116.0 Barren | 116.0 Total |
| 36.0       | 192.0        | 228.0       |
| 48.09      | 183.91       | 232.0       |
| 36.0       | 308.0        | 344.0       |
| 48.09      | 299.91       | 348.0       |

## UNION TOWNSHIP.

Girard Water Co.

Girard Estate

Total

Total

|        |        |       |
|--------|--------|-------|
| -----  | 10.35  | ----- |
| 50.0   | 19.0   | 69.0  |
| 58.65  | 10.35  | 58.65 |
| 50.0   | 19.0   | 69.0  |
| 86.0   | 327.0  | 413.0 |
| 106.74 | 310.26 | 417.0 |