


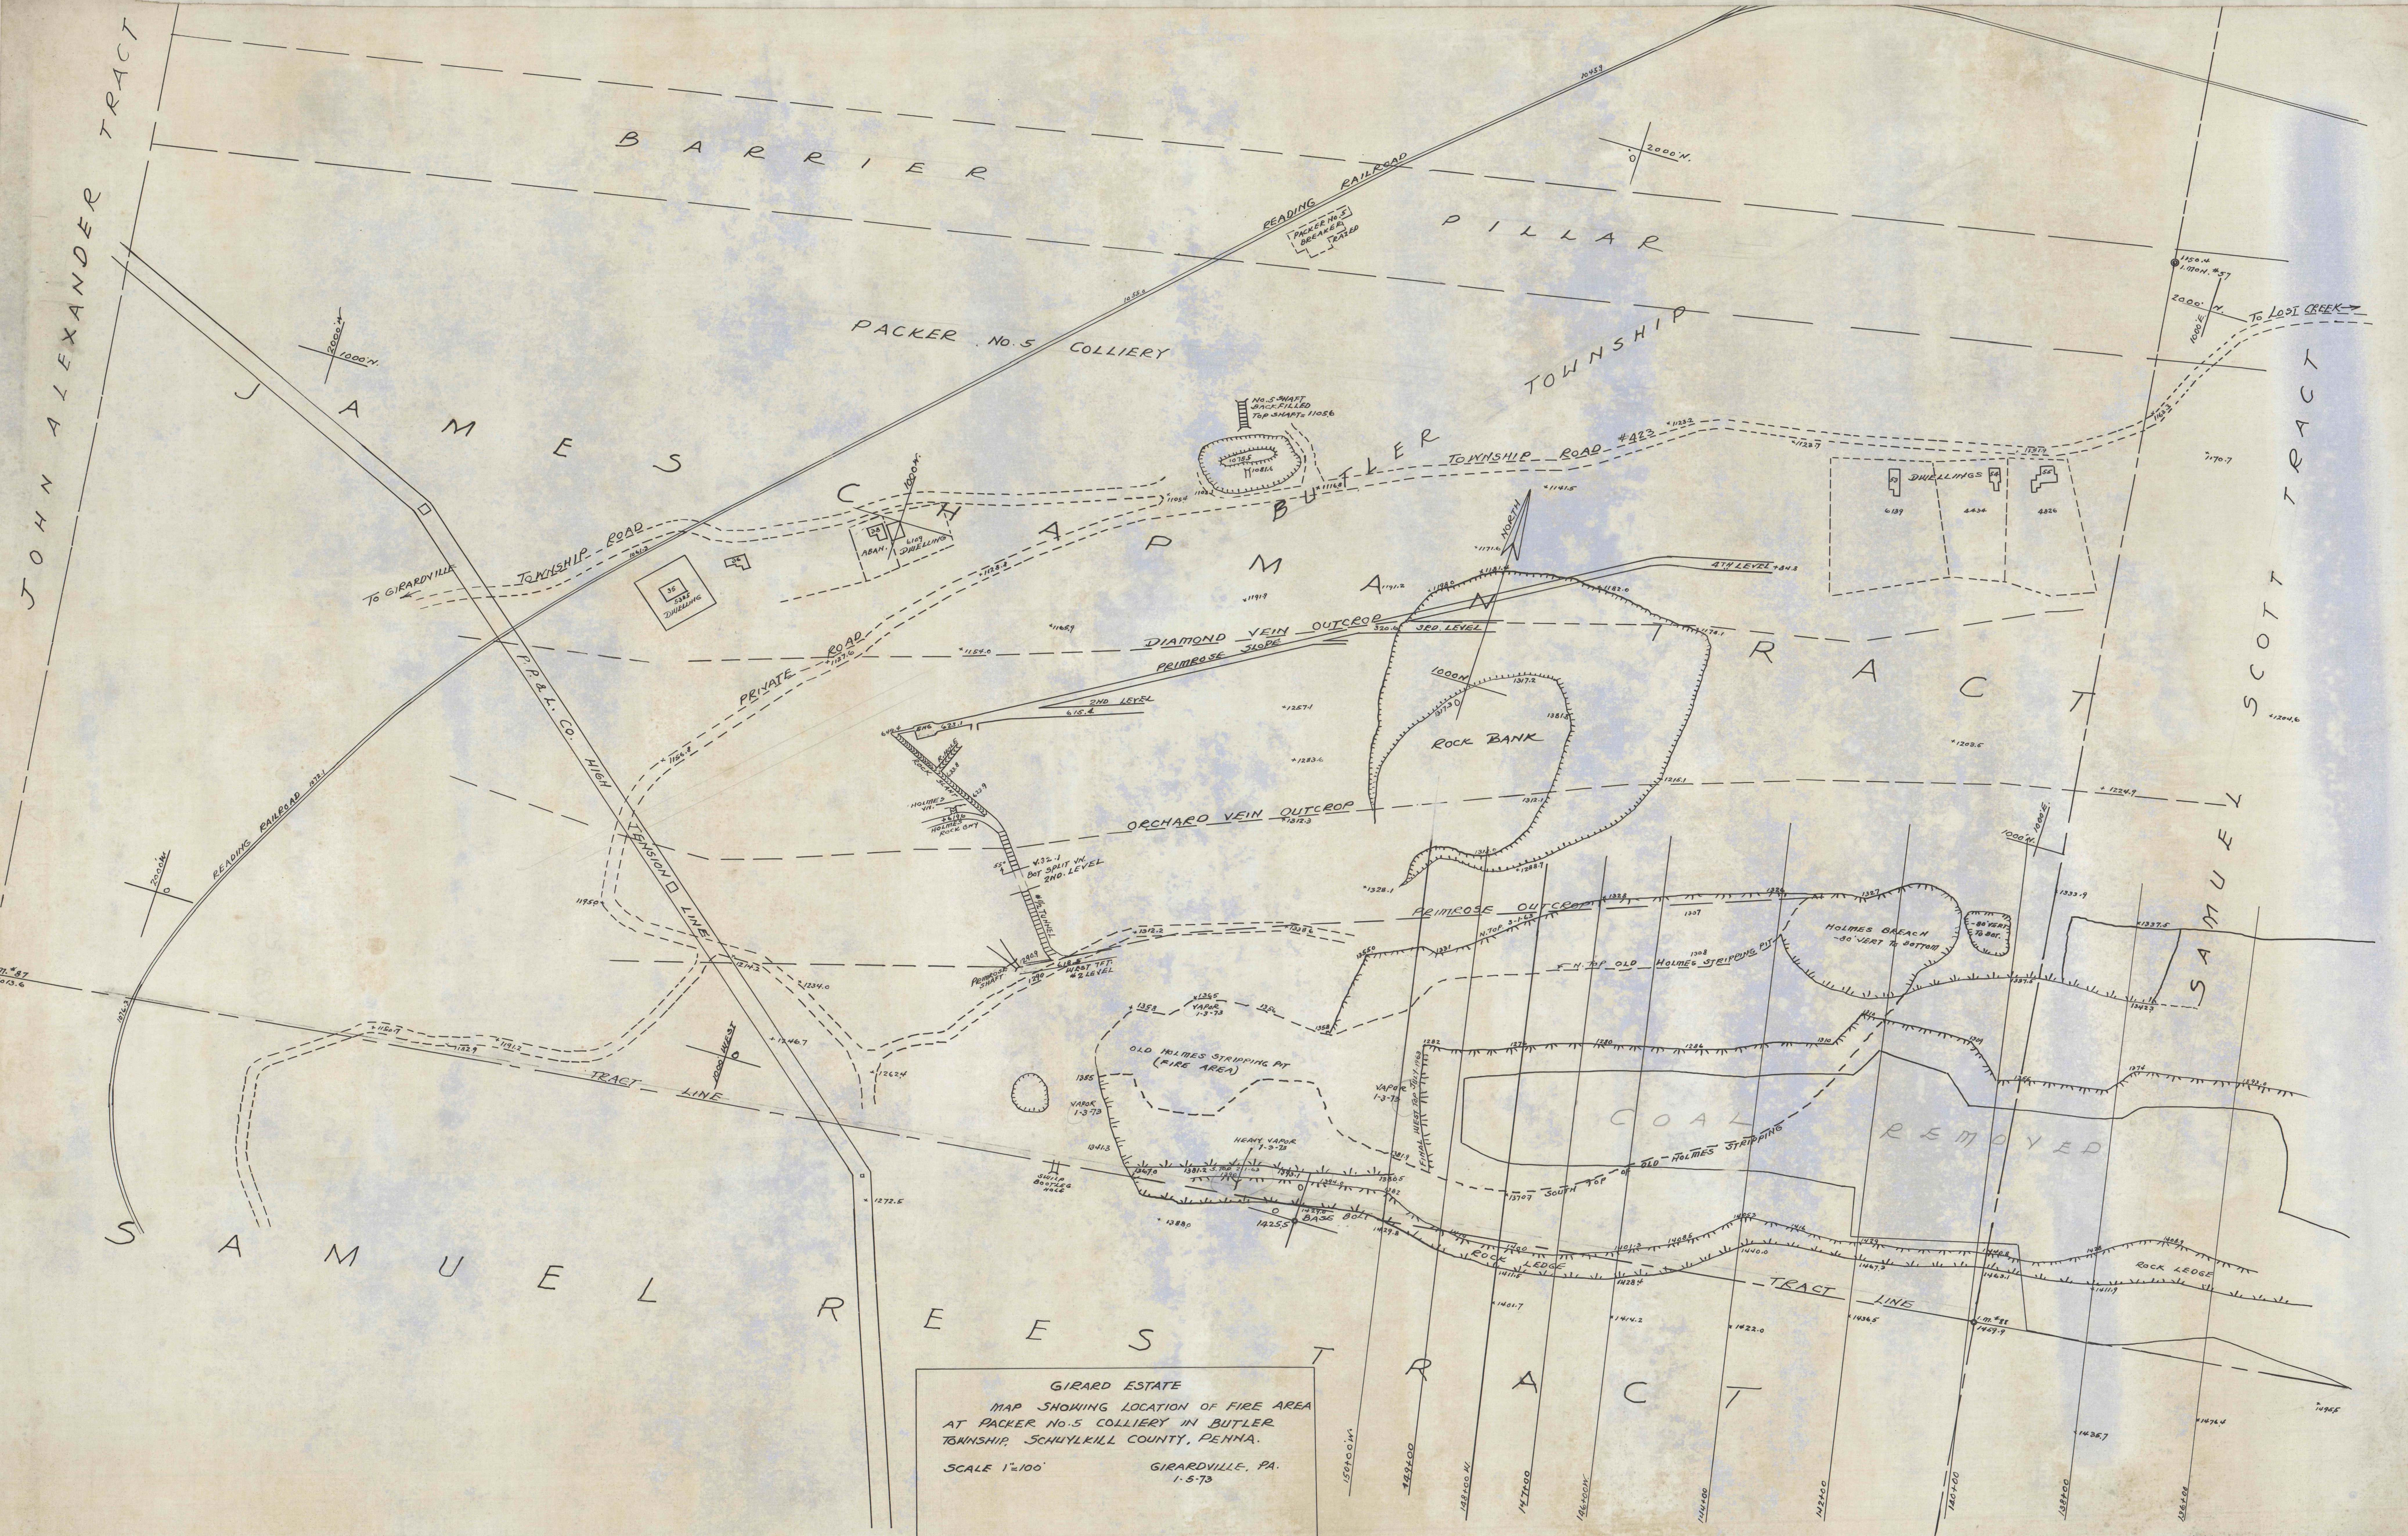

GIRARD ESTATE
MAP SHOWING LOCATION OF FIRE AREA
AT PACKER NO. 5 COLLIERY IN BUTLER
TOWNSHIP, SCHUYLKILL COUNTY, PENNA.
SCALE 1"=100' GIRARDVILLE, PA.
1-5-73