


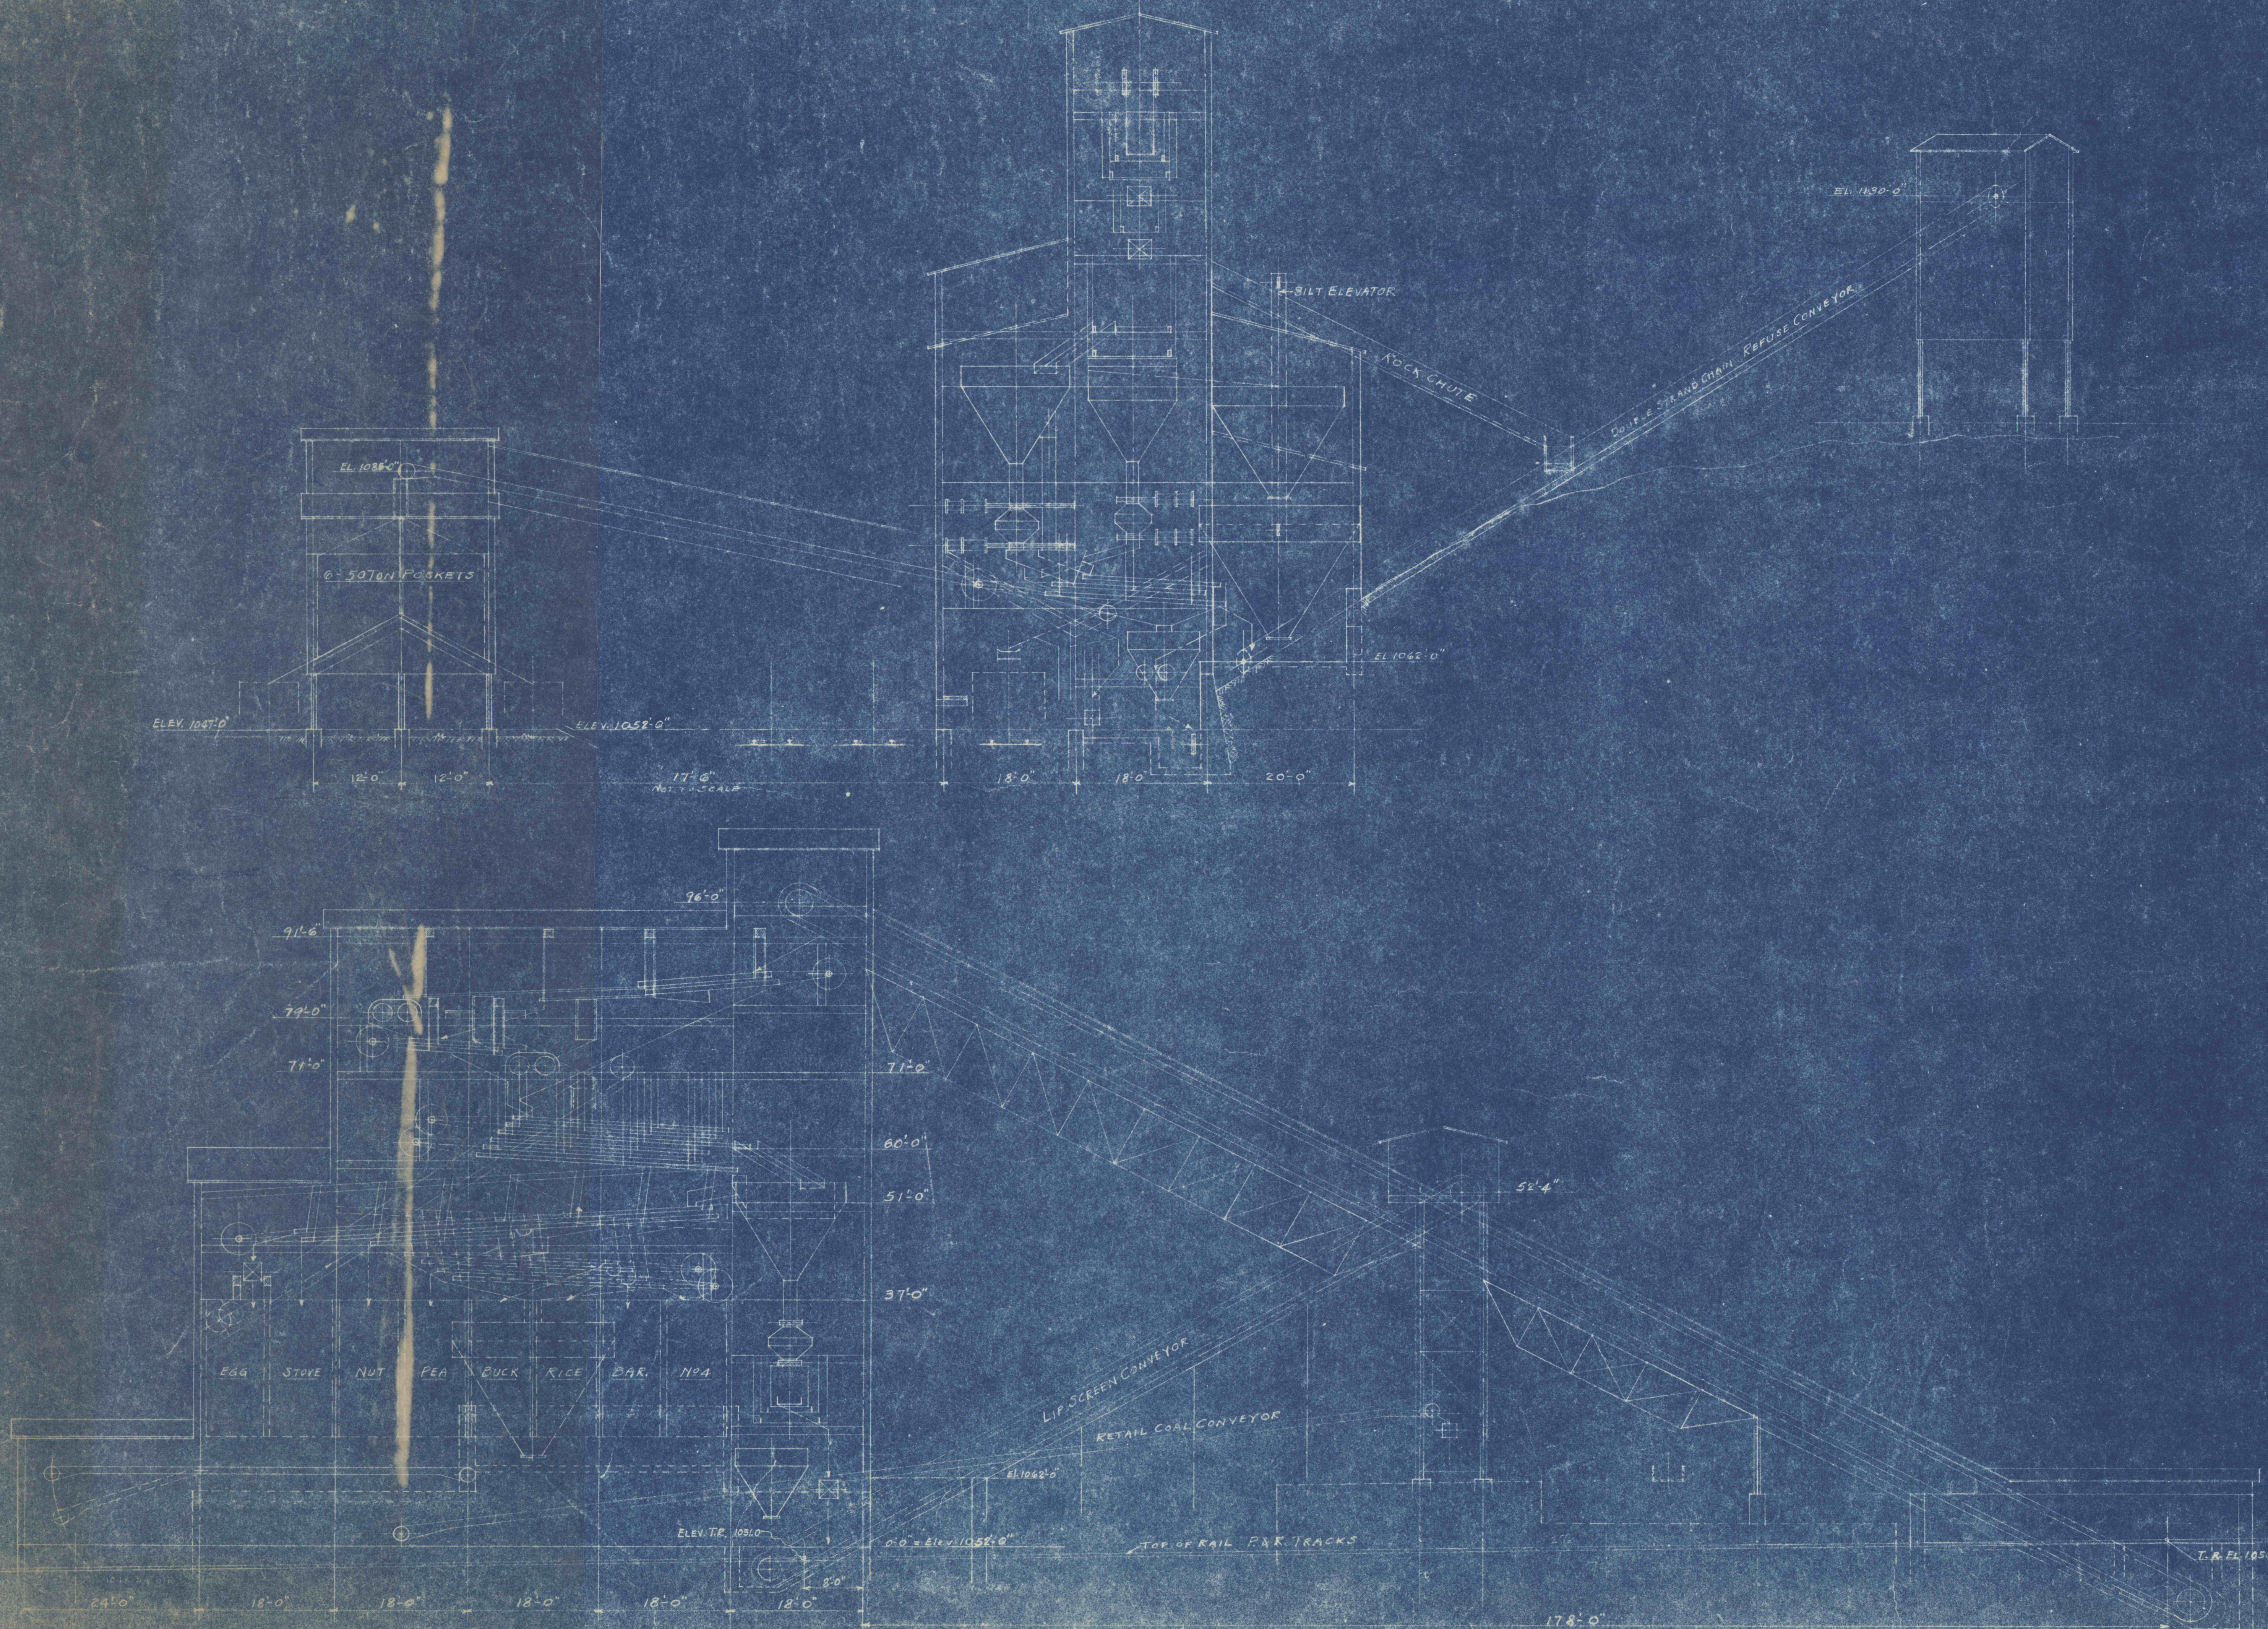

CHANCE COAL CLEANER
SCRANTON PA.
CHANCE BREAKER AT PACKER Nº 5

EAST BEAR RIDGE COLLIERY CO.
DATE: 6-6-41 SCALE: 1/2" = 1'-0"
DRAWN: M.W. TRACED: CHECKED:
REVISIONS
Higher Elevations
1964 Elevations

DRAWING NO.
S-3599