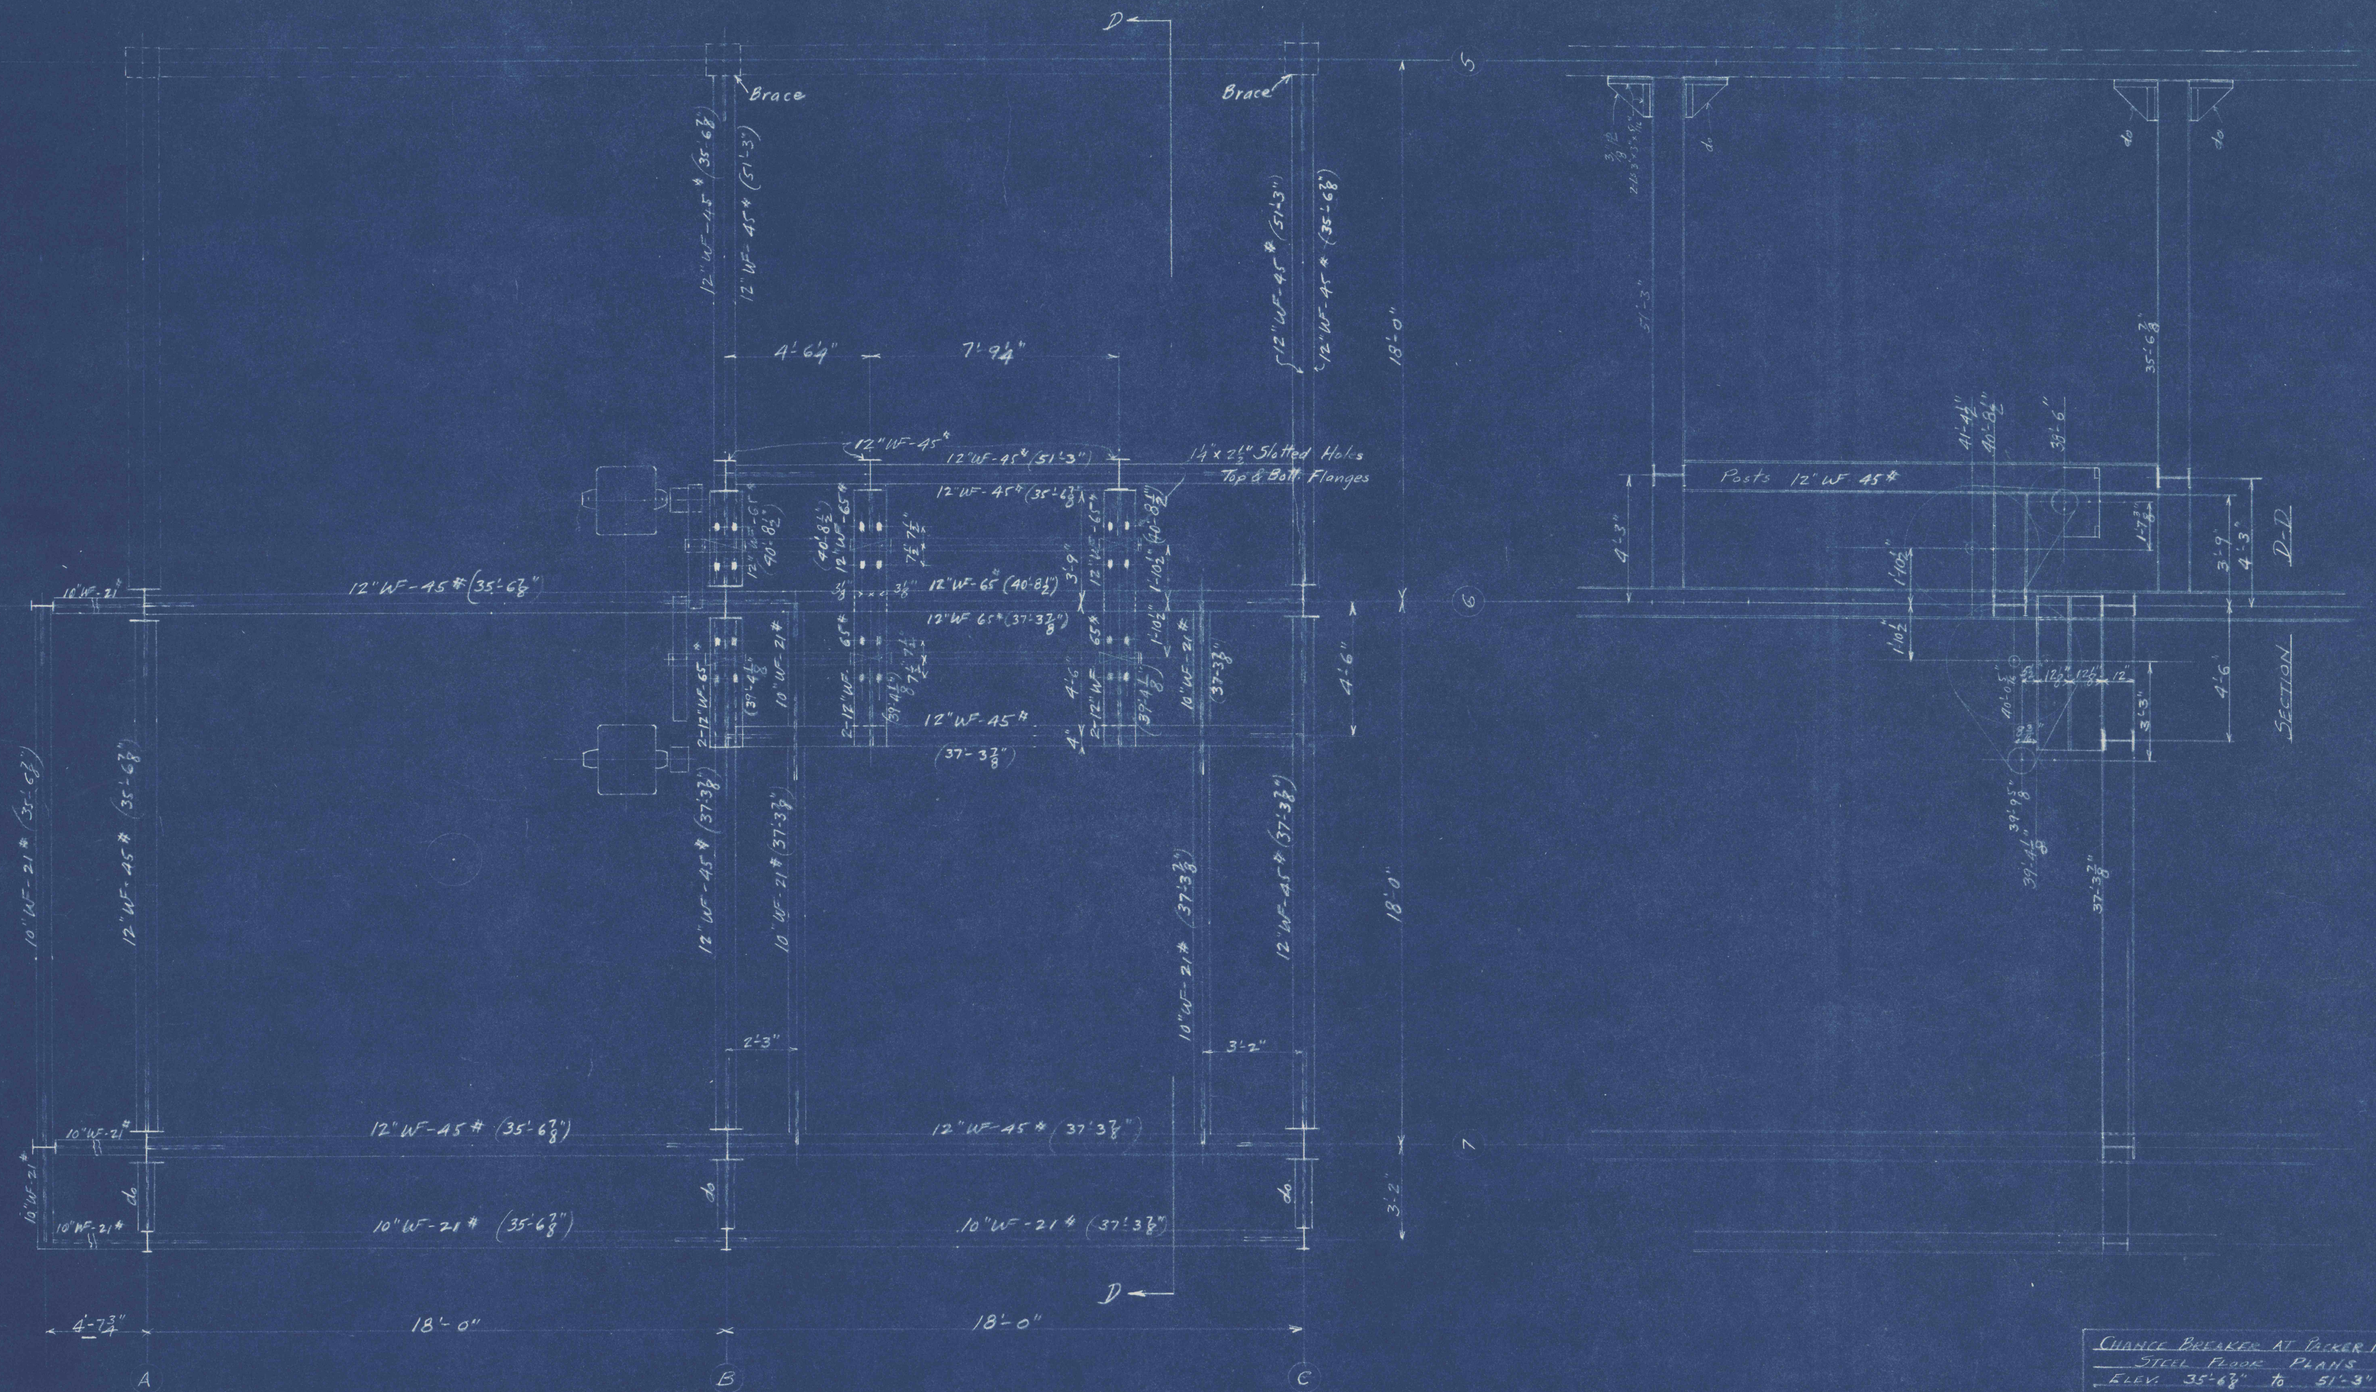


FINE COAL SHAKER DRIVE - ELEV. 35'-6⅞" TO 51'-3"

CHANCE BREAKER AT PACKER No. 5
STEEL FLOOR PLANS
ELEV. 35'-6⅞" to 51'-3"
BENTS 5-6 & 7
EAST BEAR RIDGE COLLIERY Co.

| | |
|---|---|
| DATE: APR. 7, 1947 | SCALE: ⅜" = 1 ft. |
| DRAWN: | CHECKED: |
| REVISIONS: Changed Elev. of Shaker Drive Stops and Beams. 4/27/47 | DRAWING No. E. S. 5222 |