


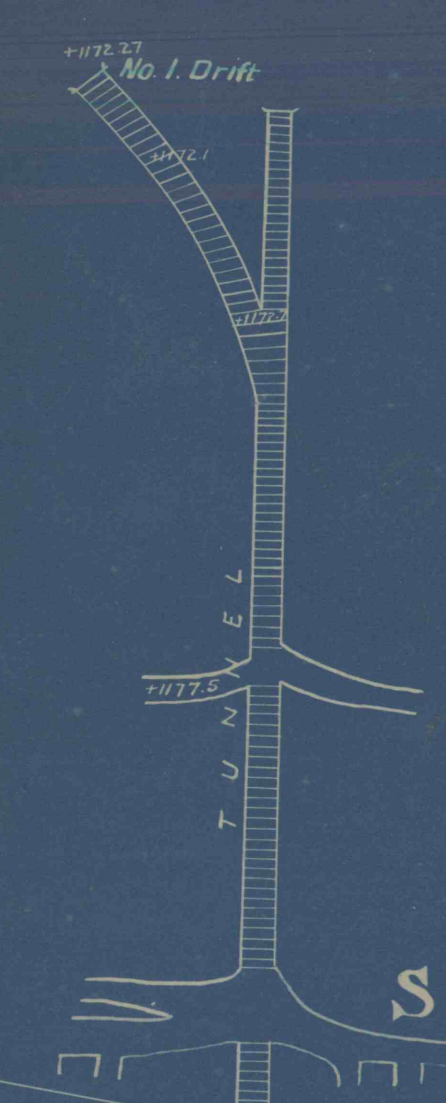

PACKER COLLIERY NO.1.

SAMUEL

SCOTT

TRACT

JOHN BRADY TRACT



THOMAS GRANT TRACT

WM. P. BRADY TRACT

EAST BEAR RIDGE COLLIERY

PILLAR IN SEVEN FOOT BED
BETWEEN
PACKER No 1 AND EAST BEAR RIDGE COLLIERIES
Scale 1 inch = 100 feet
Pottsville, Penna.
May 6, 1912
James Archbold, Jr.
ENGINEER GIRARD ESTATE

