


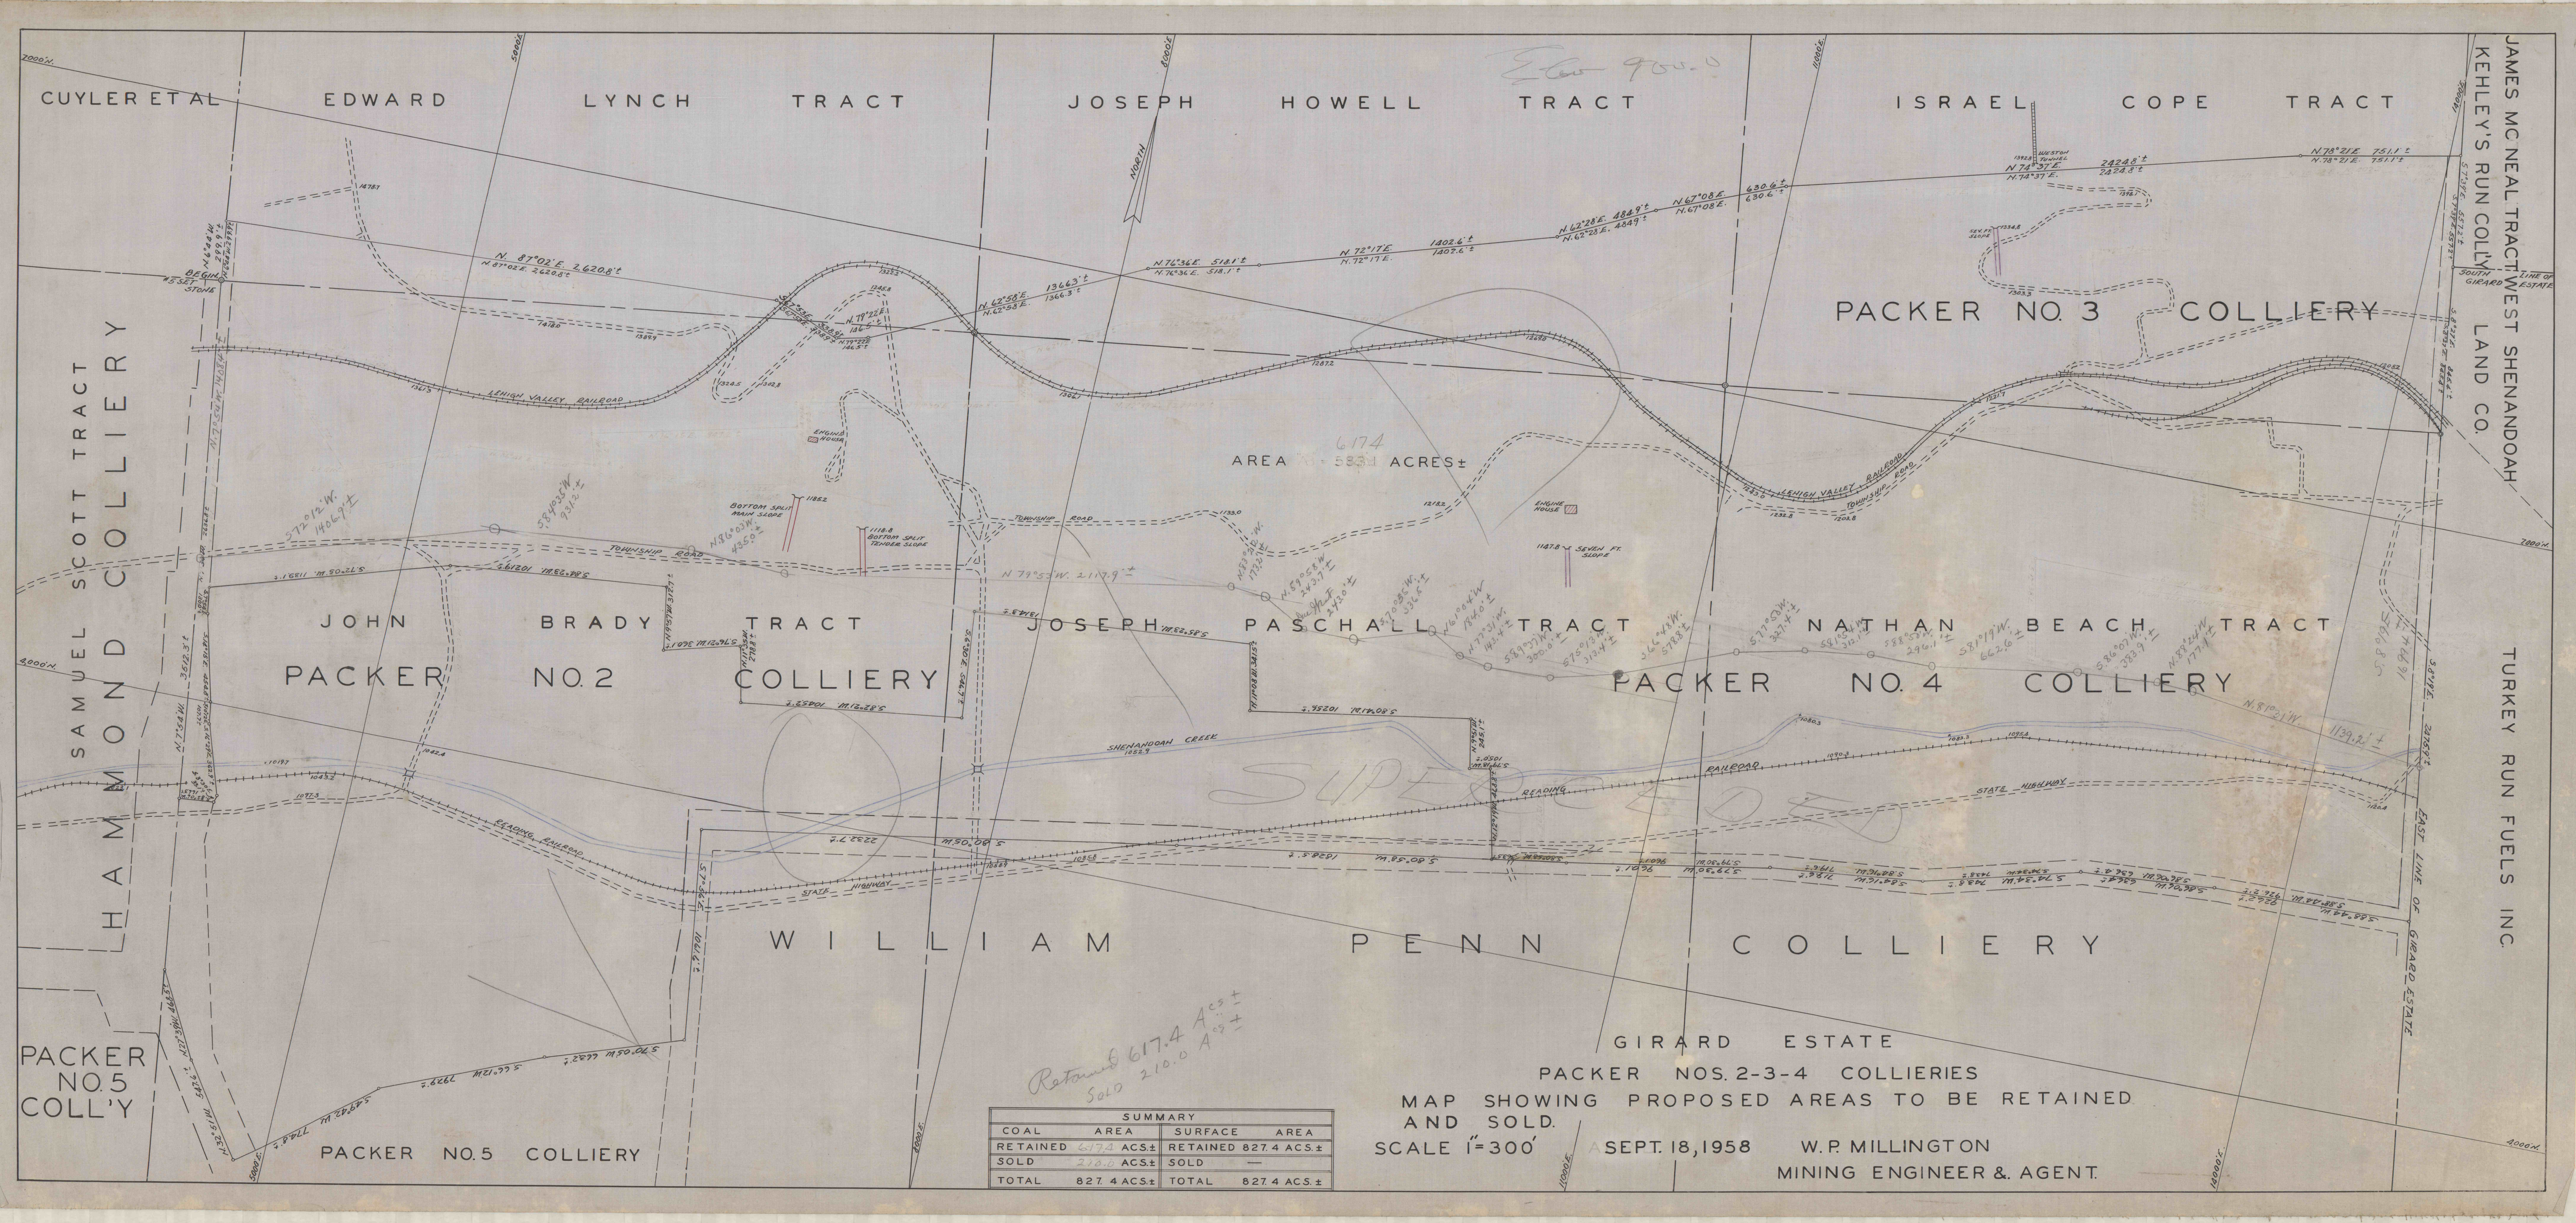

SUMMARY			
COAL	AREA	SURFACE	AREA
RETAINED	617.4 ACS±	RETAINED	827.4 ACS±
SOLD	210.0 ACS±	SOLD	—
TOTAL	827.4 ACS±	TOTAL	827.4 ACS±

MAP SHOWING PROPOSED AREAS TO BE RETAINED
AND SOLD.
SCALE 1"=300'

GIRARD ESTATE

PACKER NOS. 2-3-4 COLLIERIES

SEPT. 18, 1958

W.P. MILLINGTON
MINING ENGINEER & AGENT.