


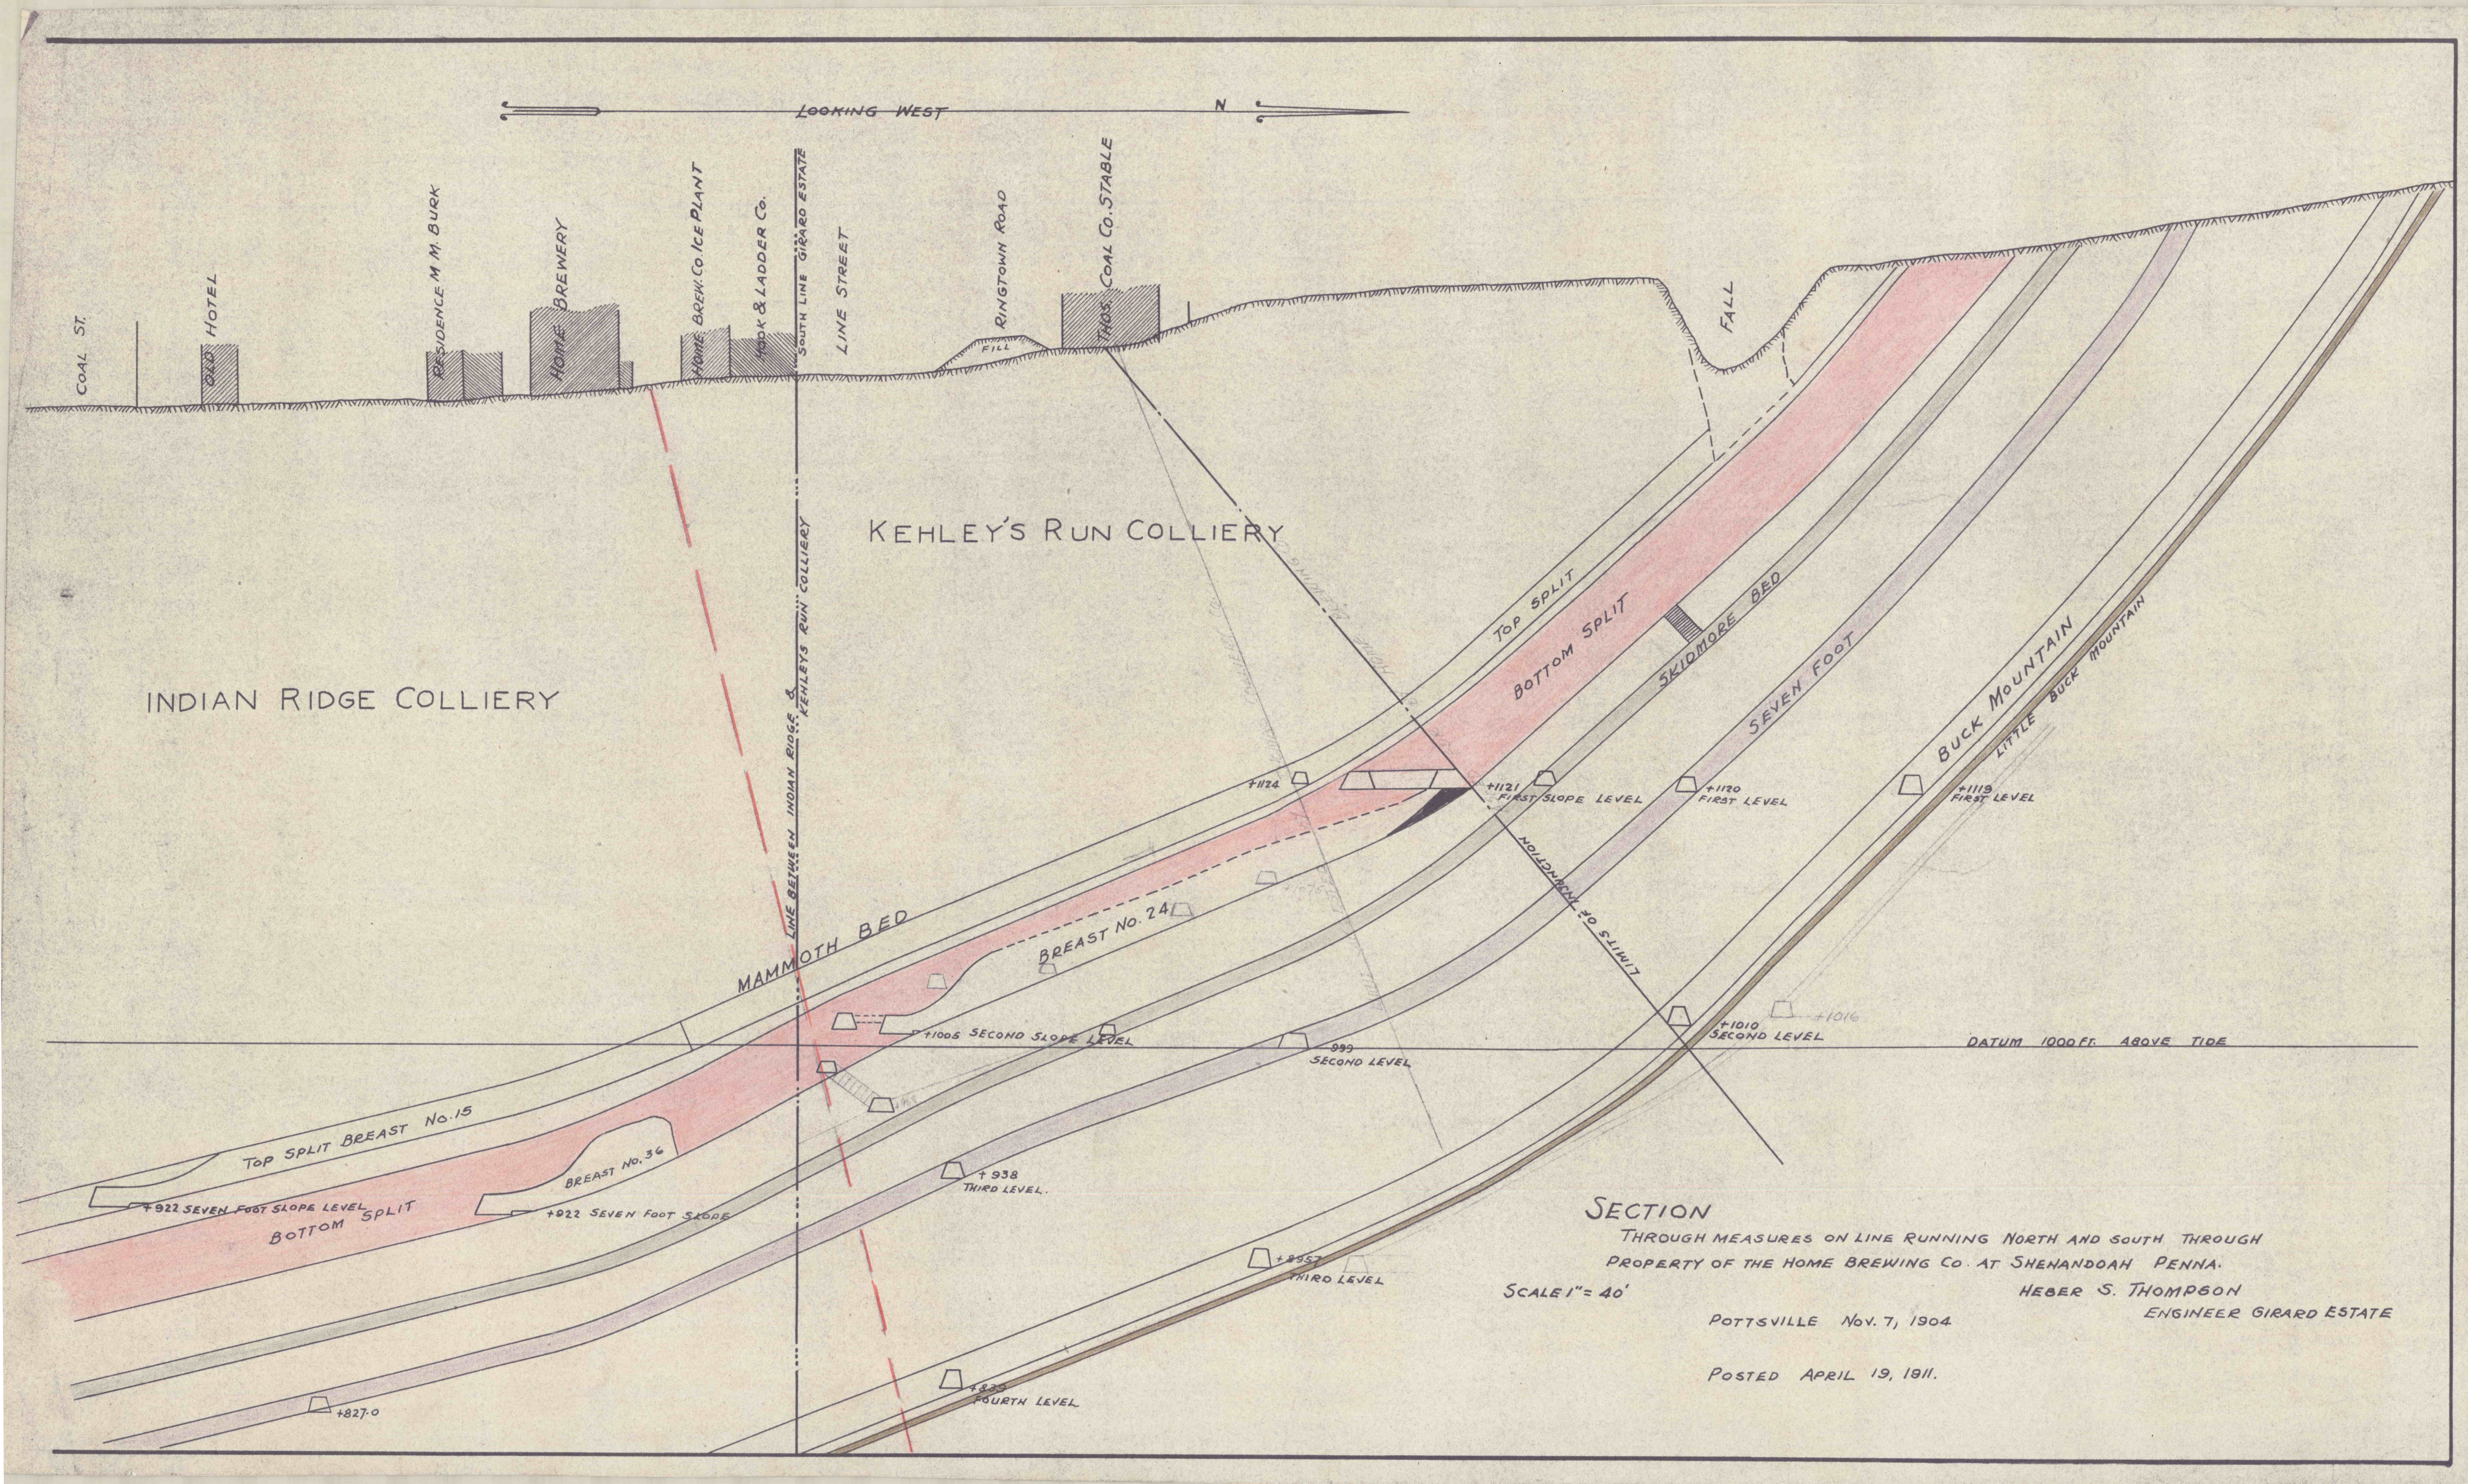

LOOKING WEST

N

COAL ST.

HOTEL

RESIDENCE M. M. BURK

HOME BREWERY

HOME BREW CO. ICE PLANT

HOOKE & LADDER CO.

SOUTH LINE GIRARD ESTATE

LINE STREET

RINGTON ROAD

THOS. COAL CO. STABLE

FALL

INDIAN RIDGE COLLIERY

KEHLEY'S RUN COLLIERY

MAMMOTH BED

BREAST NO. 24

TOP SPLIT

BOTTOM SPLIT

SKIDMORE BED

SEVEN FOOT

BUCK MOUNTAIN

LITTLE BUCK MOUNTAIN

+1124

+1121 FIRST SLOPE LEVEL

+1120 FIRST LEVEL

+1119 FIRST LEVEL

+1005 SECOND SLOPE LEVEL

999 SECOND LEVEL

+1010 SECOND LEVEL

DATUM 1000 FT. ABOVE TIDE

TOP SPLIT BREAST NO. 15

BREAST NO. 36

+922 SEVEN FOOT SLOPE LEVEL

BOTTOM SPLIT

+922 SEVEN FOOT SLOPE

+938 THIRD LEVEL

+8957 THIRD LEVEL

+8235 FOURTH LEVEL

+827.0

SECTION

THROUGH MEASURES ON LINE RUNNING NORTH AND SOUTH THROUGH PROPERTY OF THE HOME BREWING CO. AT SHENANDOAH PENNA.

SCALE 1" = 40'

HEBER S. THOMPSON

ENGINEER GIRARD ESTATE

POTTSVILLE NOV. 7, 1904

POSTED APRIL 19, 1911.