

SKETCH
SHOWING

Part of the John Lockhart tract, North of the Catawissa Division
of the Philadelphia and Reading Rail Road enclosed by fence.

Also piece of ground claimed by Michael O'Hara.

Lines tinted red show fence erected and possession held from Sept. 1892 --
Lines tinted yellow show Butler, Brandon, Torbert claim.


Scale 1 in = 300 ft

Heber S. Thompson

ENGINEER GIRARD ESTATE.

Pottsville, Pa. Oct. 9, 1901.

NOTE
City of Philadelphia has been in full possession since Sept 1892 of all of the John Lockhart
tract except pieces crosslined in red

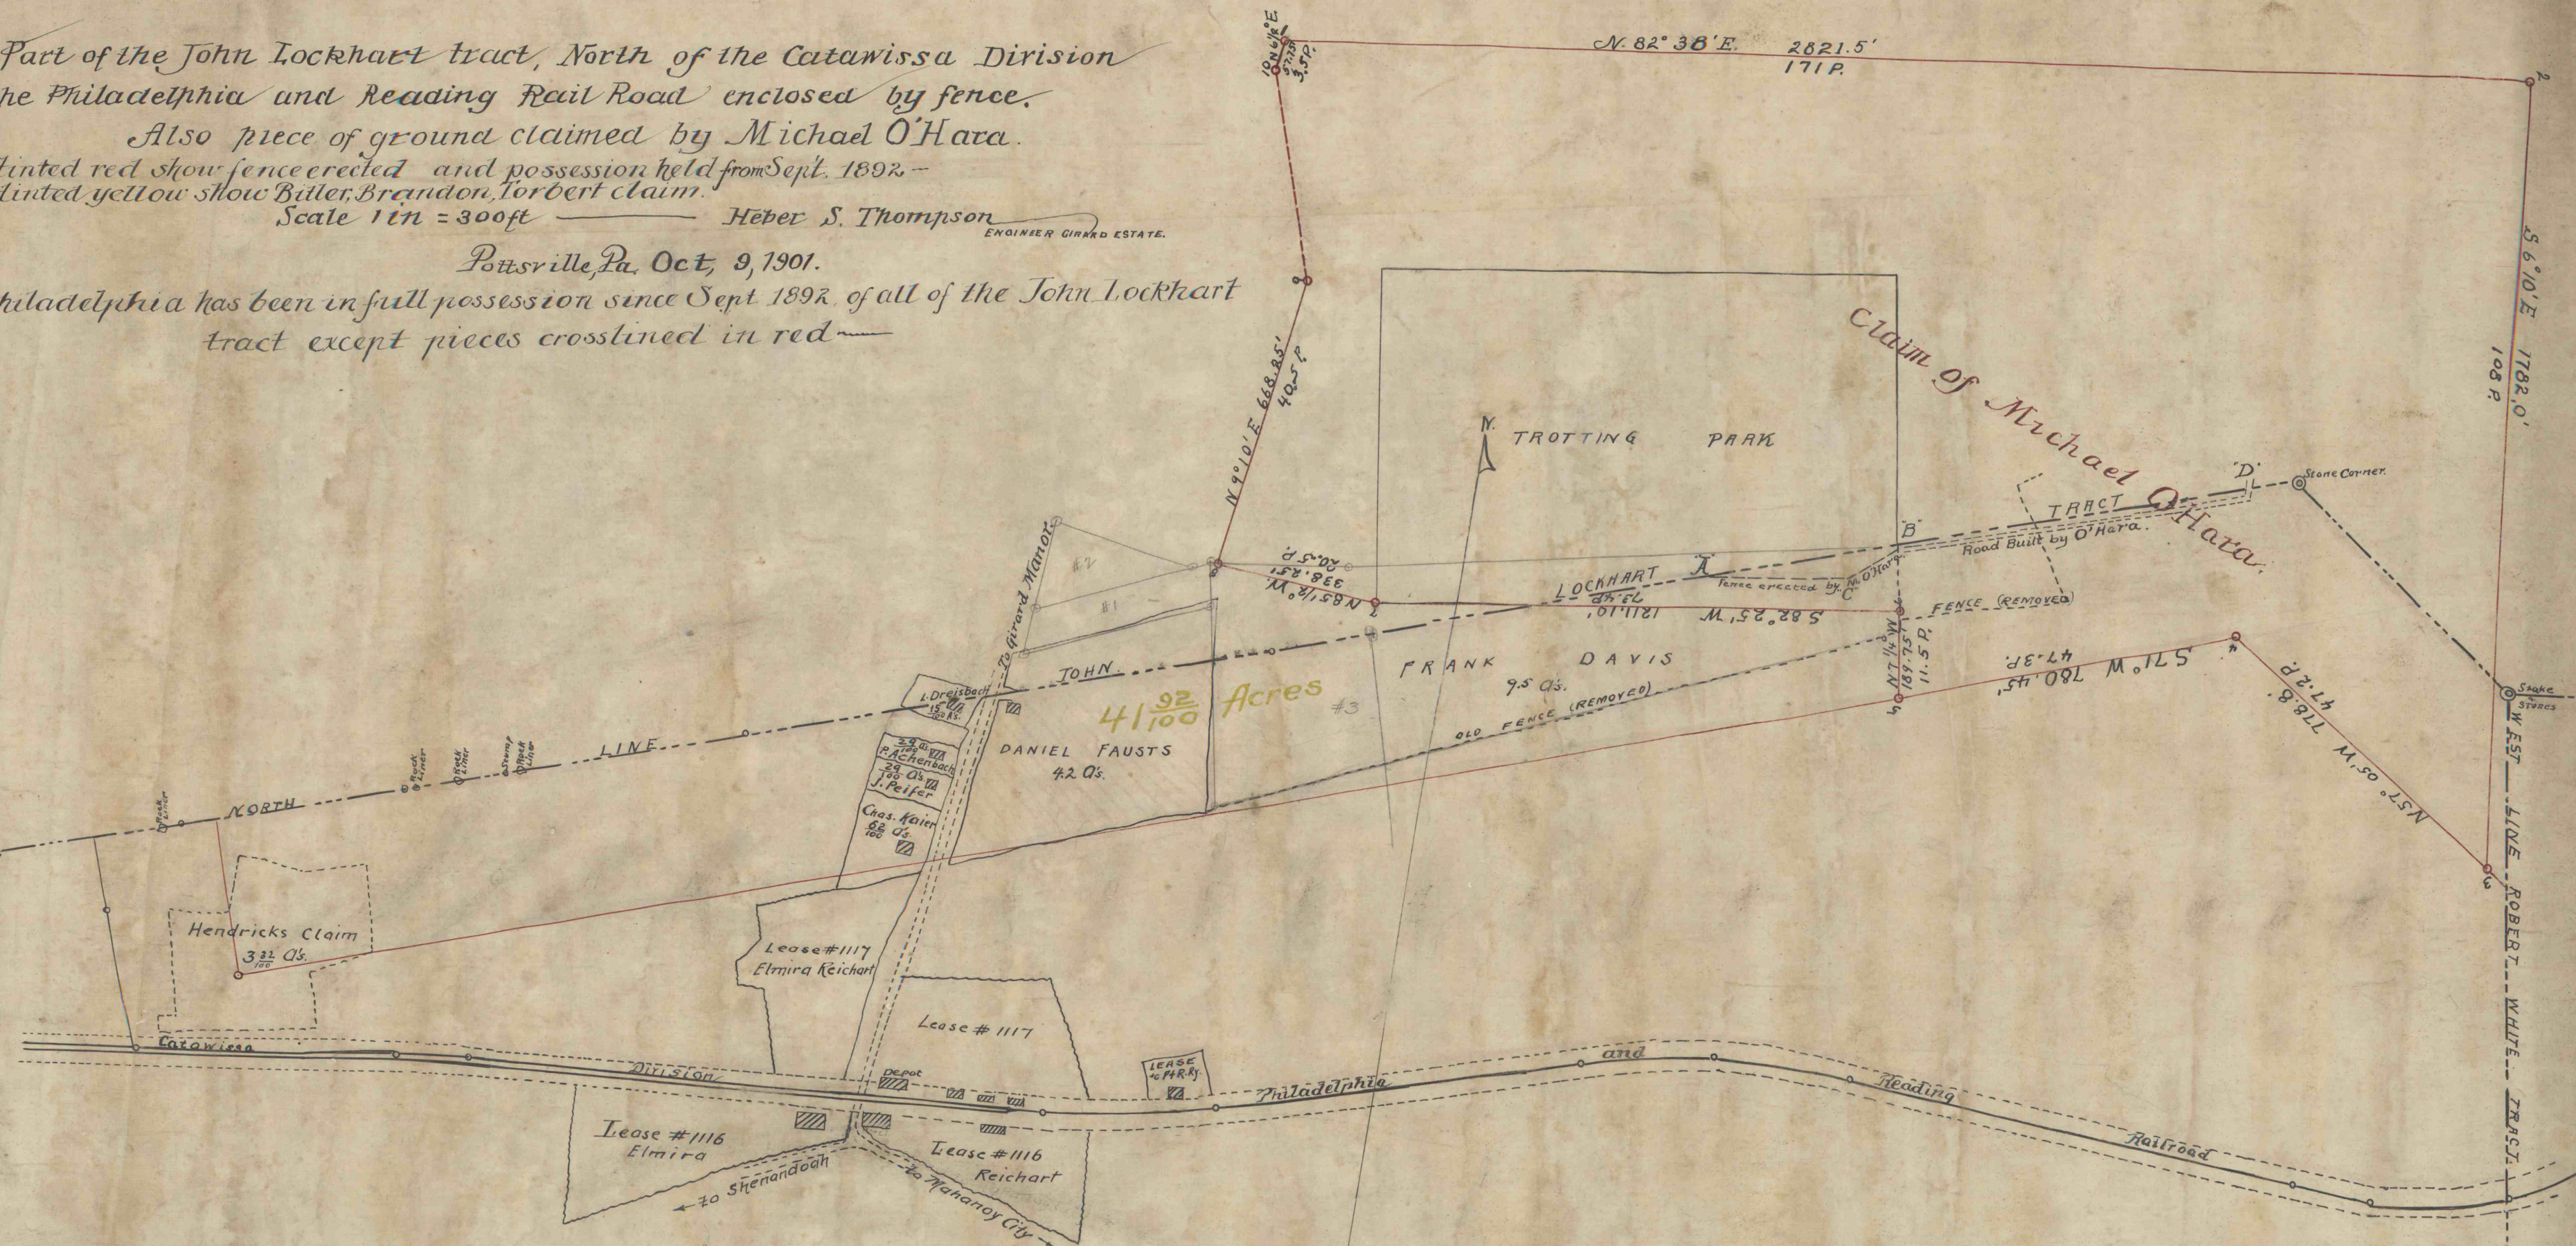

John Lockhart Tract

John Lockhart Tract