HOLMES AND FOUR FOOT BEDS
WORKINGS ON THE GIRARD ESTATE
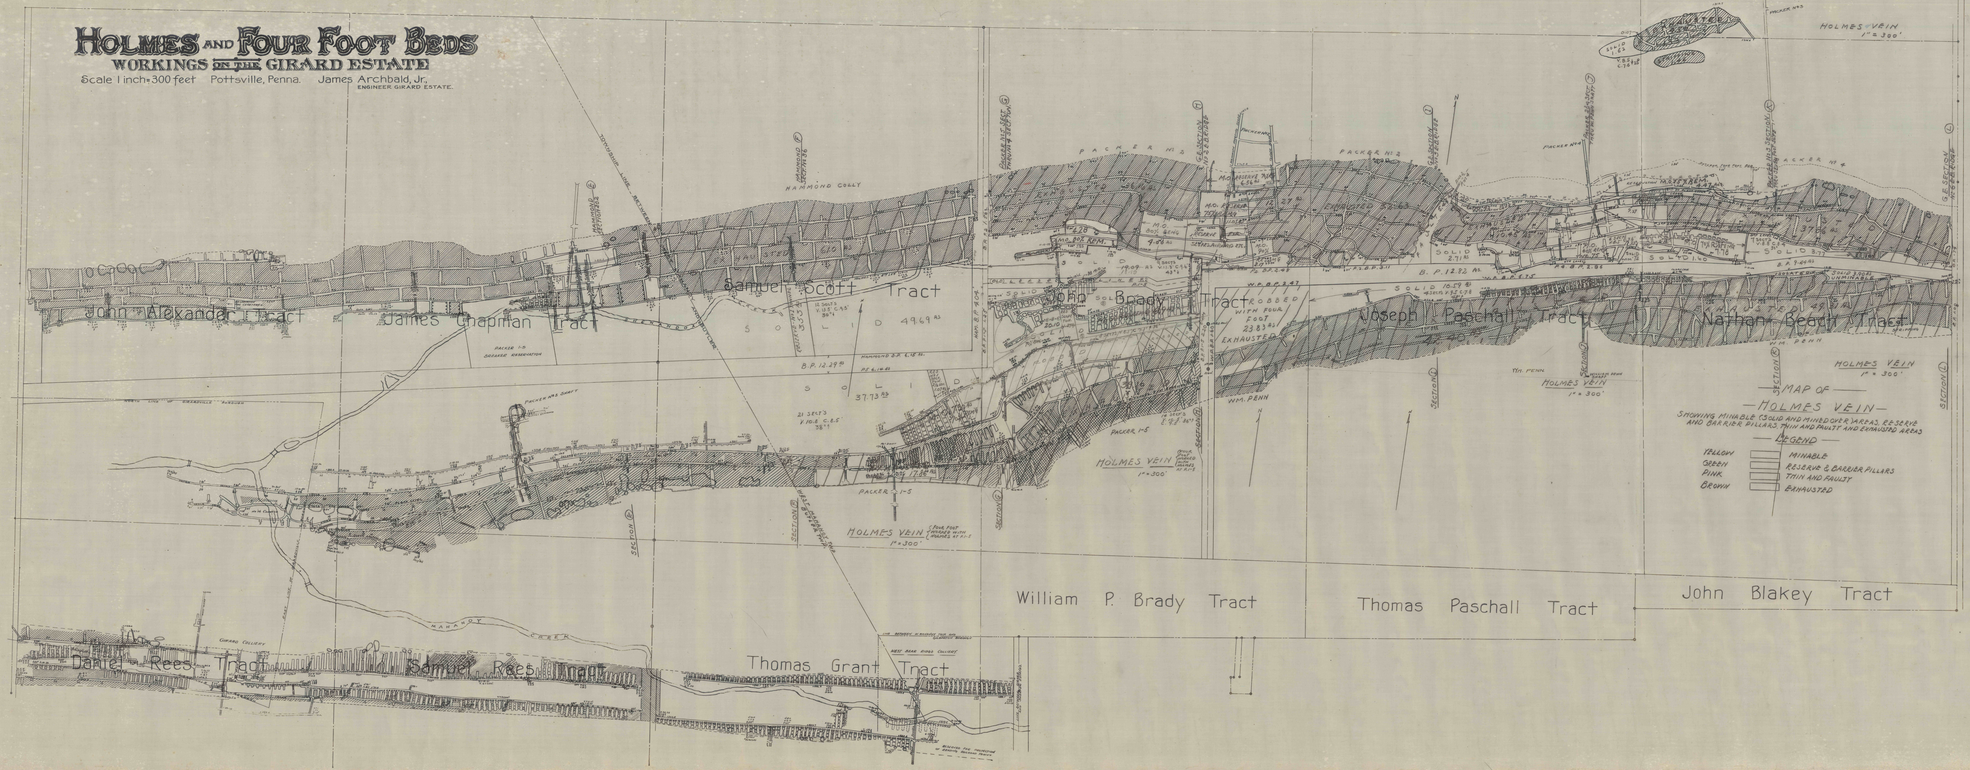
Scale 1 inch = 300 feet Pottsville, Penna. James Archbald, Jr. ENGINEER GIRARD ESTATE.