


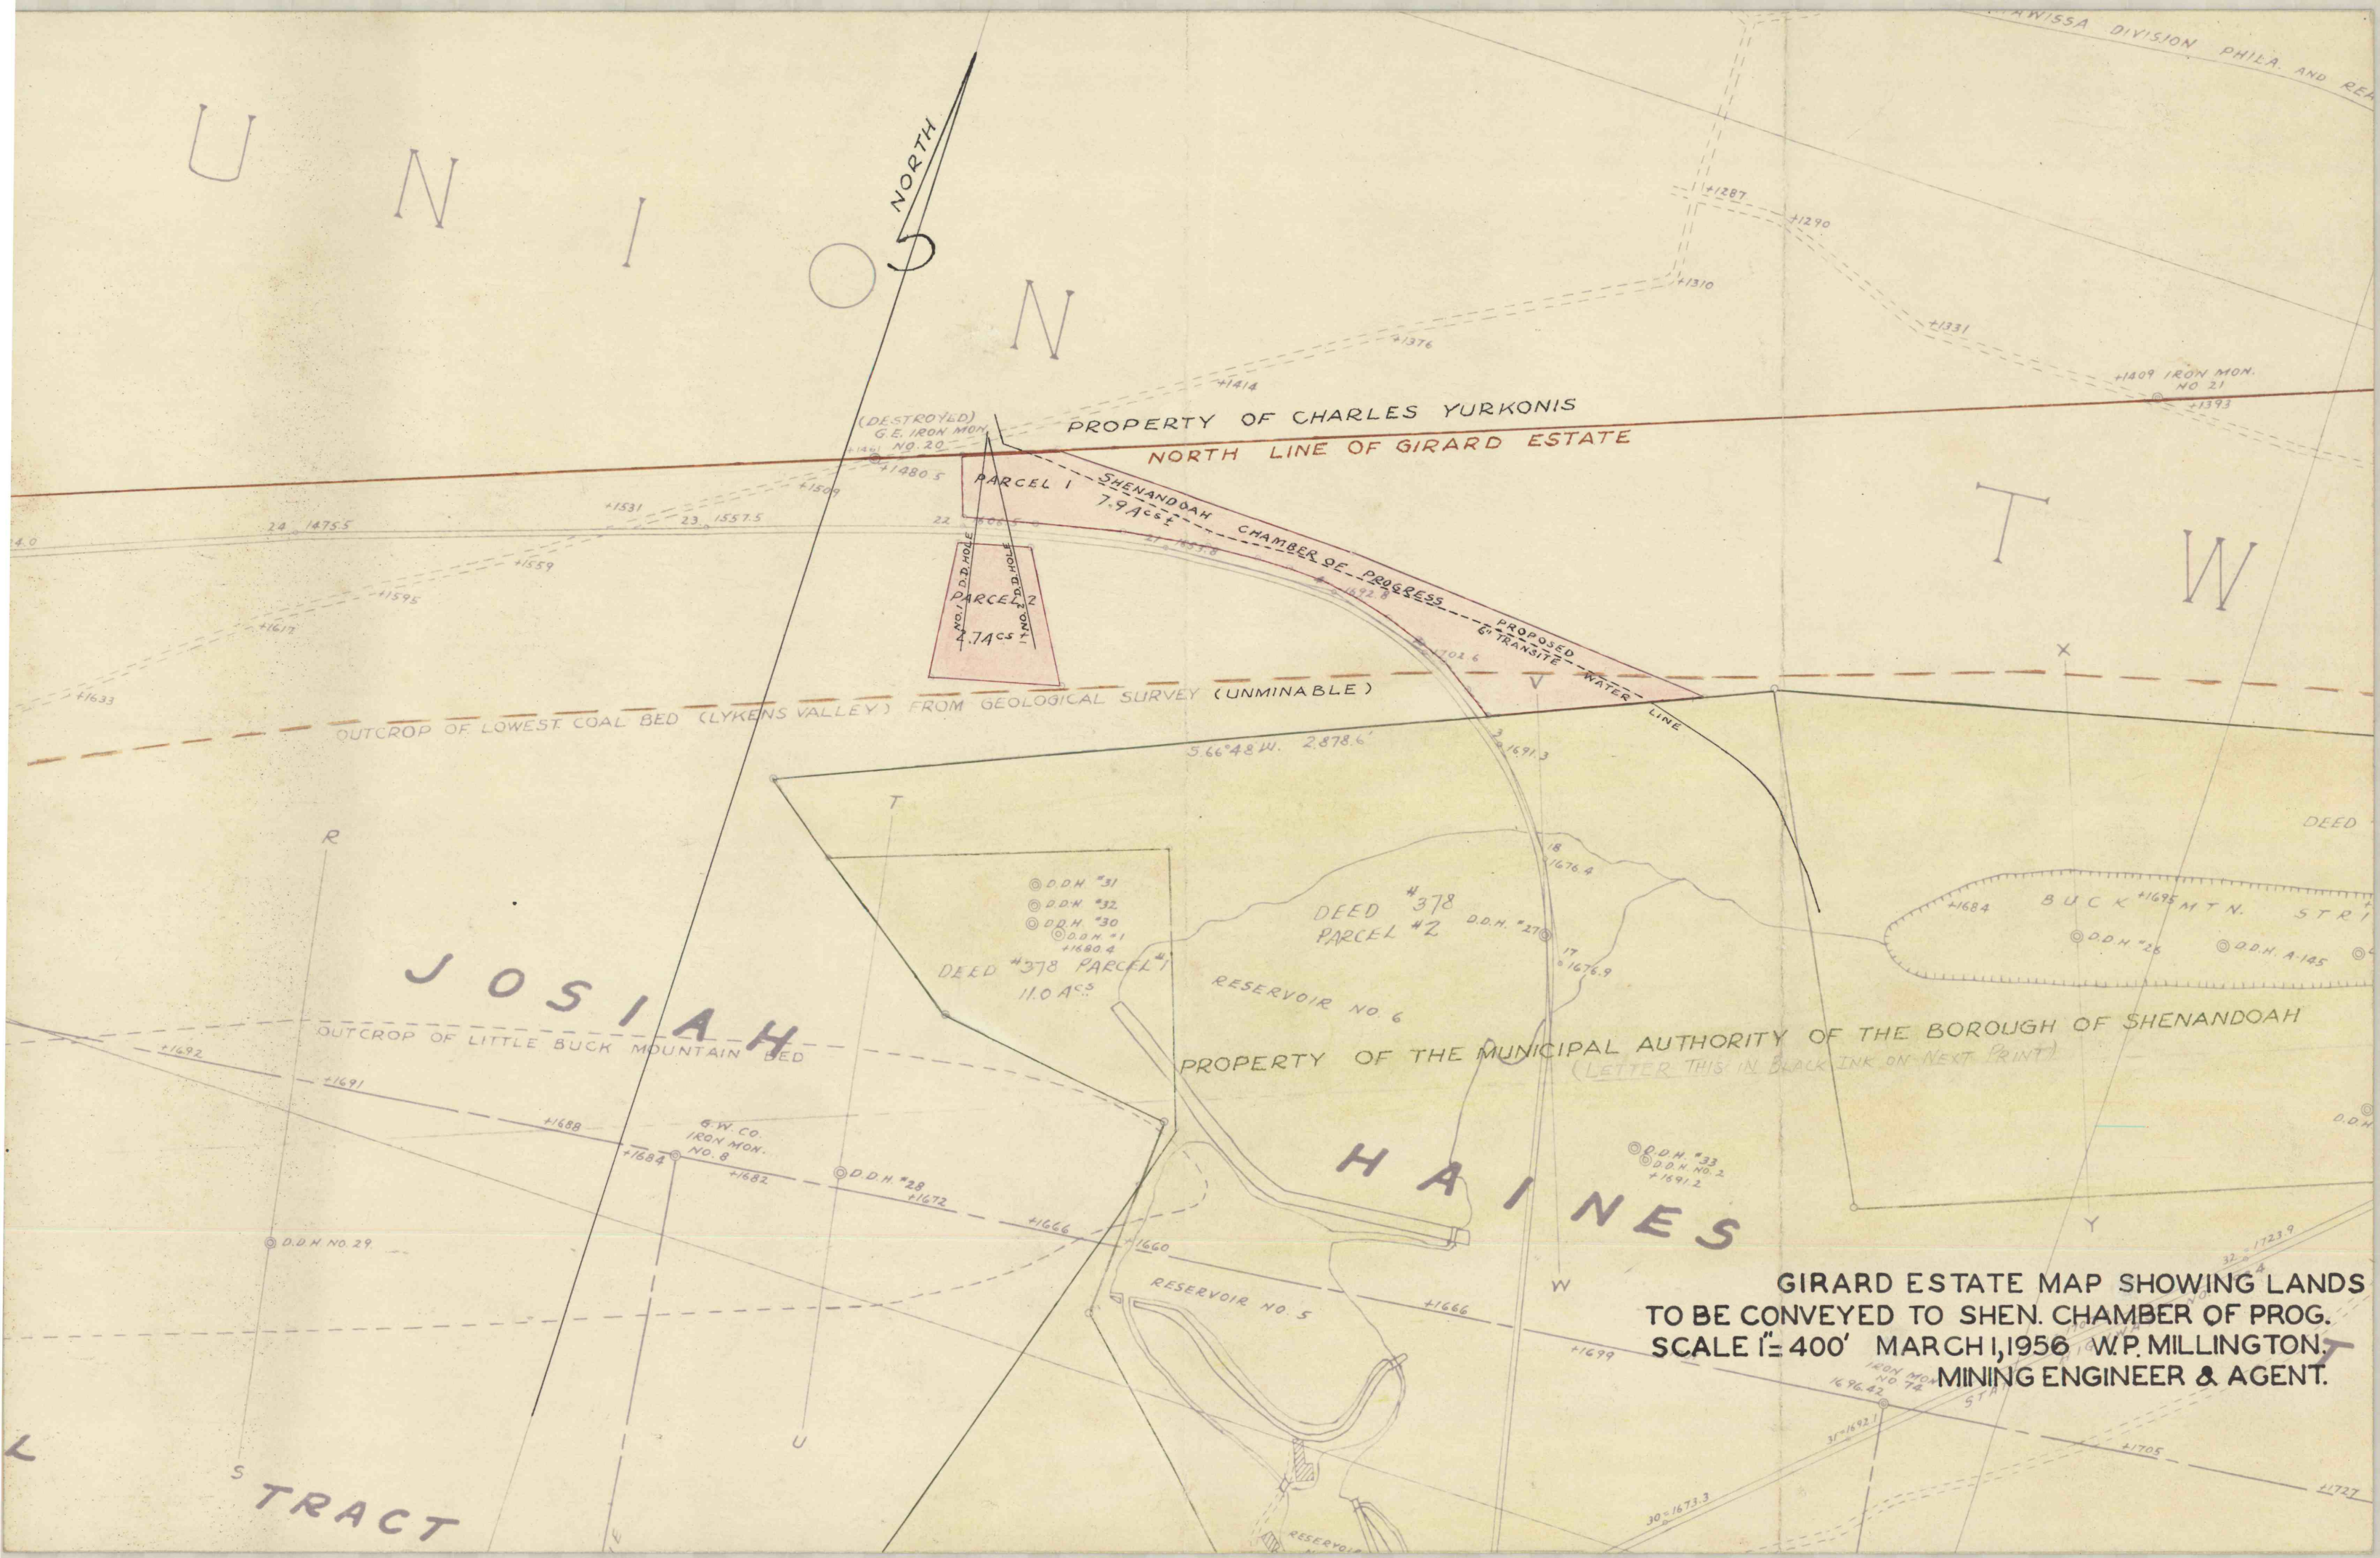

PROPERTY OF CHARLES YURKONIS
NORTH LINE OF GIRARD ESTATE

PARCEL 1
SHENANDOAH CHAMBER OF PROGRESS
7.9 ACES
PARCEL 2
2.74 ACES

OUTCROP OF LOWEST COAL BED (LYKENS VALLEY) FROM GEOLOGICAL SURVEY (UNMINABLE)

JOSIAH
OUTCROP OF LITTLE BUCK MOUNTAIN BED

PROPERTY OF THE MUNICIPAL AUTHORITY OF THE BOROUGH OF SHENANDOAH
(LETTER THIS IN BLACK INK ON NEXT PRINT)

HAINES

GIRARD ESTATE MAP SHOWING LANDS
TO BE CONVEYED TO SHEN. CHAMBER OF PROG.
SCALE 1"=400' MARCH 1, 1956 W.P. MILLINGTON,
MINING ENGINEER & AGENT.