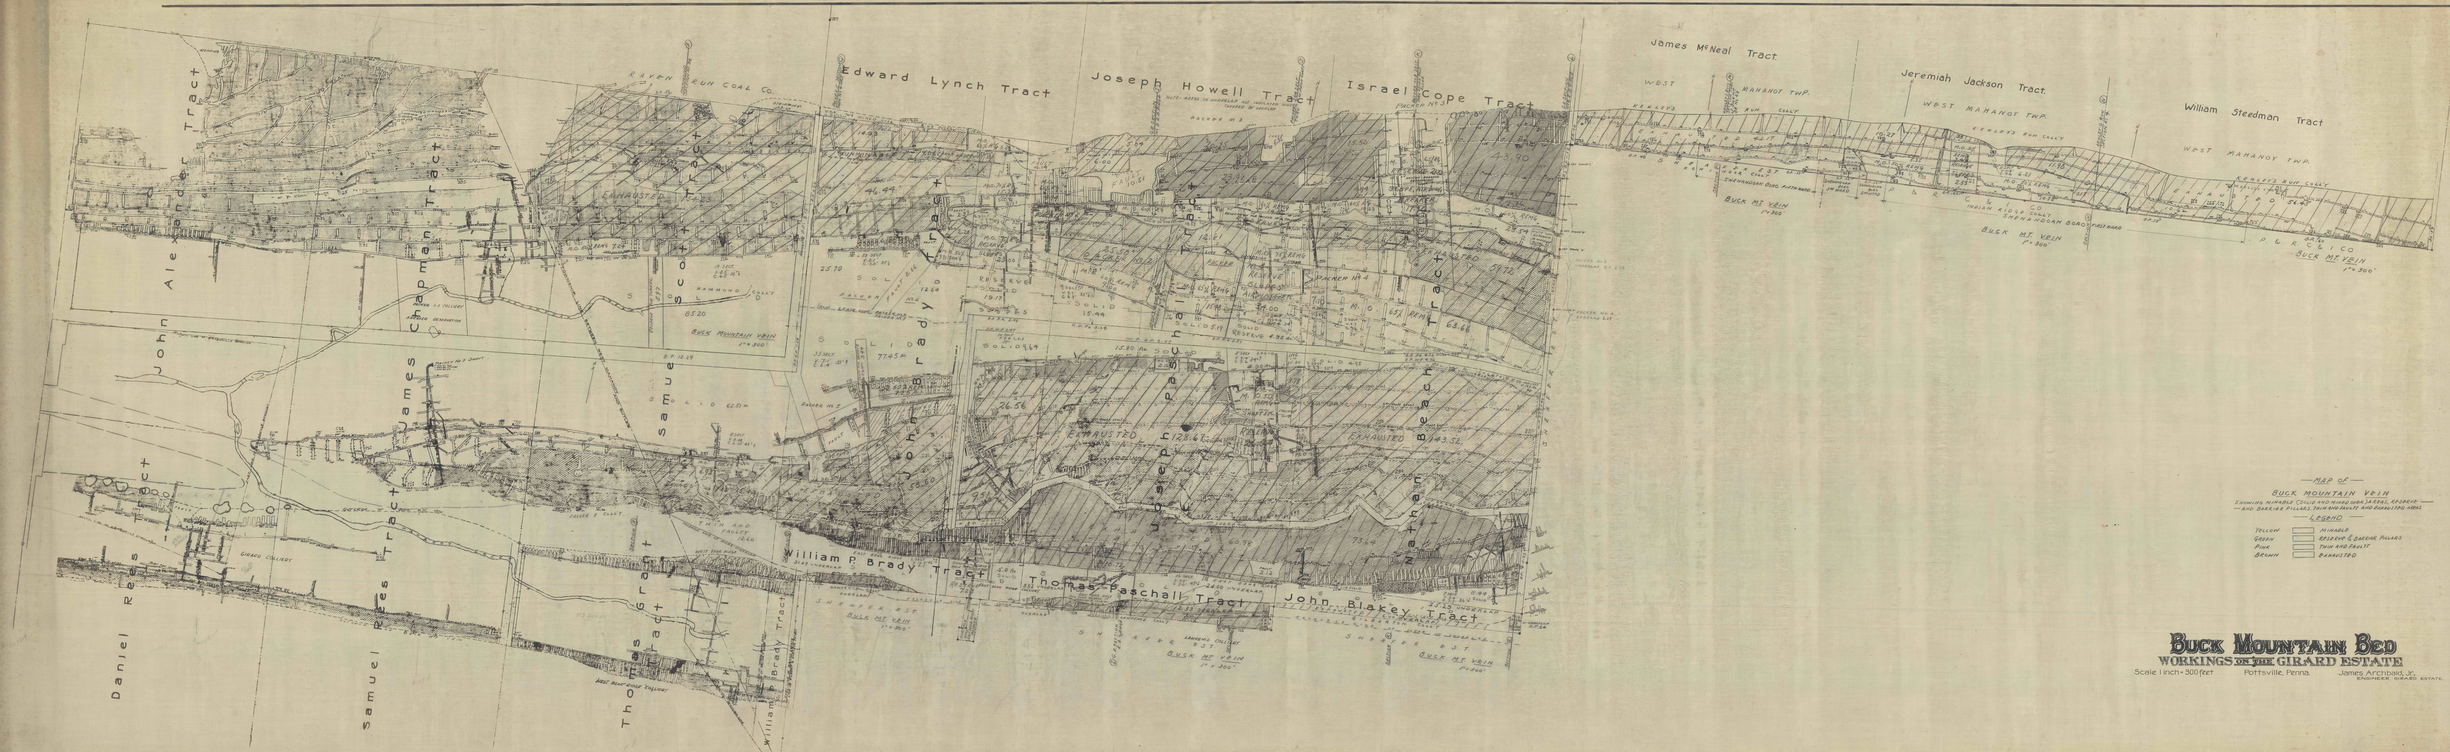


— MAP OF —

BUCK MOUNTAIN VEIN


— LEGEND —

YELLOW	MINABLE
GREEN	RESERVED & BARRIER PILLARS

BUCK MOUNTAIN BED
WORKINGS OF THE GIRARD ESTATE

Scale 1 inch = 300 feet — Pottsville, Penna. — James Archibald, E.
ENGINEER GIRARD ESTATE.