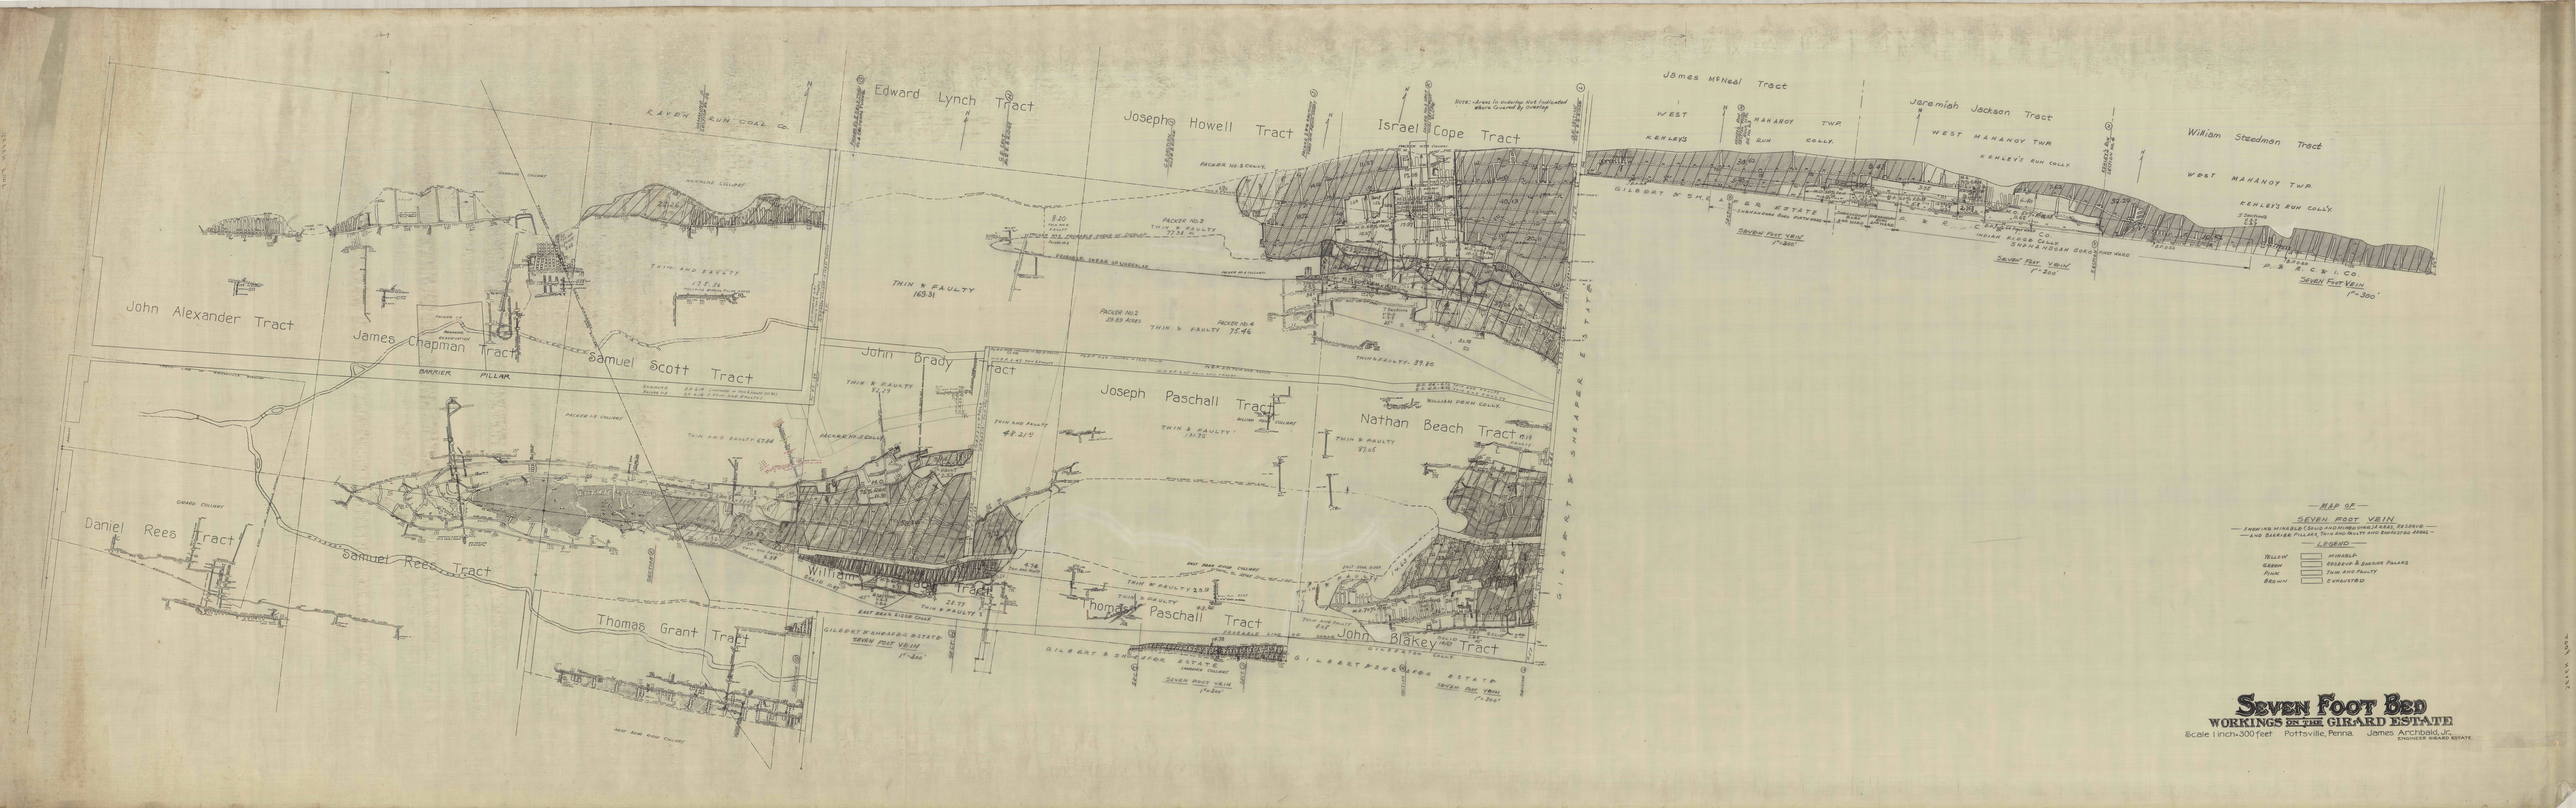
Edward Lynch Tract
Joseph Howell Tract
Israel Cope Tract
James McNeal Tract
Jeremiah Jackson Tract
William Steedman Tract
John Alexander Tract
James Chapman Tract
Samuel Scott Tract
John Brady Tract
Joseph Paschall Tract
Nathan Beach Tract
Daniel Rees Tract
Samuel Rees Tract
William Tract
Thomas Paschall Tract
John Blakey Tract
Thomas Grant Tract
RAVEN RUN COAL CO.
GIRARD COLLEGE
BARRIER PILLAR
GILBERT & SHAEFER ESTATE
SEVEN FOOT VEIN
1"=300'
MAP OF
SEVEN FOOT VEIN
SHOWING MINABLE COALS AND MINED OUT AREAS, PASSIVE AND BARRIER PILLARS, THIN AND FAULTY AND WORKED AREAS
LEGEND
YELLOW MINABLE
GREEN ROBBED & QUARRE PILLARS
PINK THIN AND FAULTY
BROWN EXHAUSTED
SEVEN FOOT BED
WORKINGS ON THE GIRARD ESTATE
Scale 1 inch=300 feet Pottsville, Penna. James Archbald, Jr.
ENGINEER GIRARD ESTATE