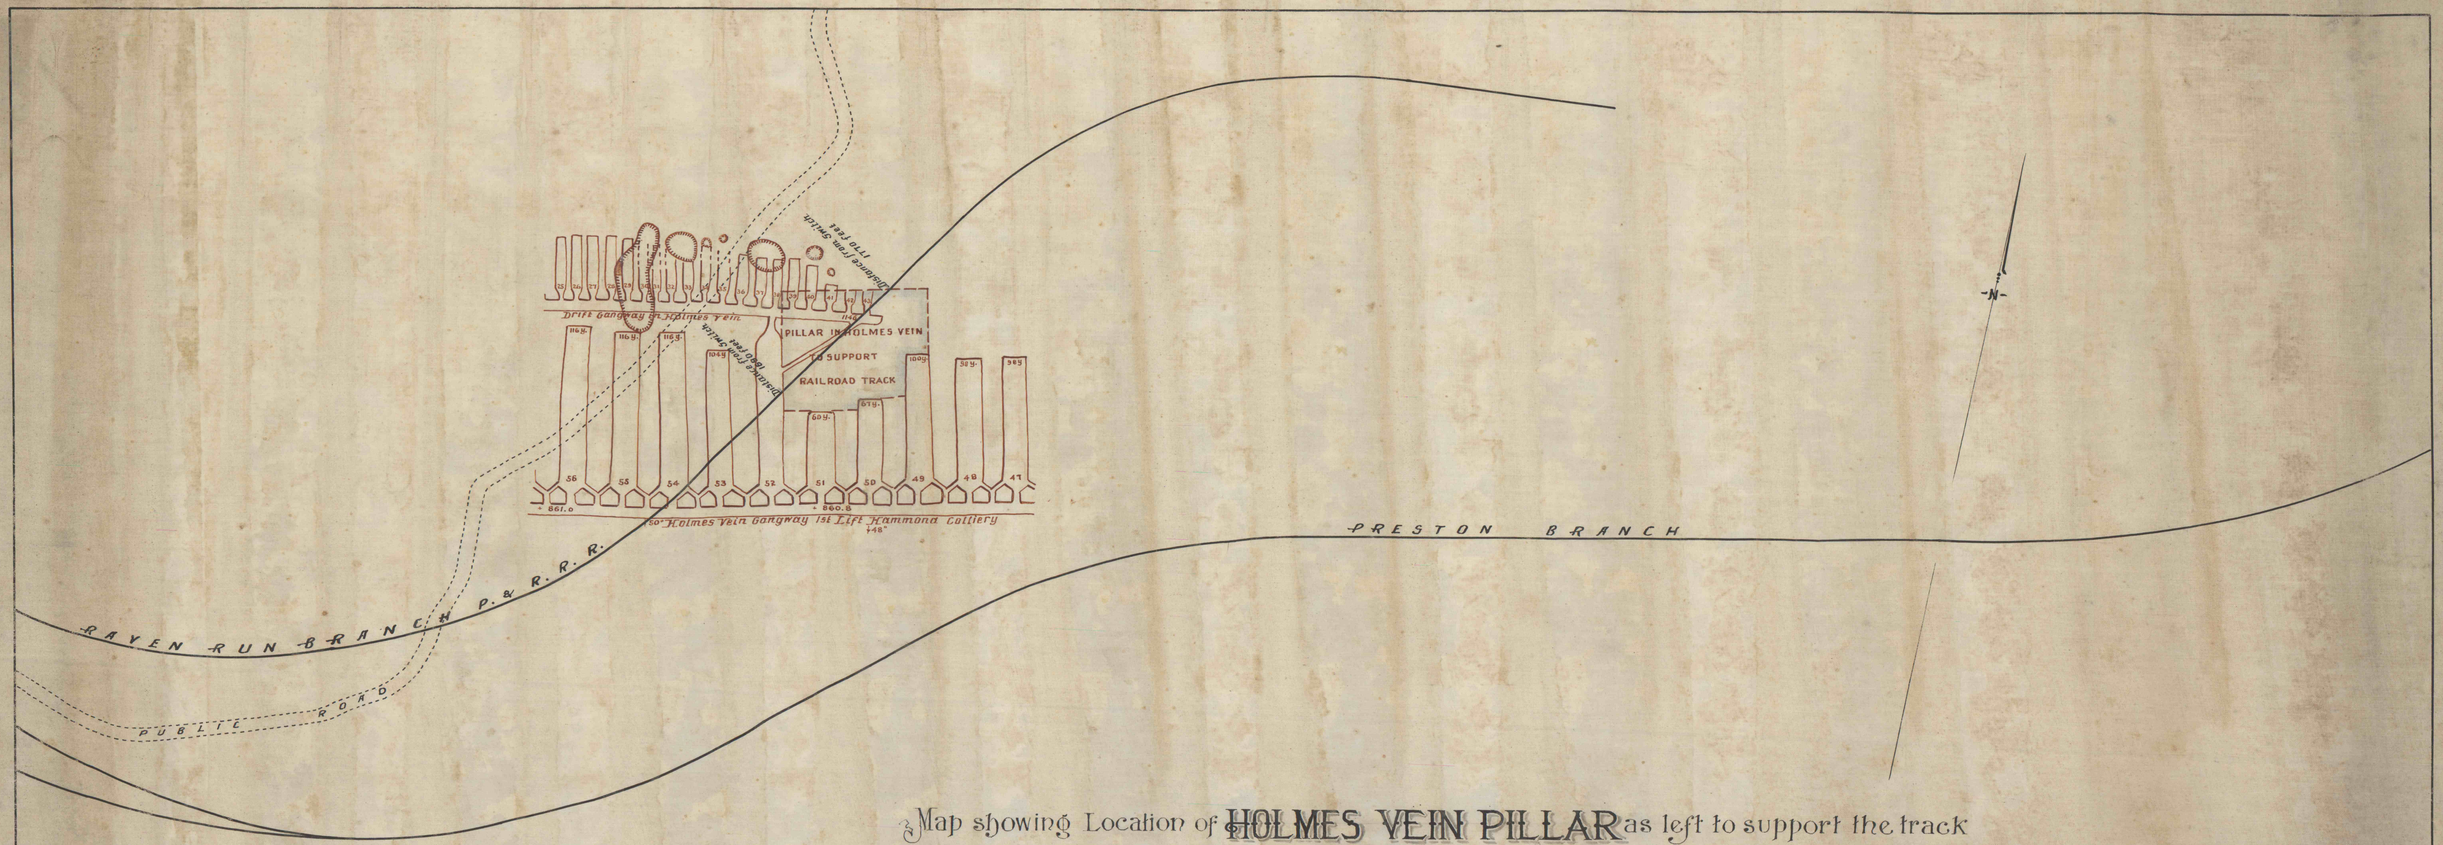

Map showing Location of HOLMES VEIN PILLAR as left to support the track

ON THE

RAVEN RUN BRANCH OF THE P. & R. RAILROAD

Scale 100 feet per inch

Pottsville, February 1899.

Copied from P. & R. C. & I. Co's blue print by H. S. Thompson April 26. 1900