HAMMOND COLLIERY

PLAN AND PROFILE ON CENTER LINE BETWEEN SOUTH COMPARTMENTS OF PROPOSED COAL HOISTING SHAFT

SCALE 8 FEET PER INCH

S. P. Heller Division Engineer
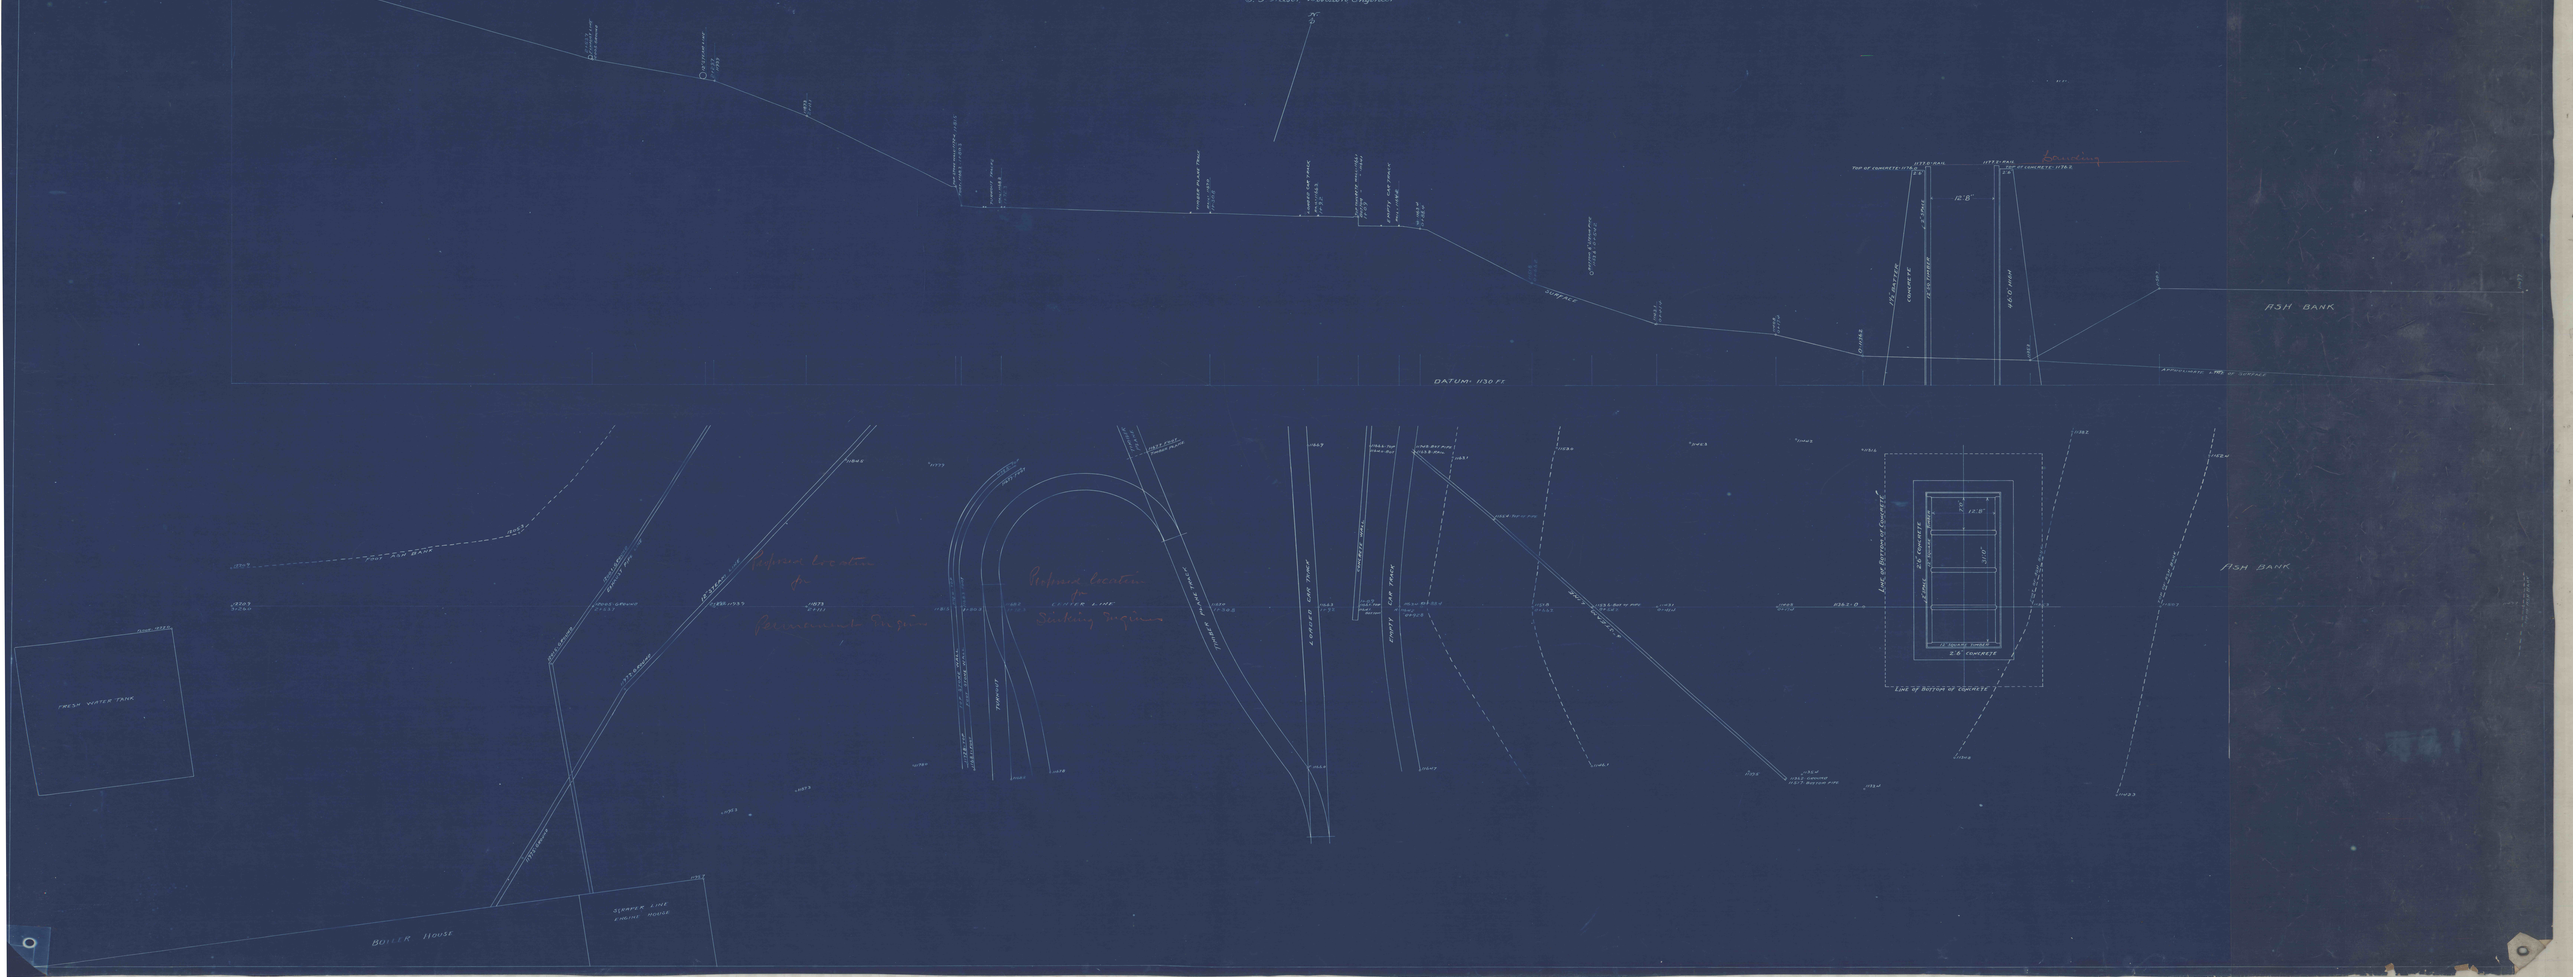
ASHLAND, PA., MAY 17TH 1909