HAMMOND COLLIERY.

Profile through proving hole opposite no. 111 breast in West Diamond Gangway on 3rd. Lift.

Scale 16 feet = 1 inch

Ashland, Pa., Dec. 13th 1912.

F.P. Weiser, Div. Engr.
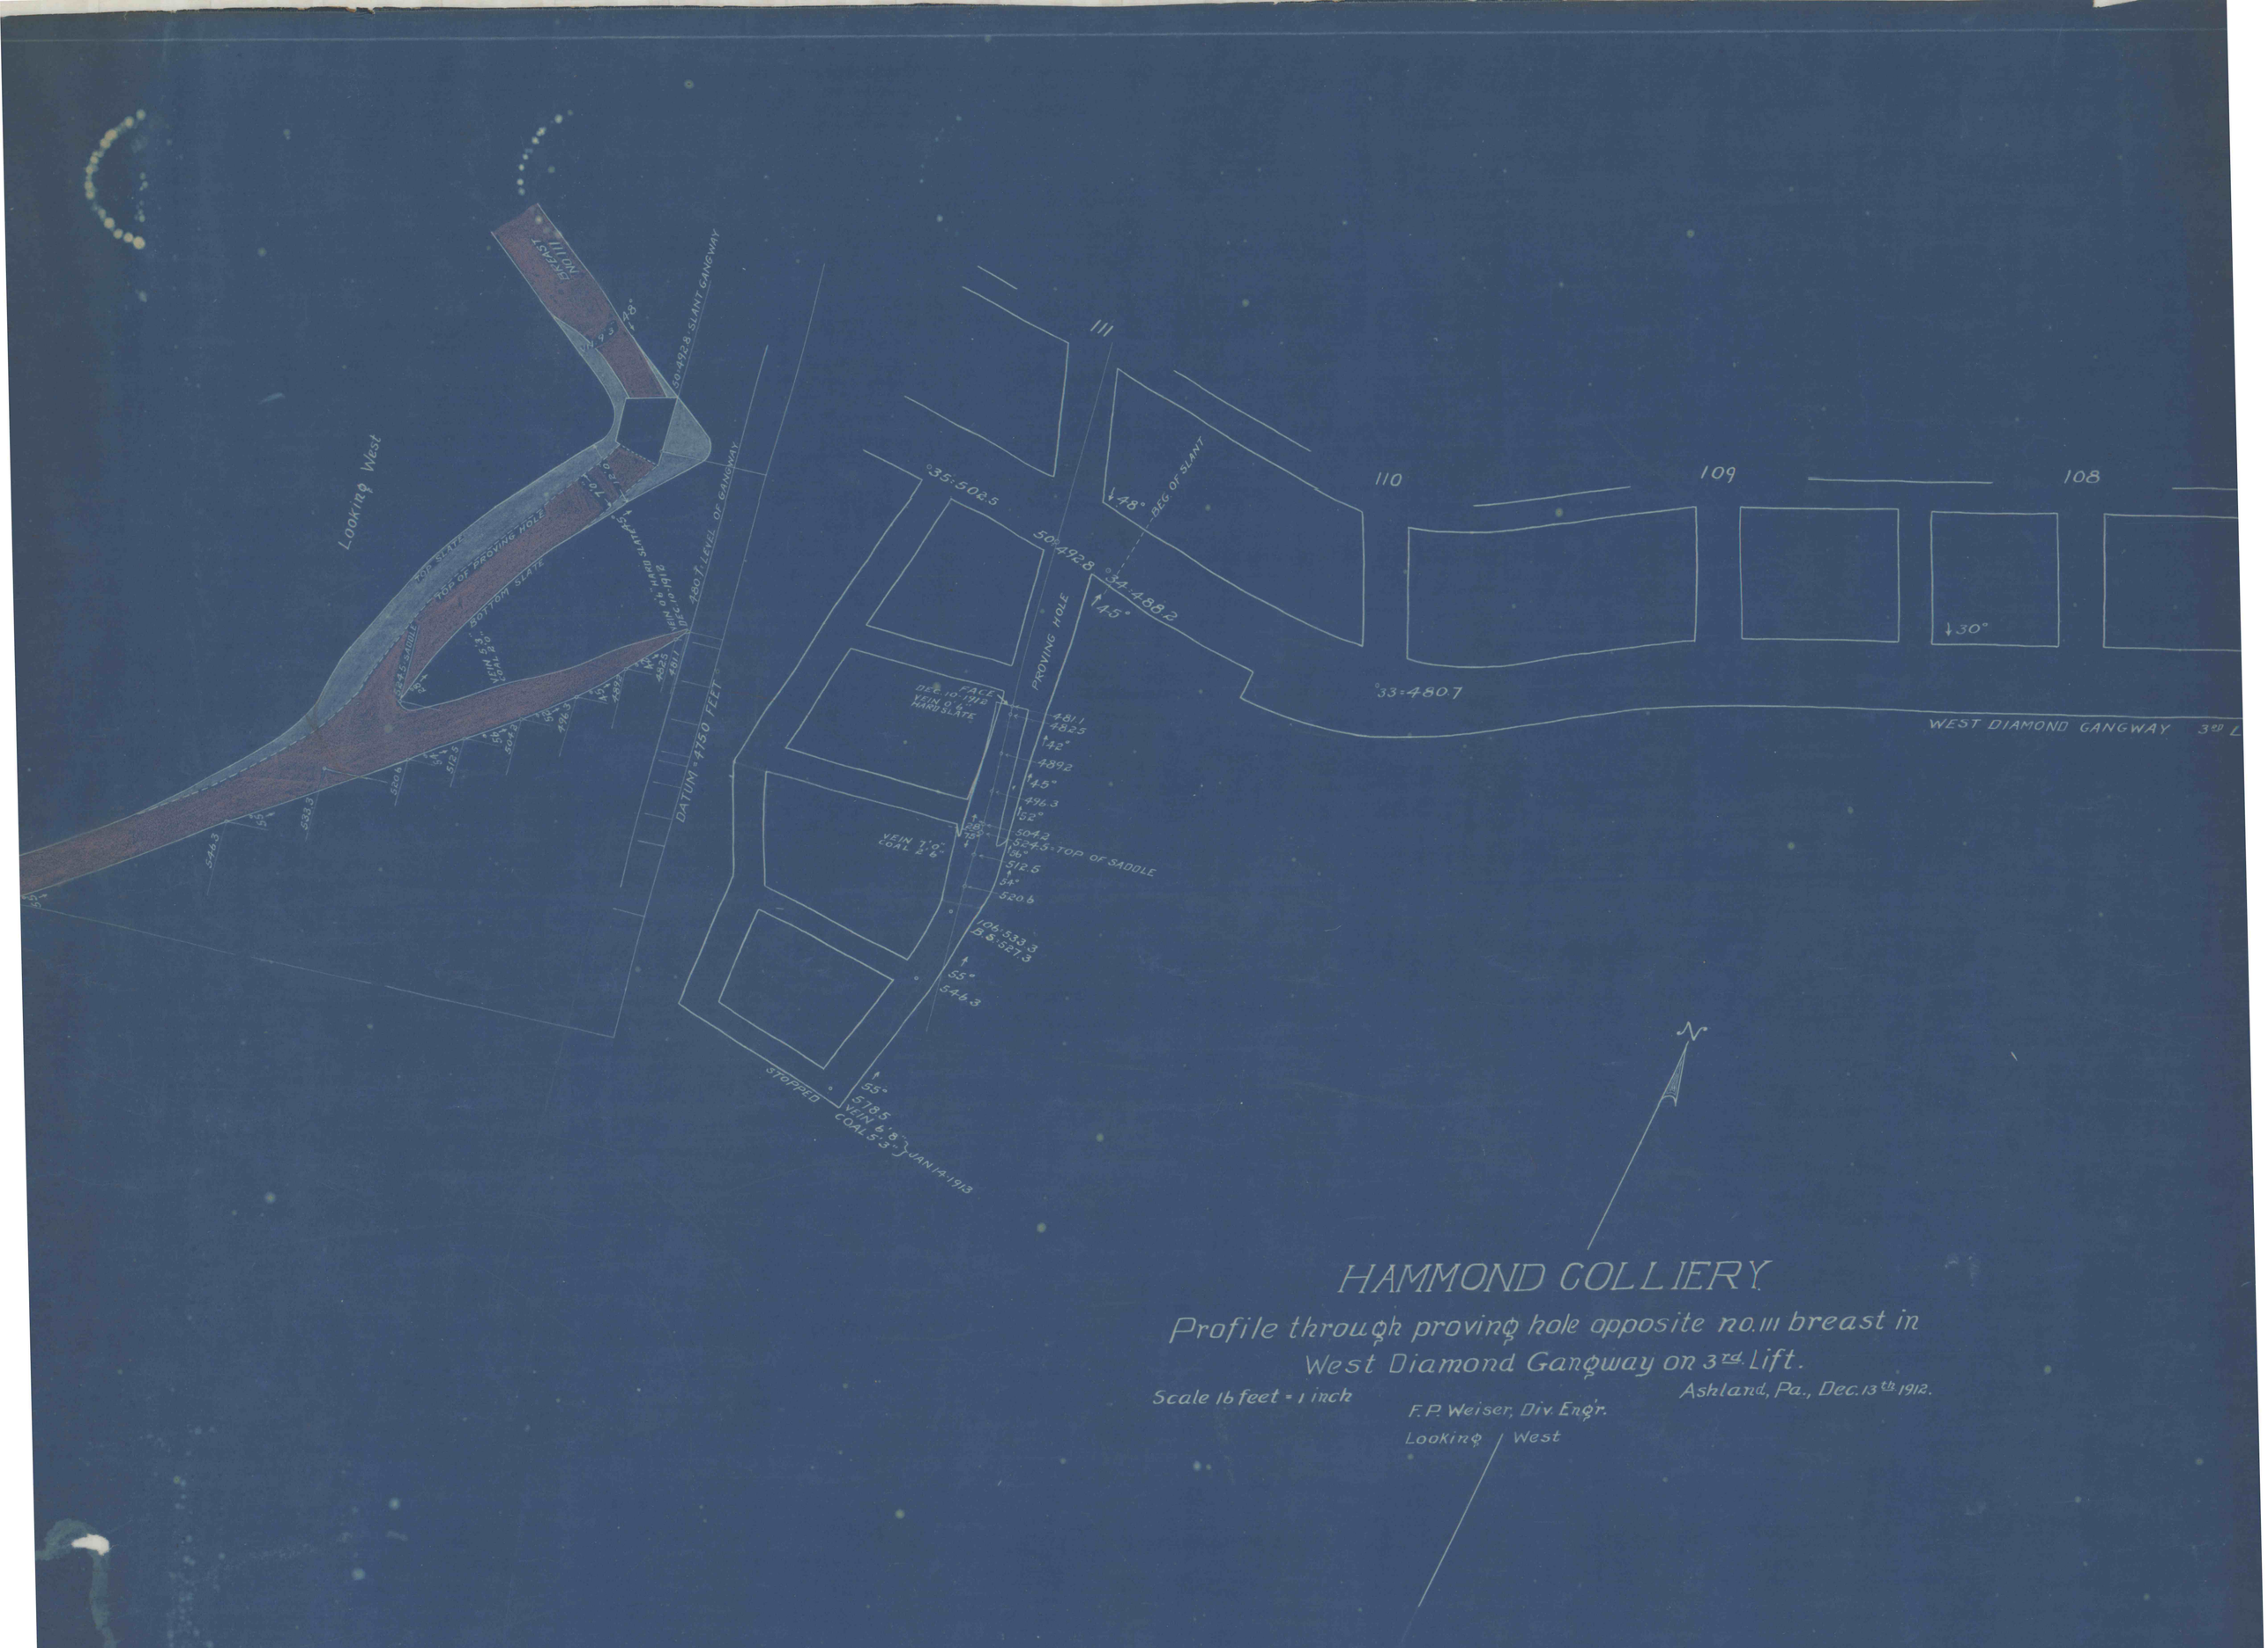
Looking West