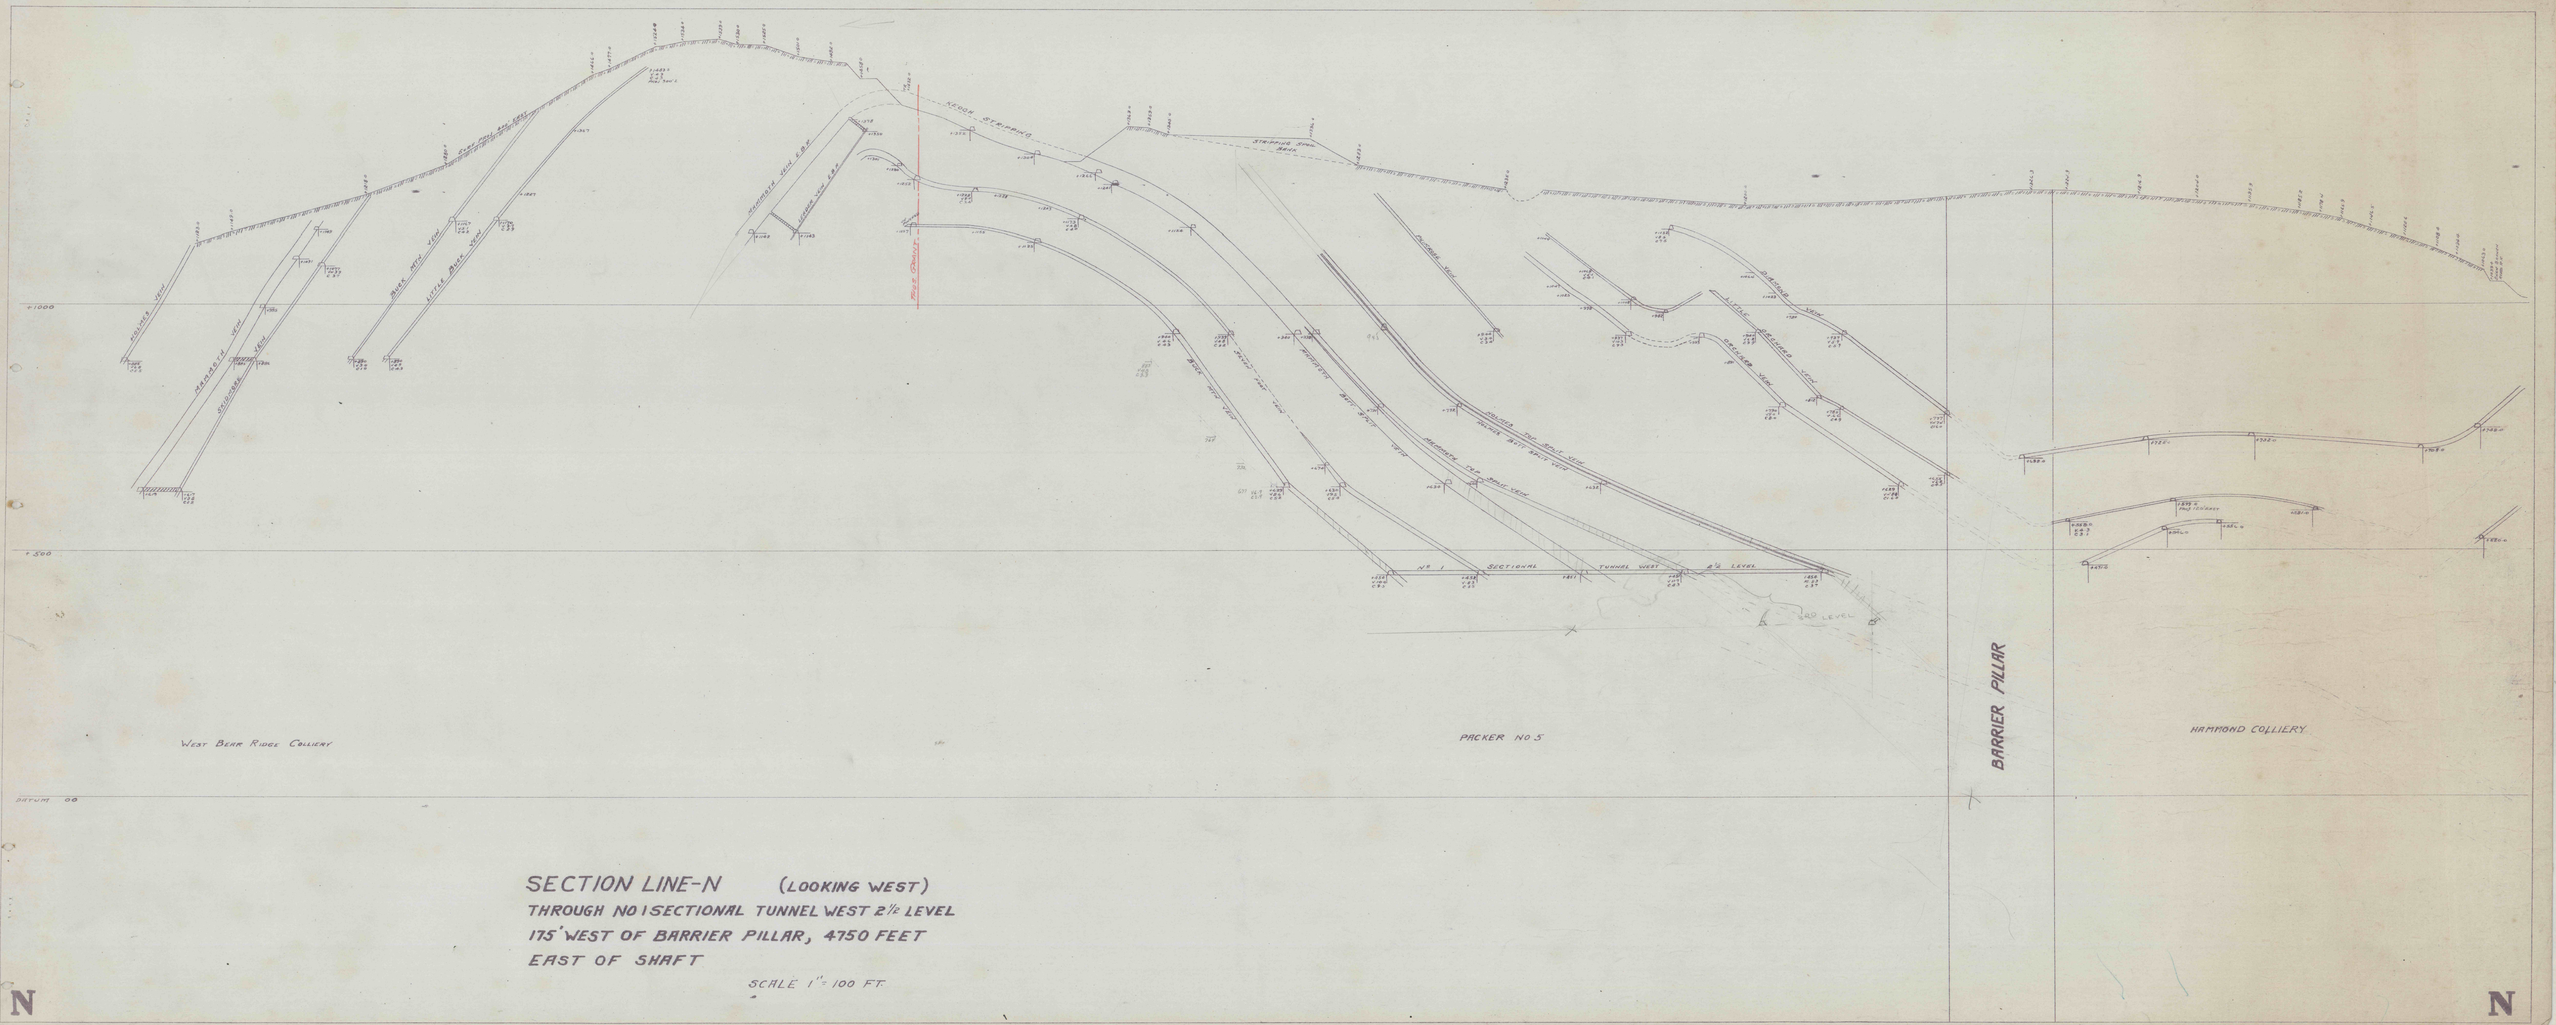

SECTION LINE-N (LOOKING WEST)
THROUGH NO 1 SECTIONAL TUNNEL WEST 2½ LEVEL
175' WEST OF BARRIER PILLAR, 4750 FEET
EAST OF SHAFT

SCALE 1" = 100 FT.