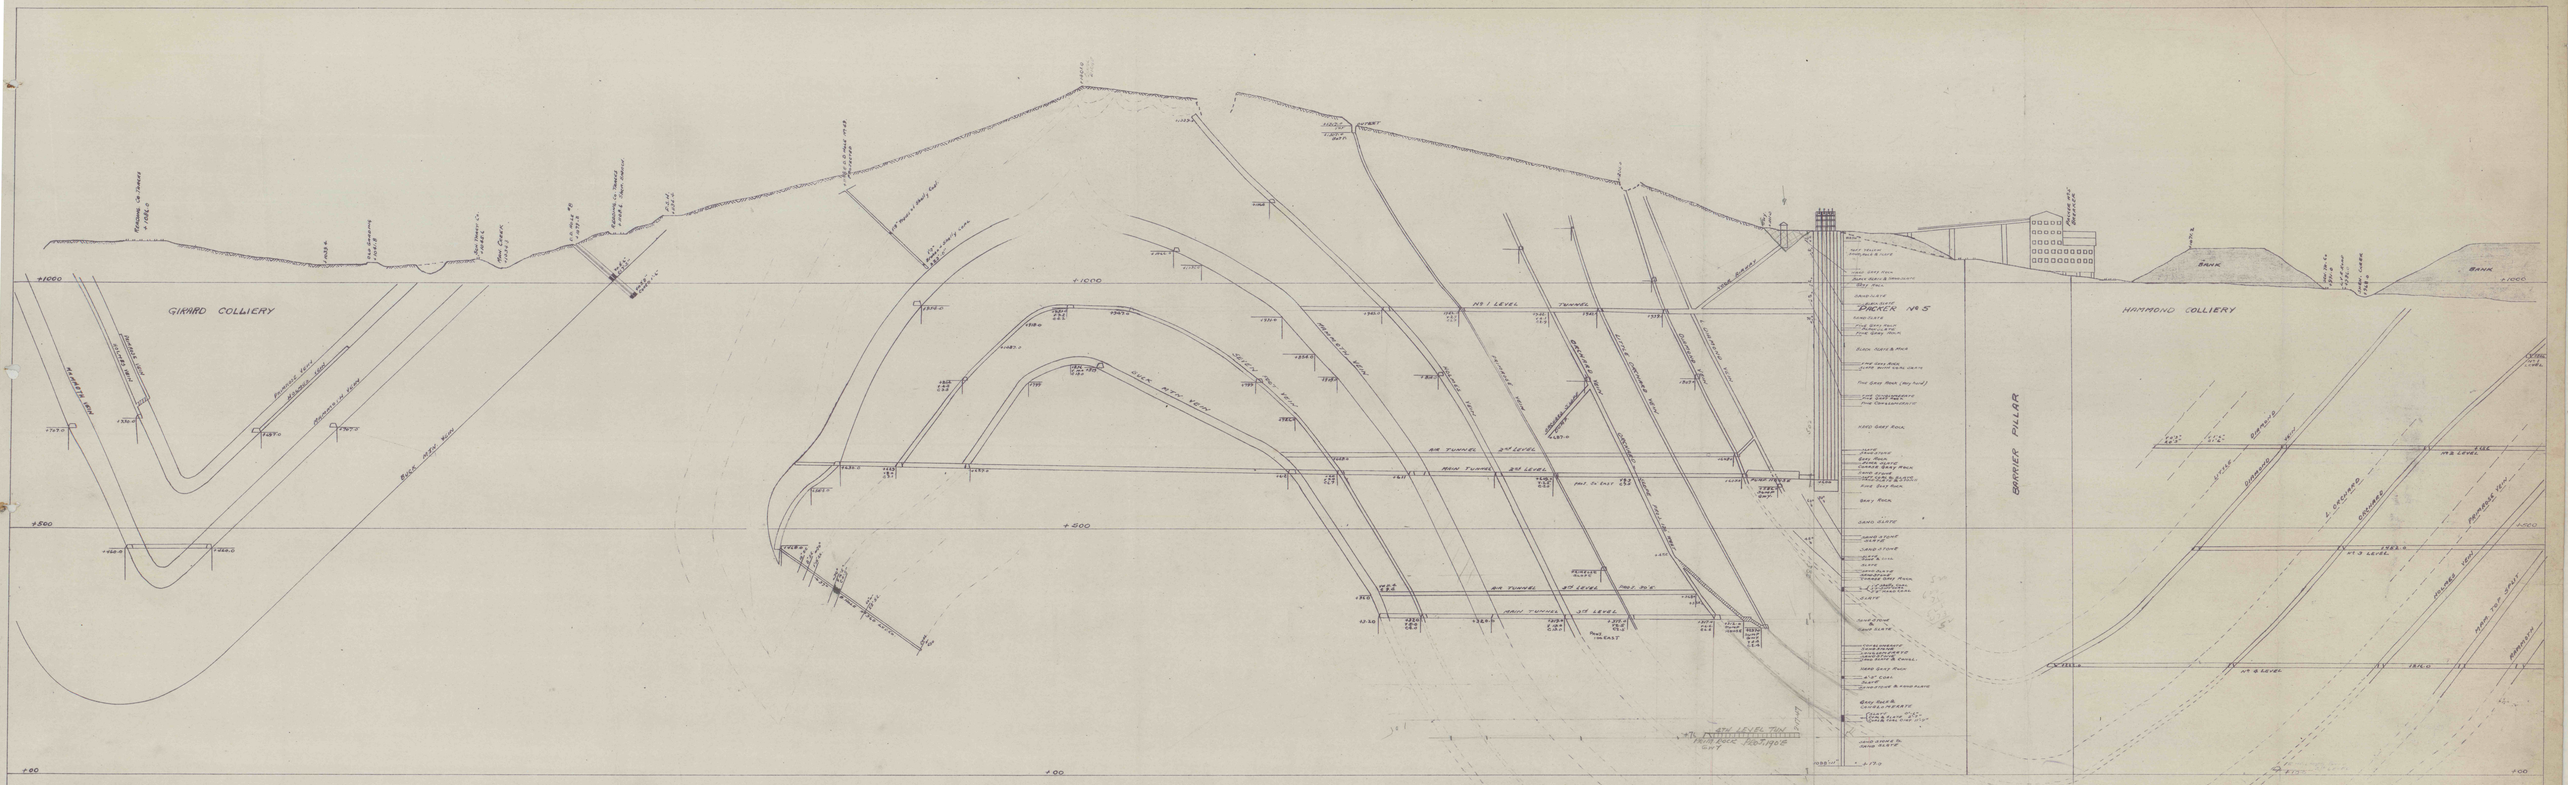

SECTION - G - (LOOKING WEST)
THROUGH MAIN TUNNELS 1ST, 2ND & 3RD LEVELS
AND PACKER No 5 SHAFT
SCALE 1" = 100'

G

G