


DANIEL BROBST TRACT

ROBERT IRWIN TRACT

PHILADELPHIA AND READING COAL AND IRON CO.

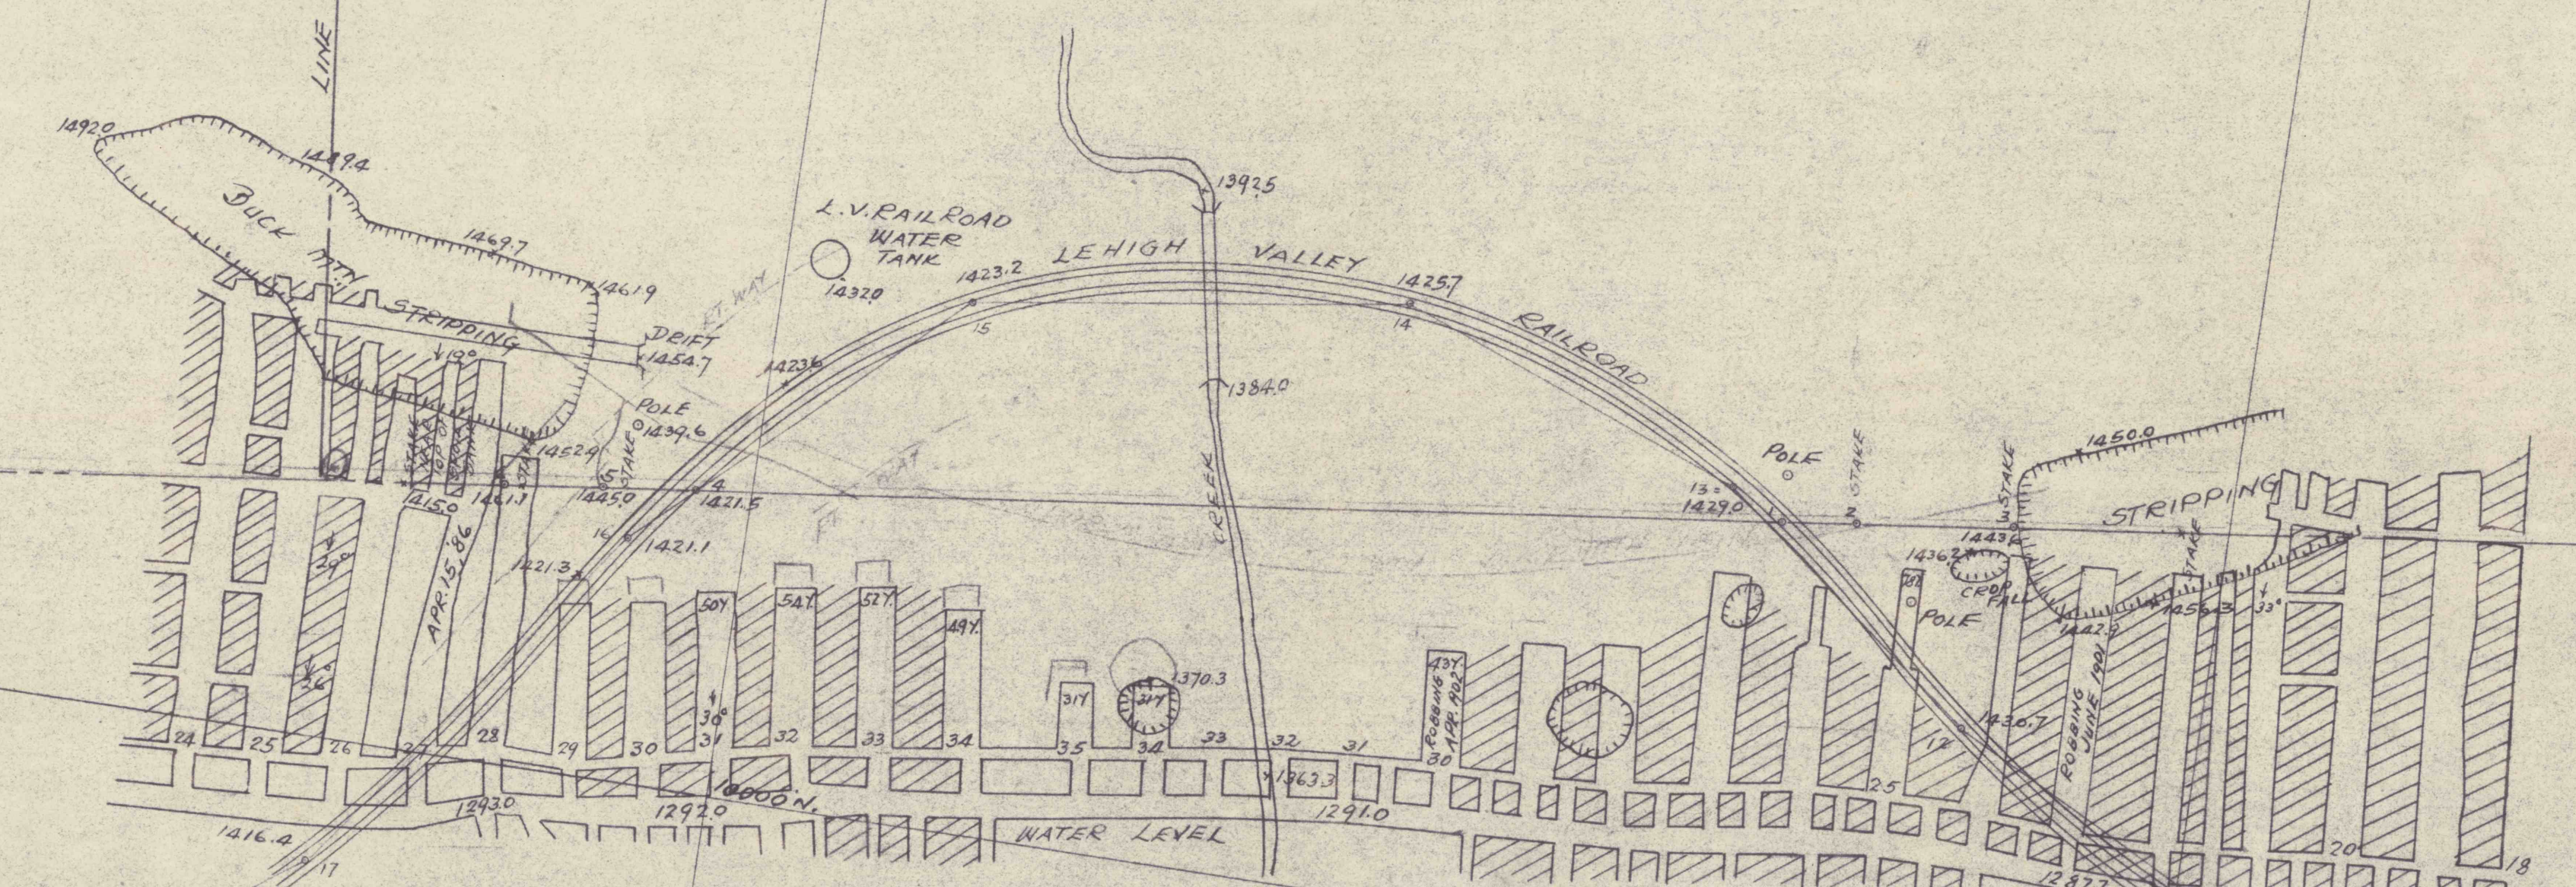

CALCULATED COURSE $N. 82^{\circ} 53' E.$ DISTANCE 6801.94 VAL. 426 P. 3/4
 $N. 82^{\circ} 53' E.$ DISTANCE 6801.94 VAL. 426 P. 3/4
 $N. 82^{\circ} 53' E.$ DISTANCE 6801.94 VAL. 426 P. 3/4

SOUTH LINE OF DANIEL BROBST TRACT

SOUTH LINE OF ROBERT IRWIN TRACT