


Parker Composite
2-4

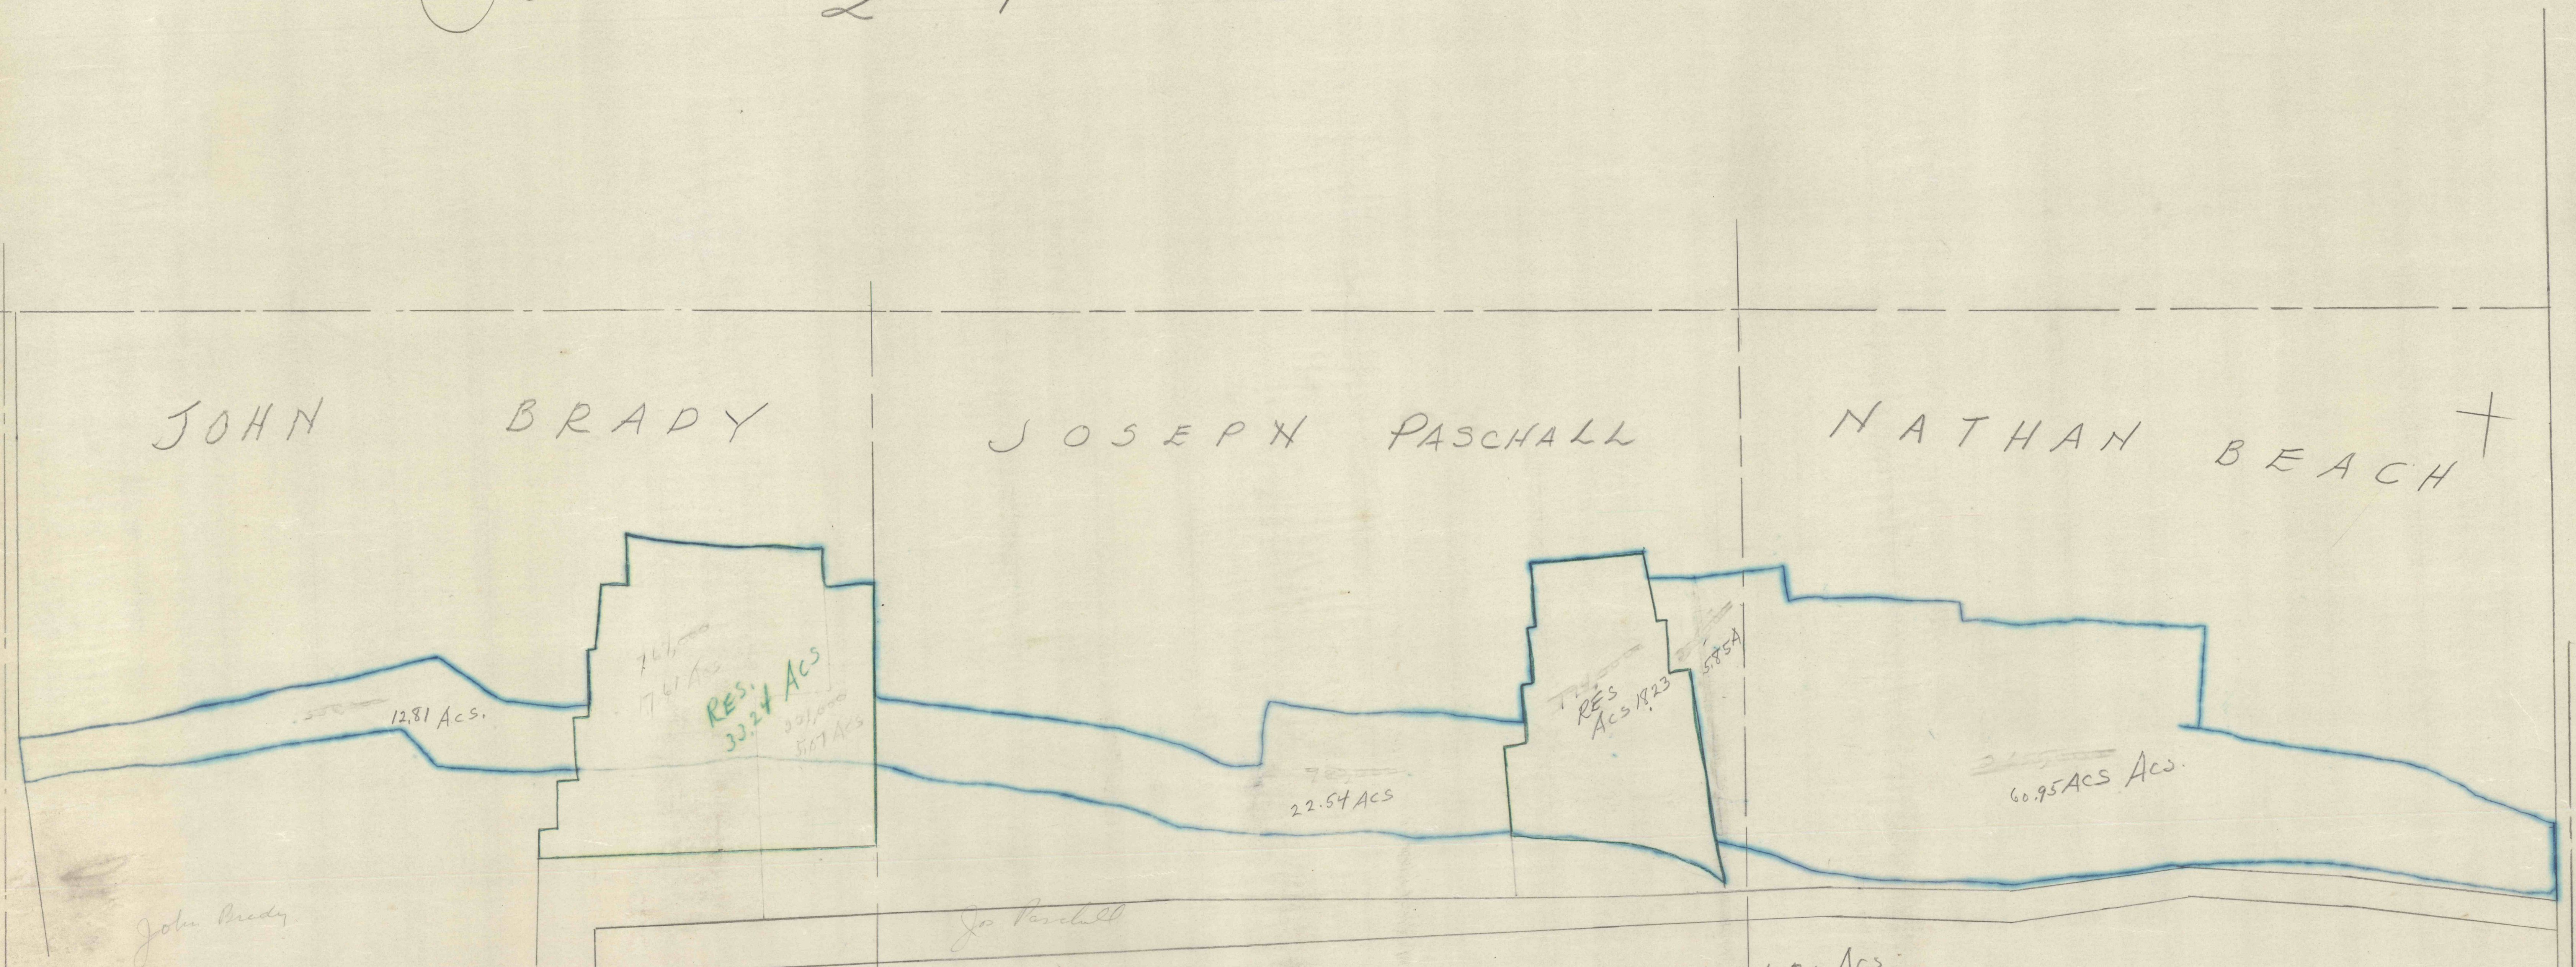

DEVELOPED
J. BRADY 12.81 Acs
J. PASCHALL 28.39 "
N. BEACH 60.95 "
TOTAL 102.15 "

RESERVATION
JOHN BRADY W.M. 33.24 Acs.
JOSEPH PASCHALL 18.23 Acs
TOTAL 51.47 Acs

TOTAL 153.62 Acs