


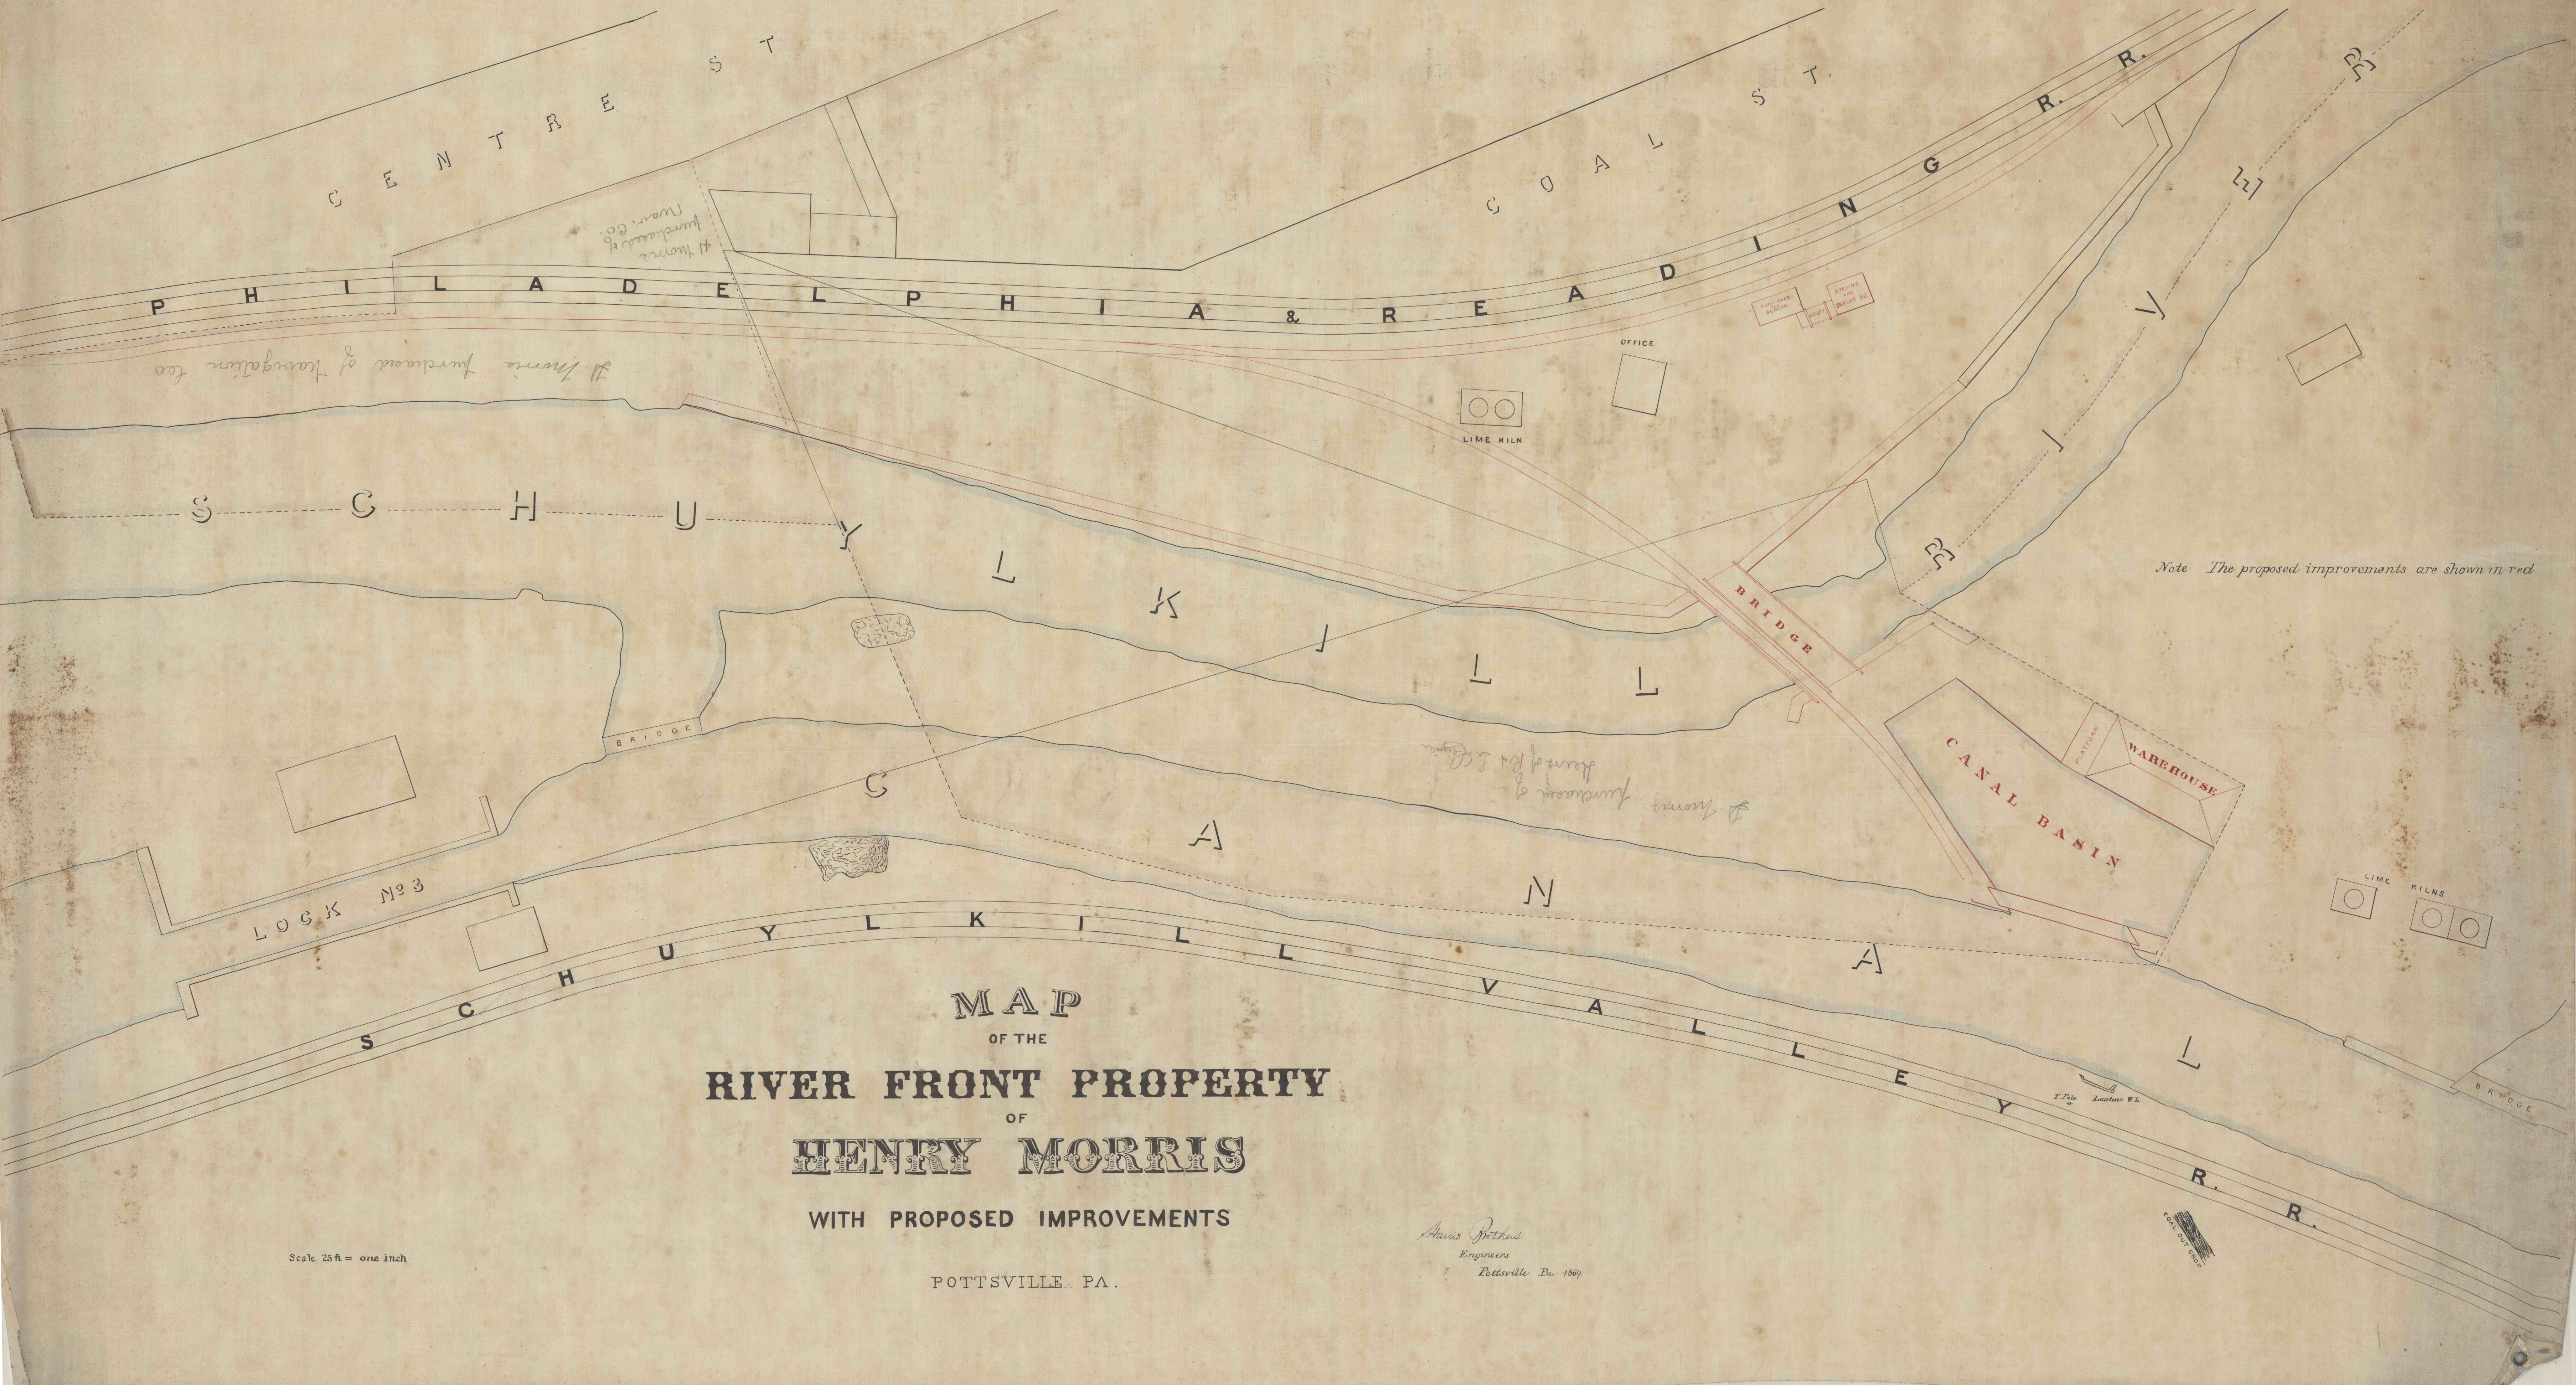

Scale 25 ft = one inch

MAP
OF THE
RIVER FRONT PROPERTY
OF
HENRY MORRIS

WITH PROPOSED IMPROVEMENTS

POTTSVILLE PA.

Engineers
Pottsville Pa. 1864

Note The proposed improvements are shown in red.