


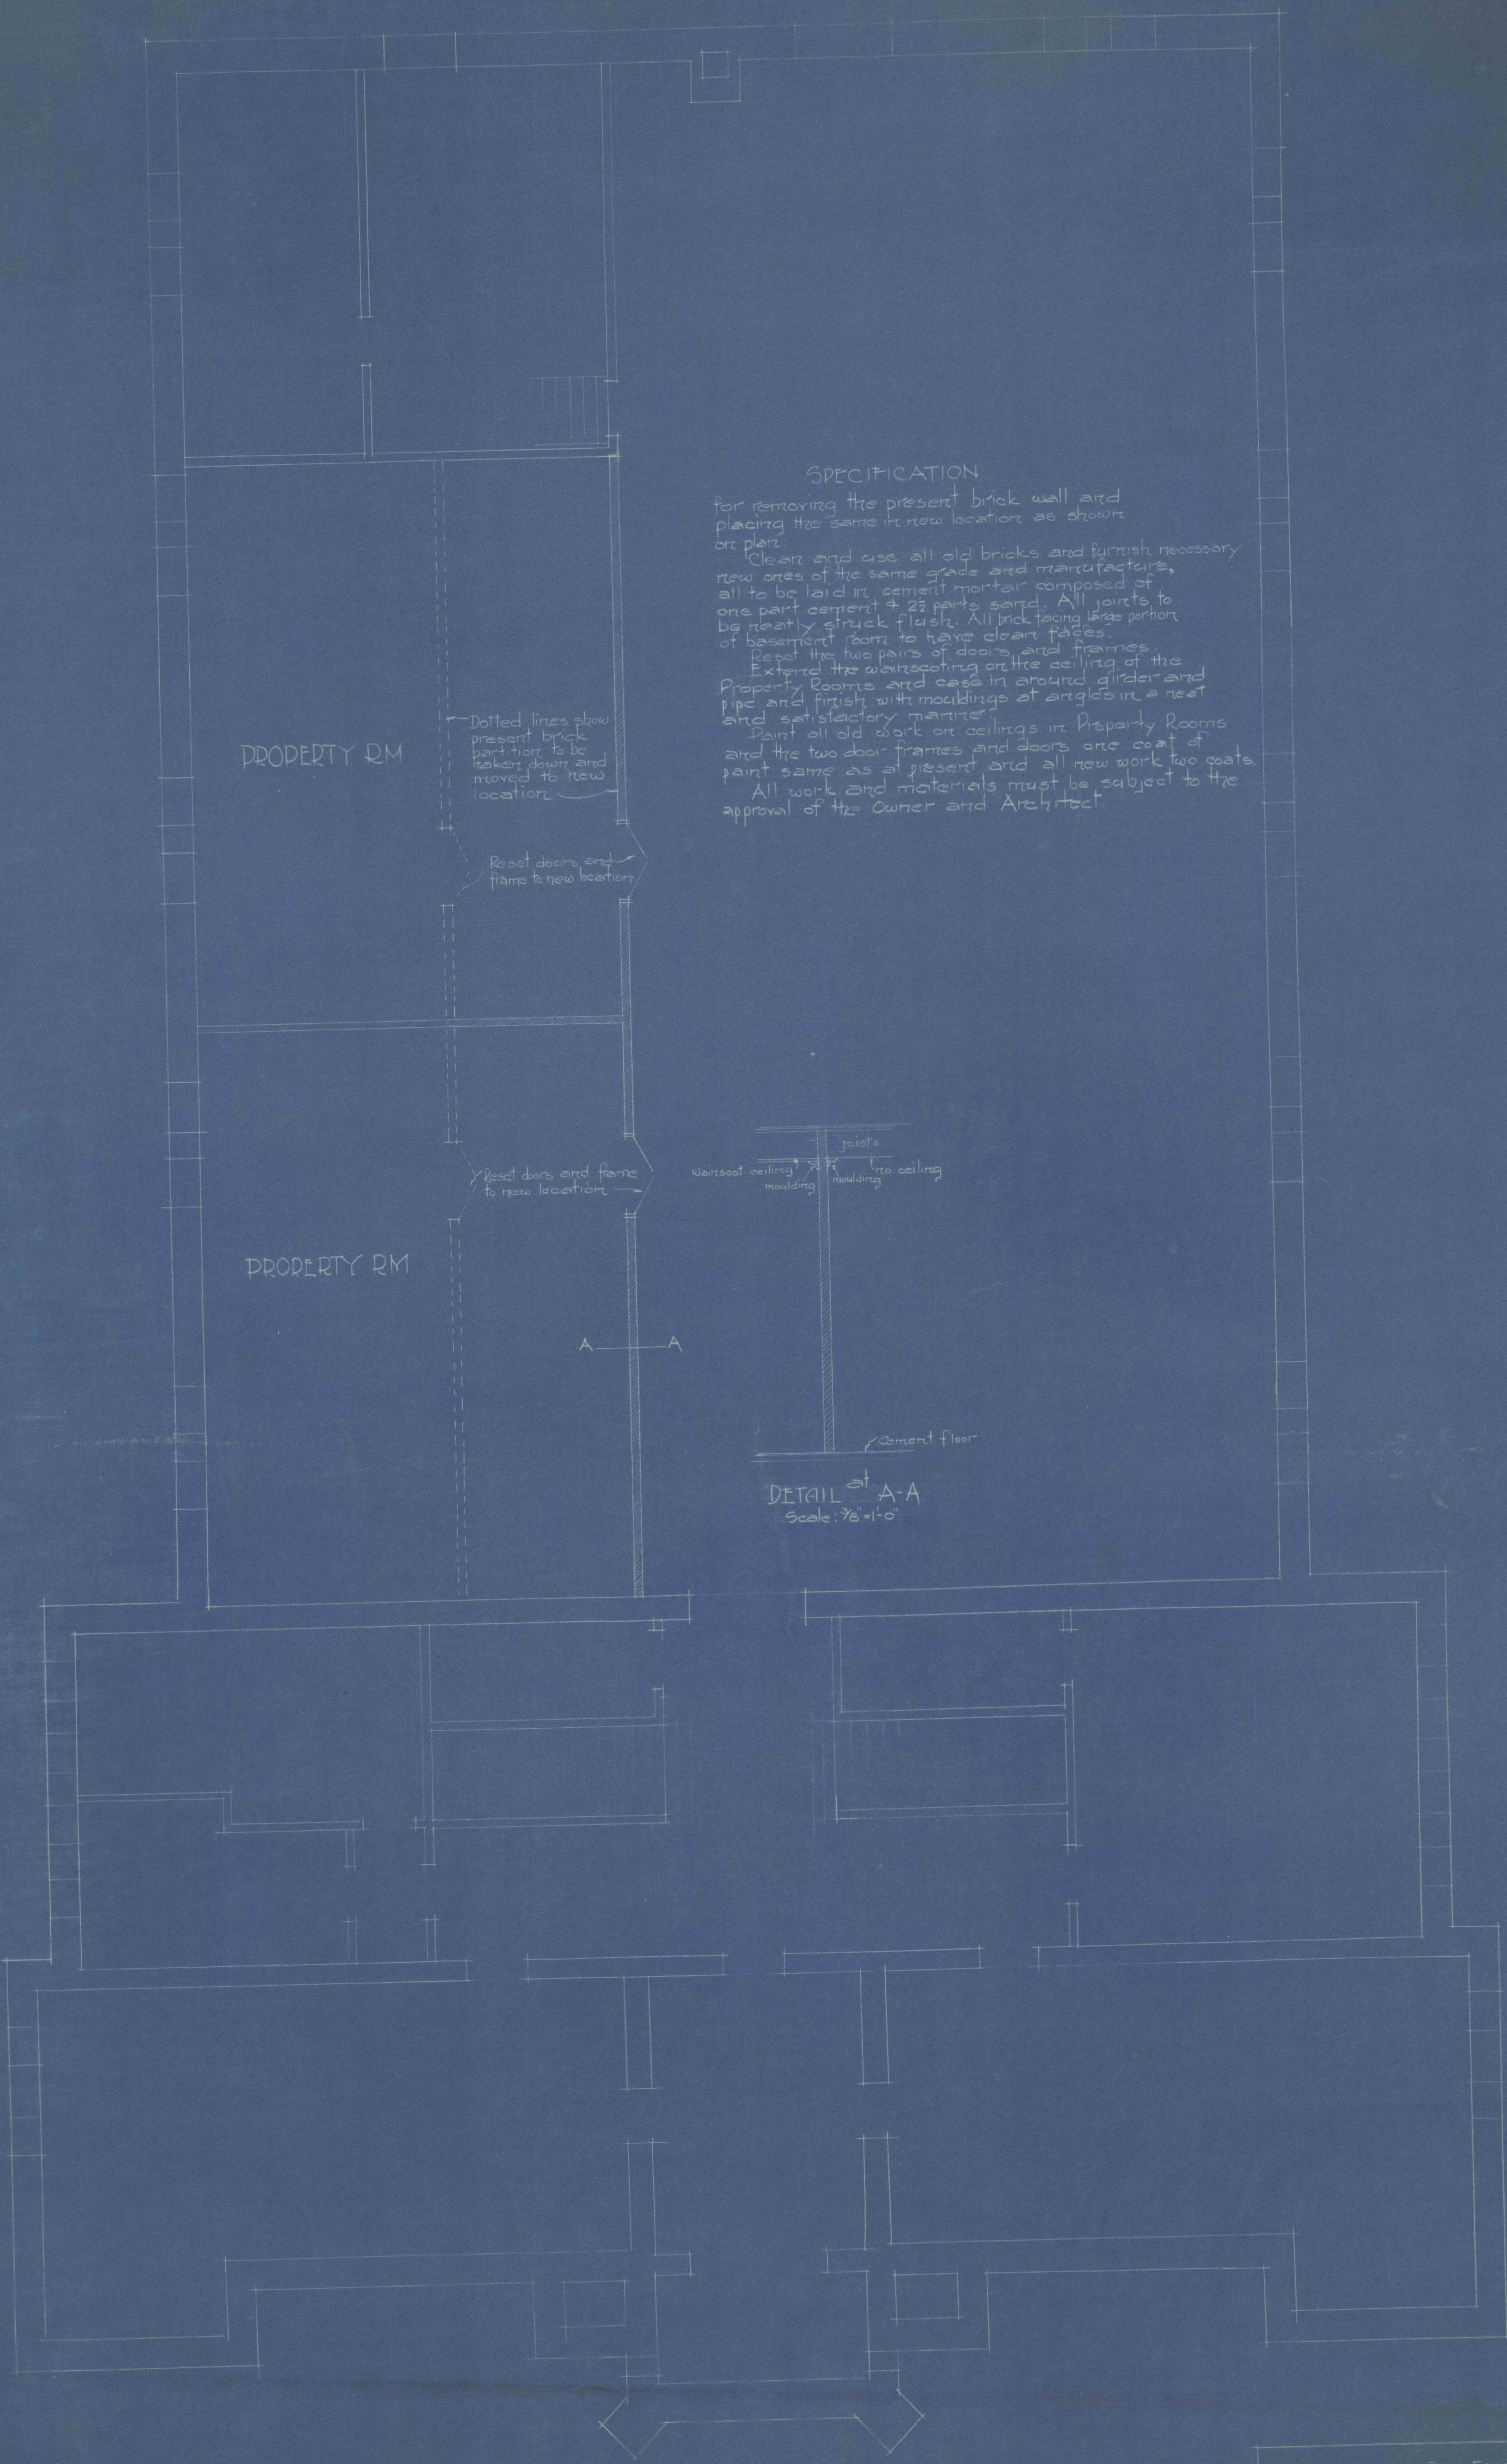

SPECIFICATION

for removing the present brick wall and placing the same in new location as shown on plan.

Clear and use all old bricks and furnish necessary new ones of the same grade and manufacture, all to be laid in cement mortar composed of one part cement & 2 1/2 parts sand. All joints to be neatly struck flush. All brick facing large portion of basement room to have clean faces.

Reset the two pairs of doors and frames. Extend the wainscoting on the ceiling of the Property Rooms and ease in around girder and pipe and finish with mouldings at angles in a neat and satisfactory manner.

Paint all old work on ceilings in Property Rooms and the two door frames and doors one coat of paint same as at present and all new work two coats.

All work and materials must be subject to the approval of the Owner and Architect.

Dotted lines show present brick partition to be taken down and moved to new location

Reset doors and frame to new location

Reset doors and frame to new location

joists
wainscot ceiling
moulding
no ceiling
moulding

Cement floor

DETAIL at A-A
Scale: 3/8"=1'-0"

ARMORY FOR THE
COMMONWEALTH OF PA.
AT POTTSVILLE, PA.

BASEMENT PLAN
SHOWING ADDITION TO PROPERTY ROOMS.

Scale: 1/4"=1'-0"

McCORMICK and FRENCH, Architects
Wilkes-Barre, Penna.
Revision made by
FRANK X. REILLY, Archt.
Pottsville, Penna.