ORCHARD VEIN

PACKER COLLIERY No. 4

LEHIGH VALLEY COAL CO.

SCALE 1 INCH = 100 FT.
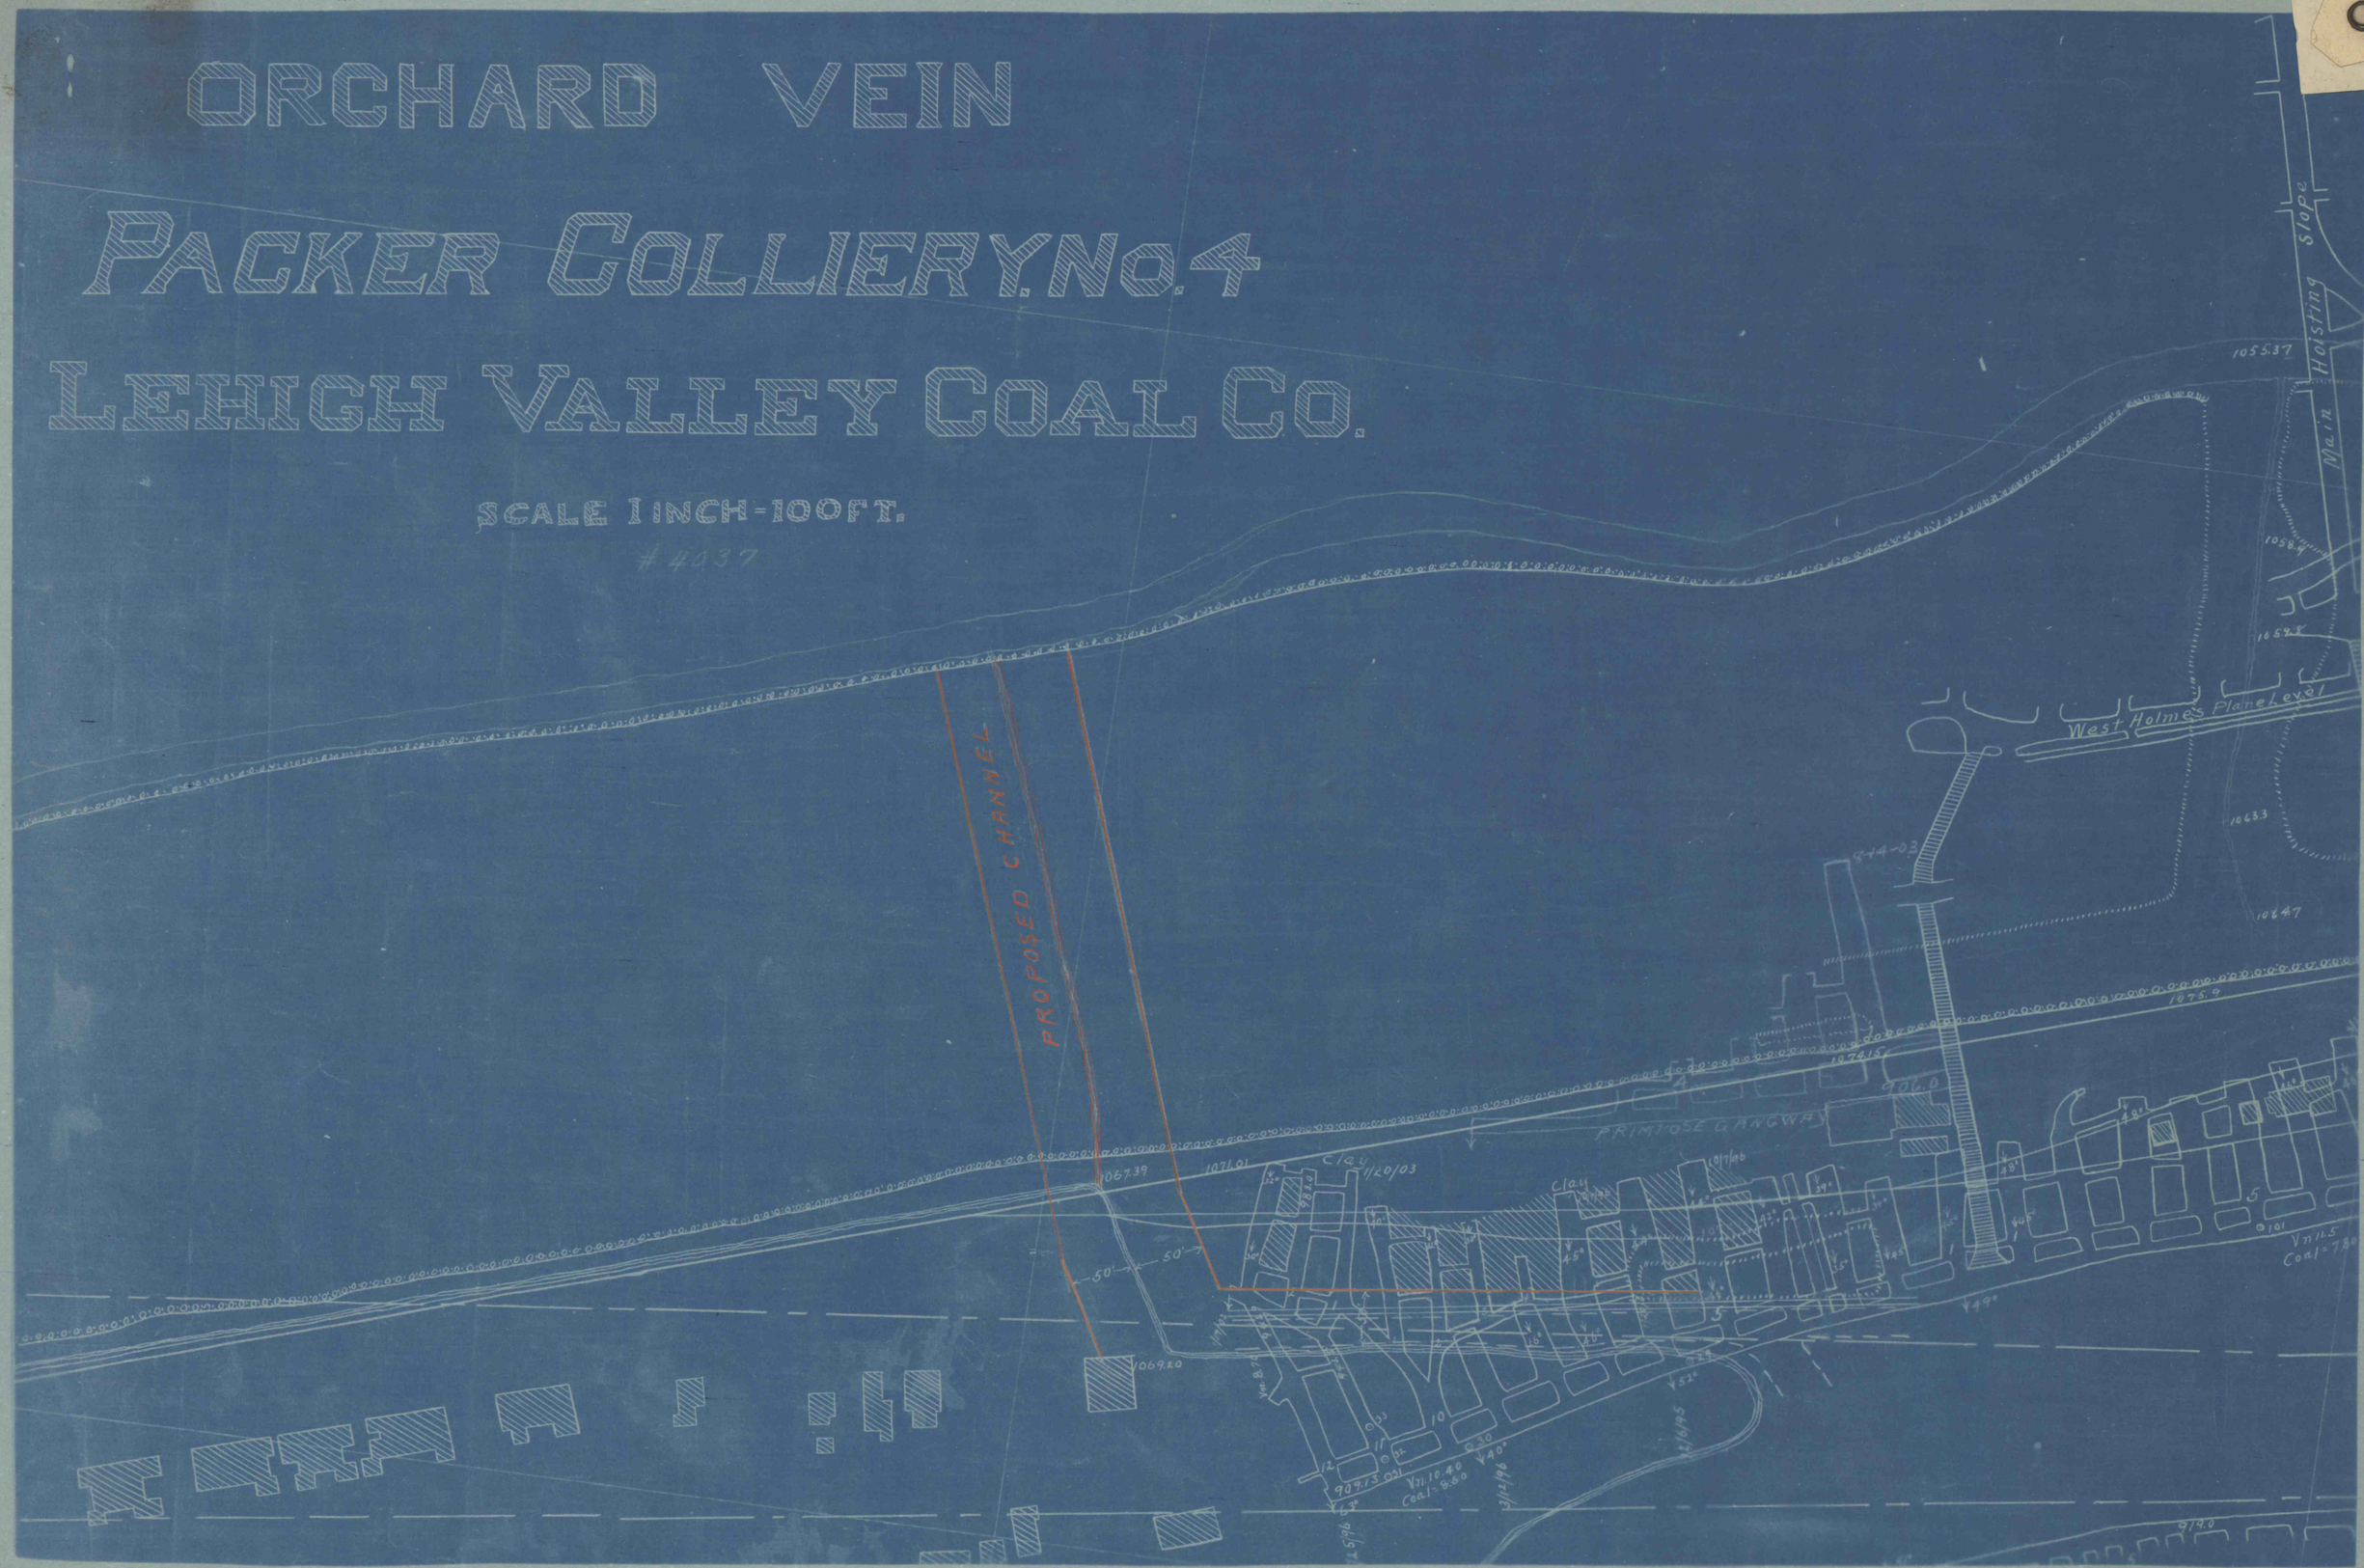
#4037