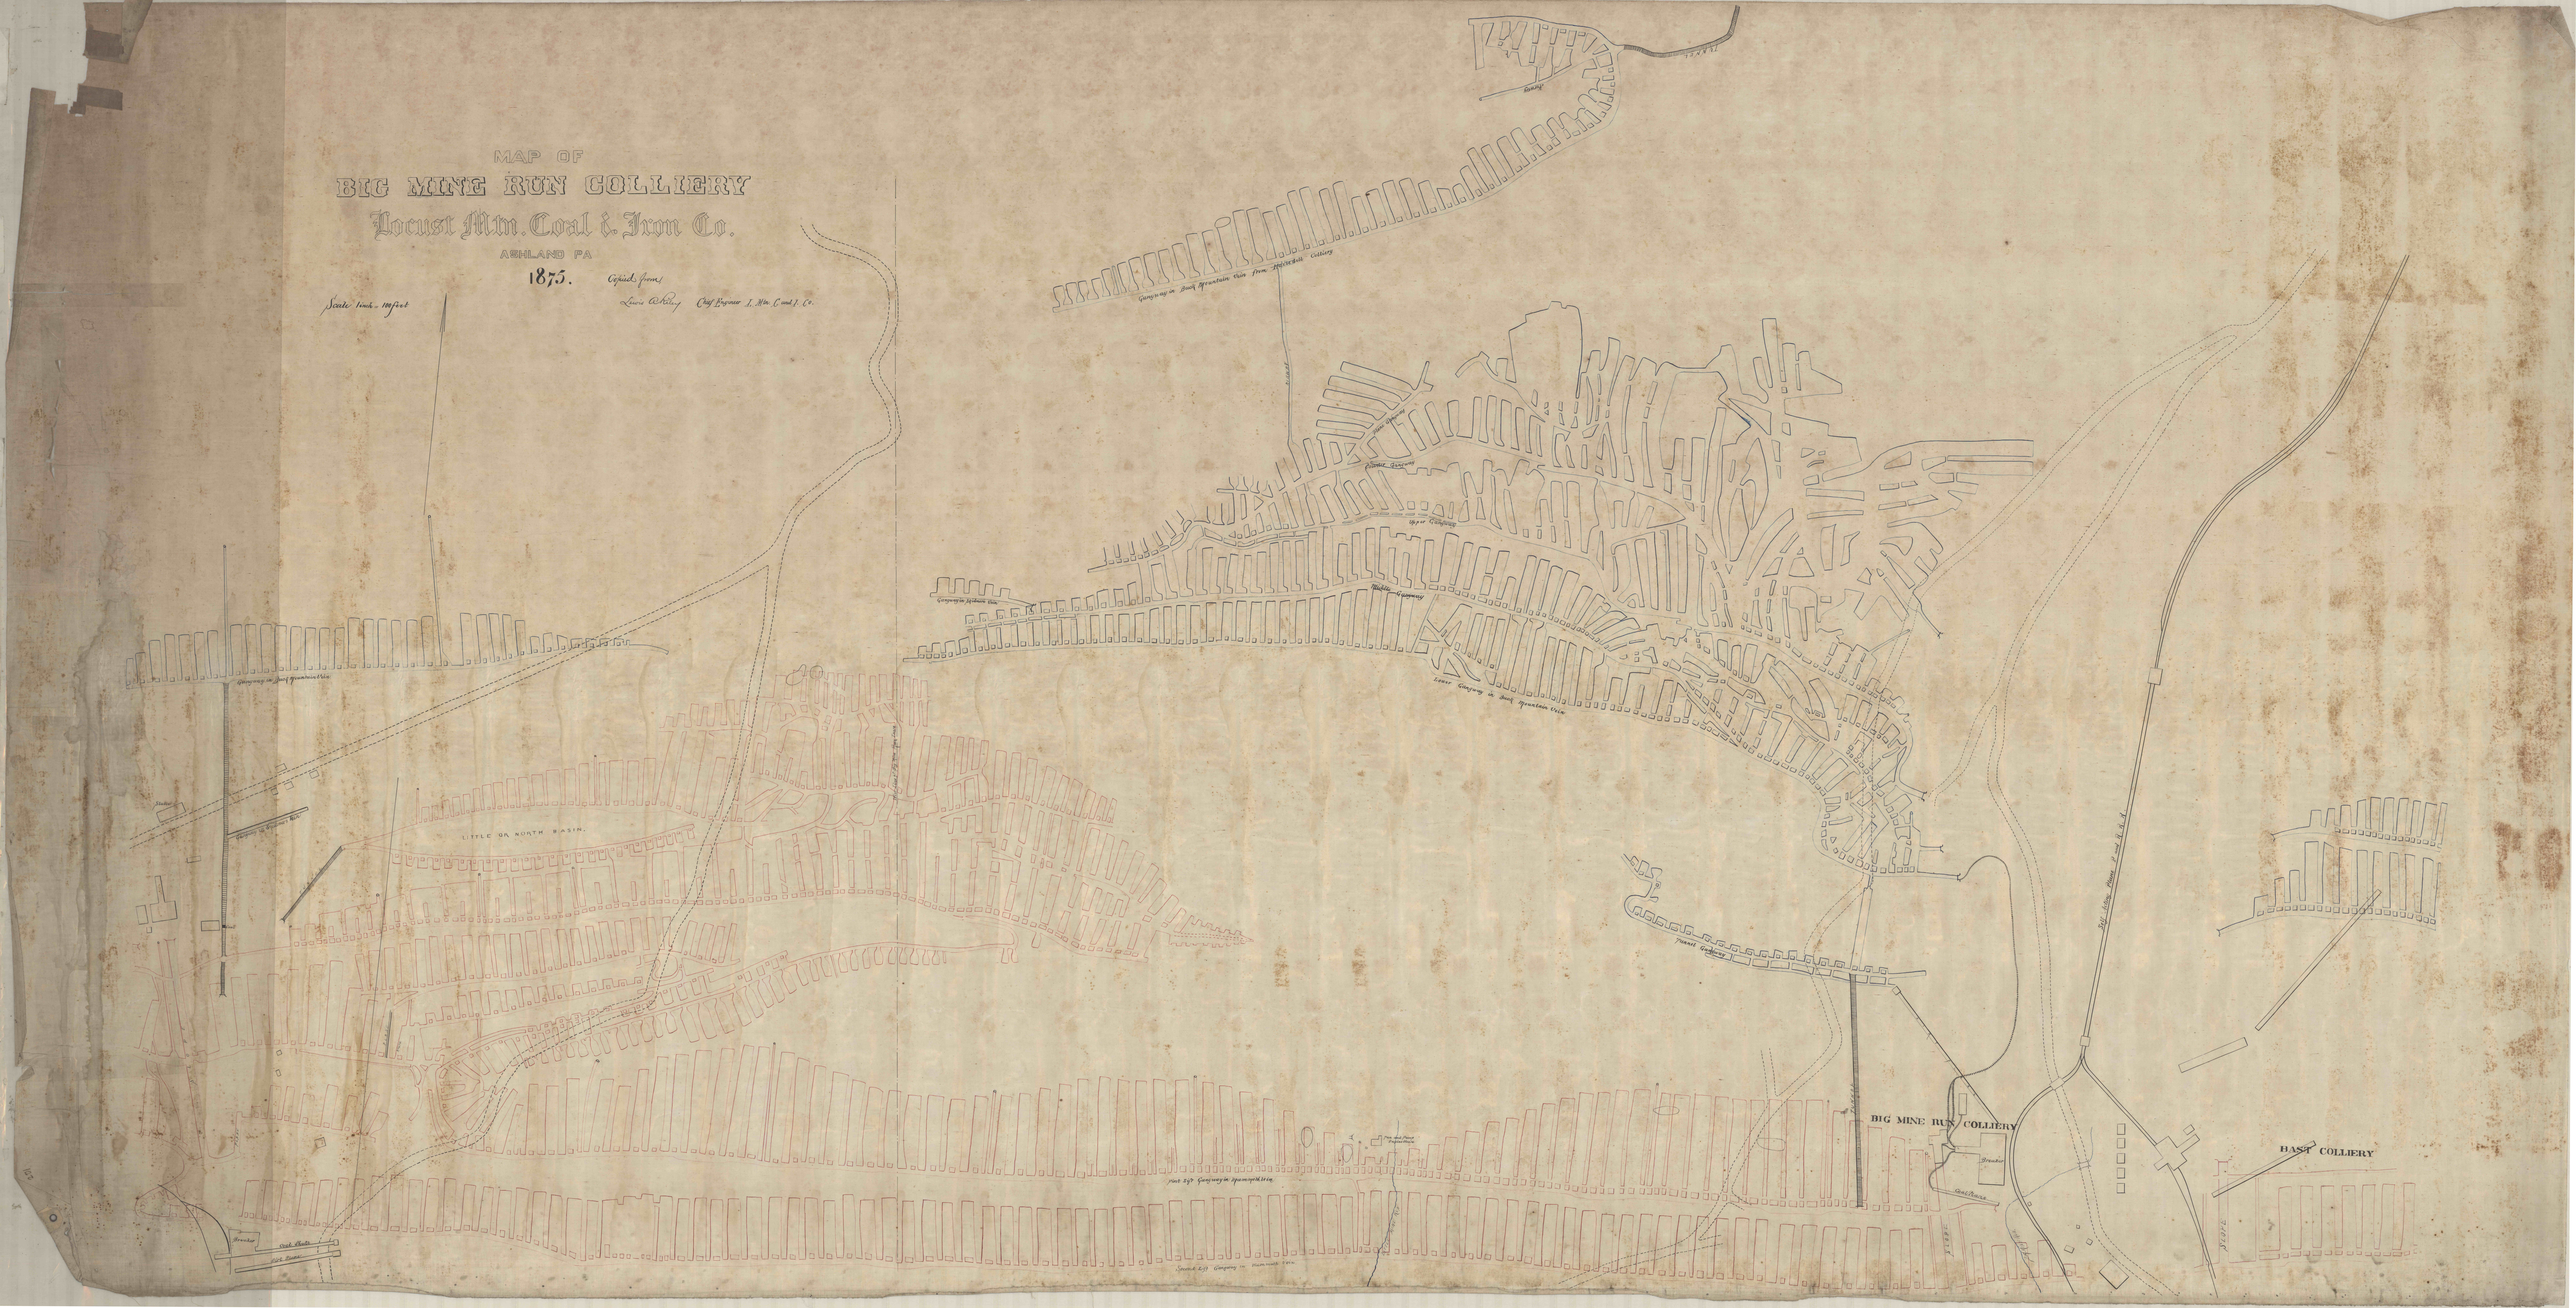

MAP OF
BIG MINE RUN COLLIERY
Locust Mtn. Coal & Iron Co.
ASHLAND PA

1875.

Copied from, Lewis A. Riley Chief Engineer L. Mtn. C and I. Co.

Scale 1 inch = 100 feet

Tunnel
Airway
Gangway in Buck Mountain Vein from ~~Hazledell~~ Colliery
Airway
Plane Gangway
Counter Gangway
Upper Gangway
Gangway in Skidmore Vein
Middle Gangway
Lower Gangway in Buck Mountain Vein
Gangway in Buck Mountain Vein
Stable
Gangway in Skidmore Vein
Tunnel
LITTLE OR NORTH BASIN
Plane
Tunnel Gangway
Dirt
Self Acting Plane P and R. R. R.
Fan and Pump Engine House
First Lift Gangway in Mammoth Vein
Second Lift Gangway in Mammoth Vein
Little Mine Run
Tunnel
BIG MINE RUN COLLIERY
Plane
Breaker
Coal Plane
Slope
Big Mine Run
BAST COLLIERY
Slope
Breaker
Coal Shute
Dirt Plane