BORE HOLE No. 1.

on the

Broad Mountain Lands

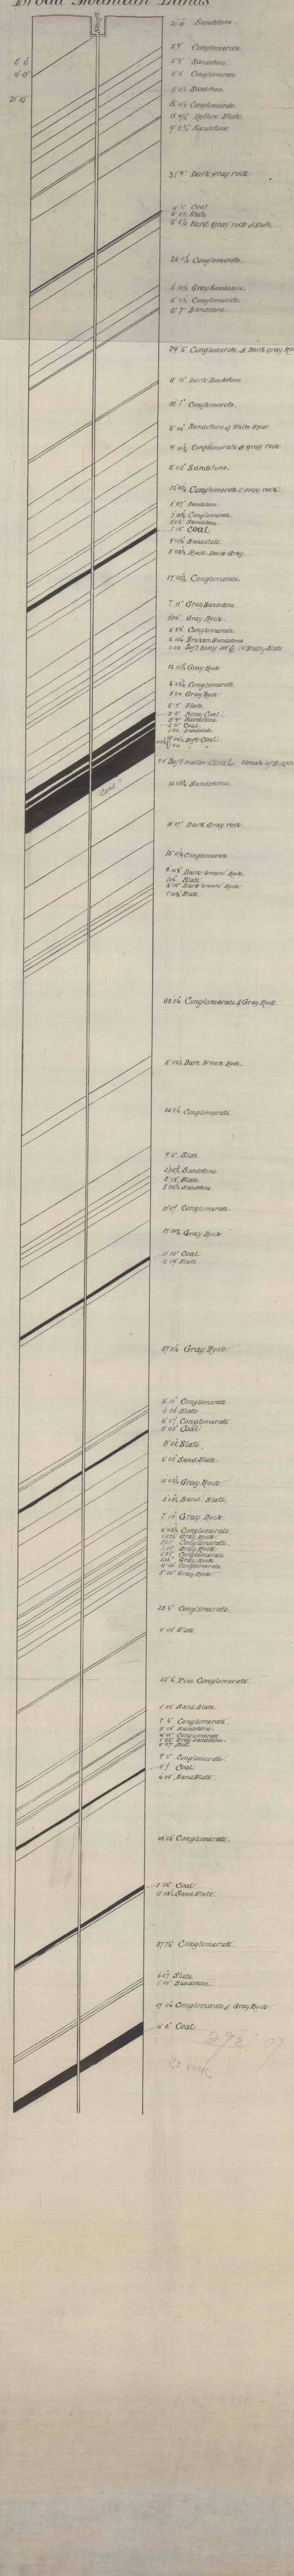

BORE HOLE No. 2.

on the

Broad Mountain Lands

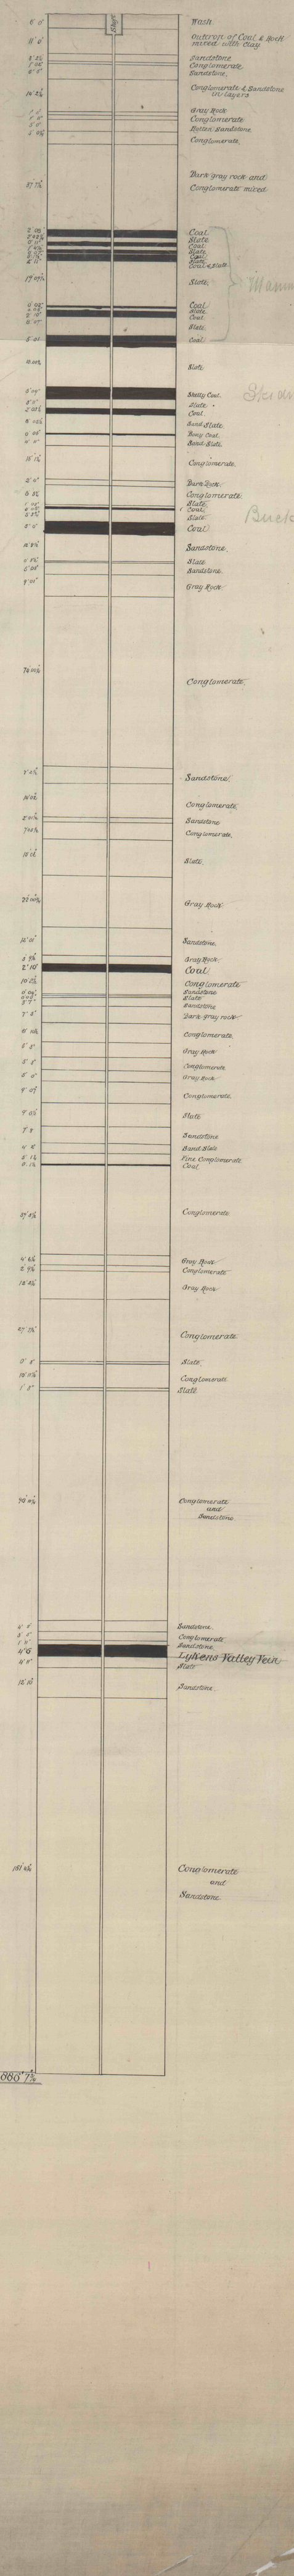

TOTAL DEPTH. 886' 7½