


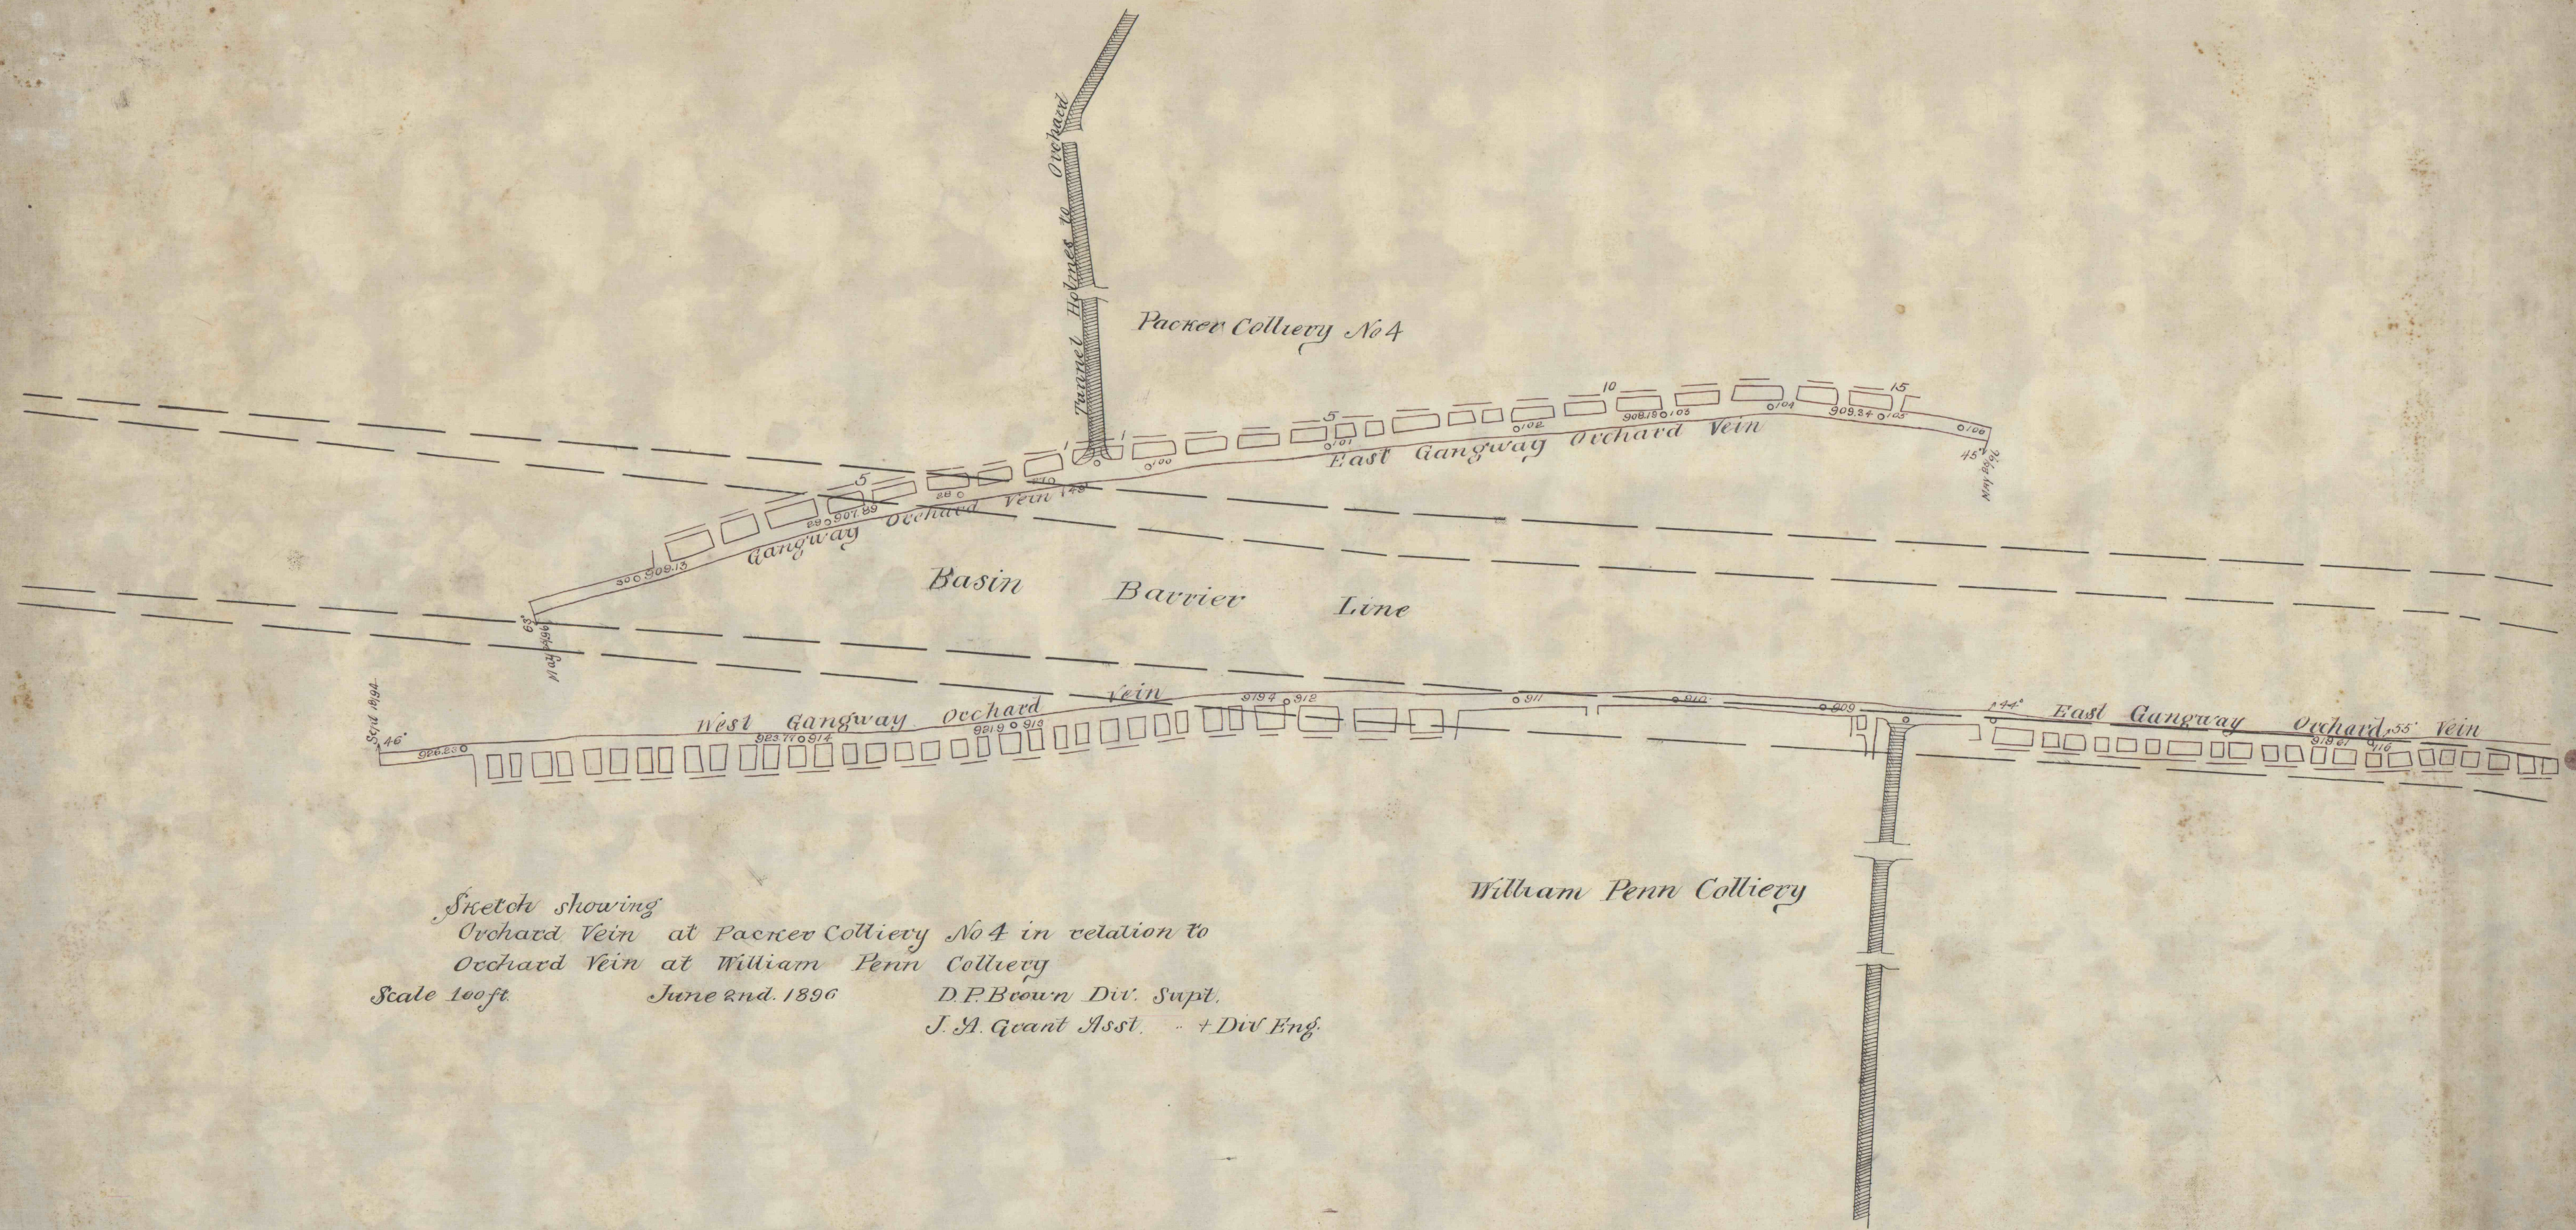

Sketch showing
Orchard Vein at Packer Colliery No 4 in relation to
Orchard Vein at William Penn Colliery
Scale 100 ft. June 2nd. 1896 D.P. Brown Div. Supt.
J. A. Grant Asst. + Div Eng.

William Penn Colliery