


Scale 100 feet to an Inch

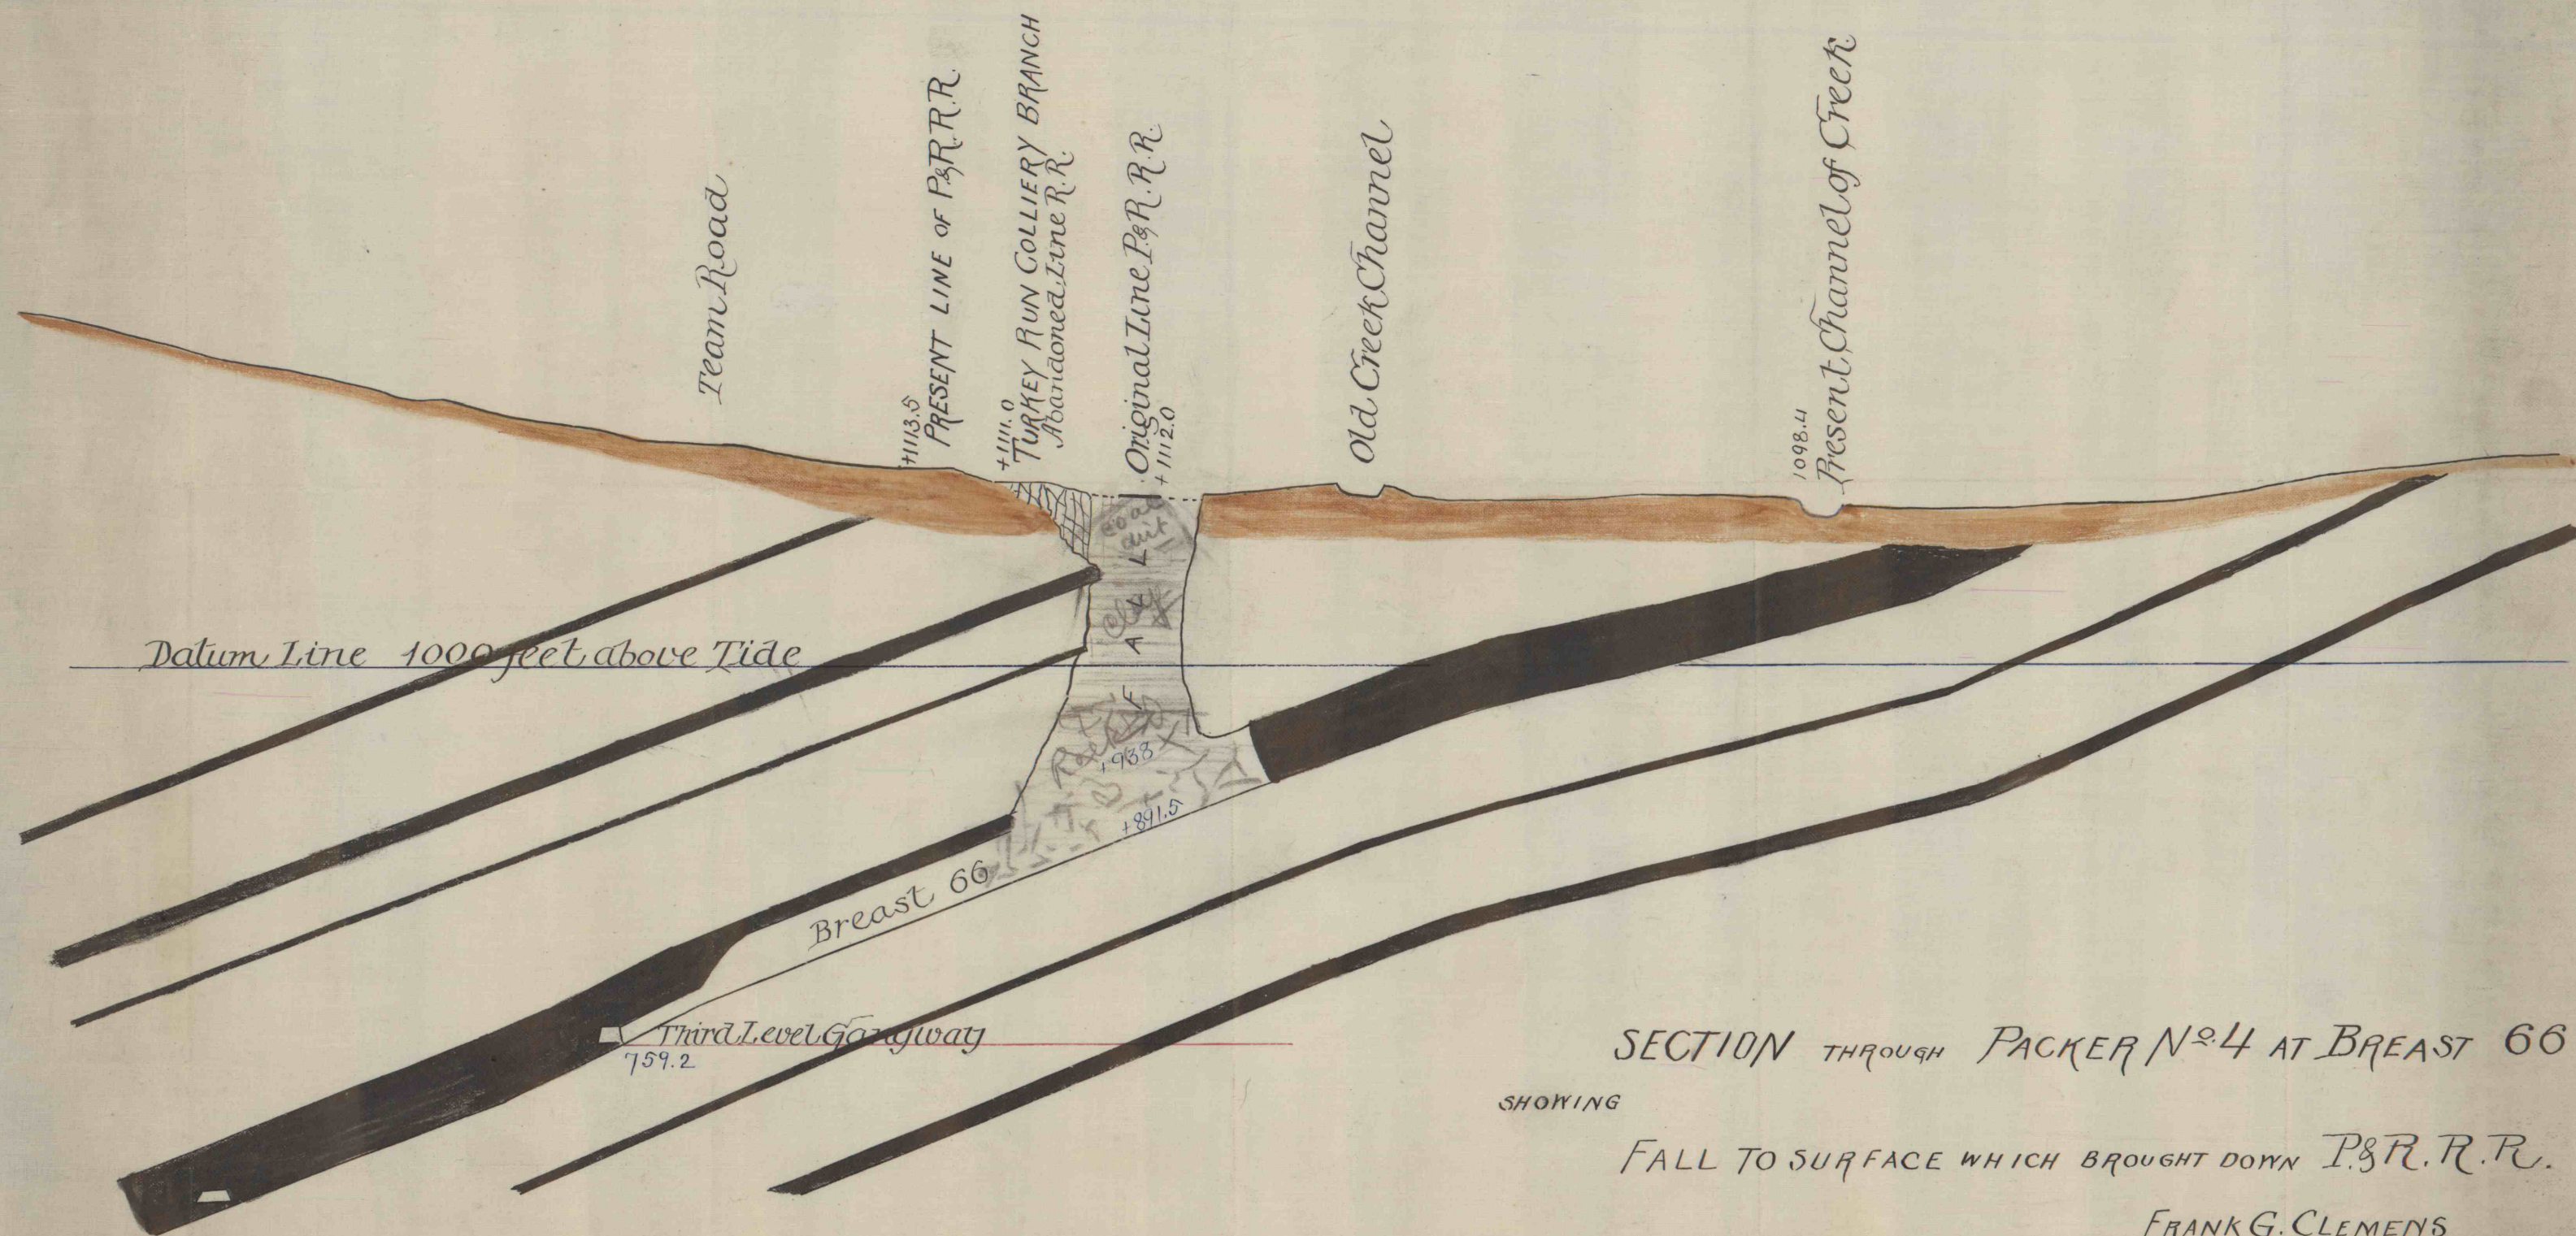

SECTION THROUGH PACKER N^o 4 AT BREAST 66

SHOWING

FALL TO SURFACE WHICH BROUGHT DOWN P&R.R.R.

FRANK G. CLEMENS,
ENG. L. V. C. Co