


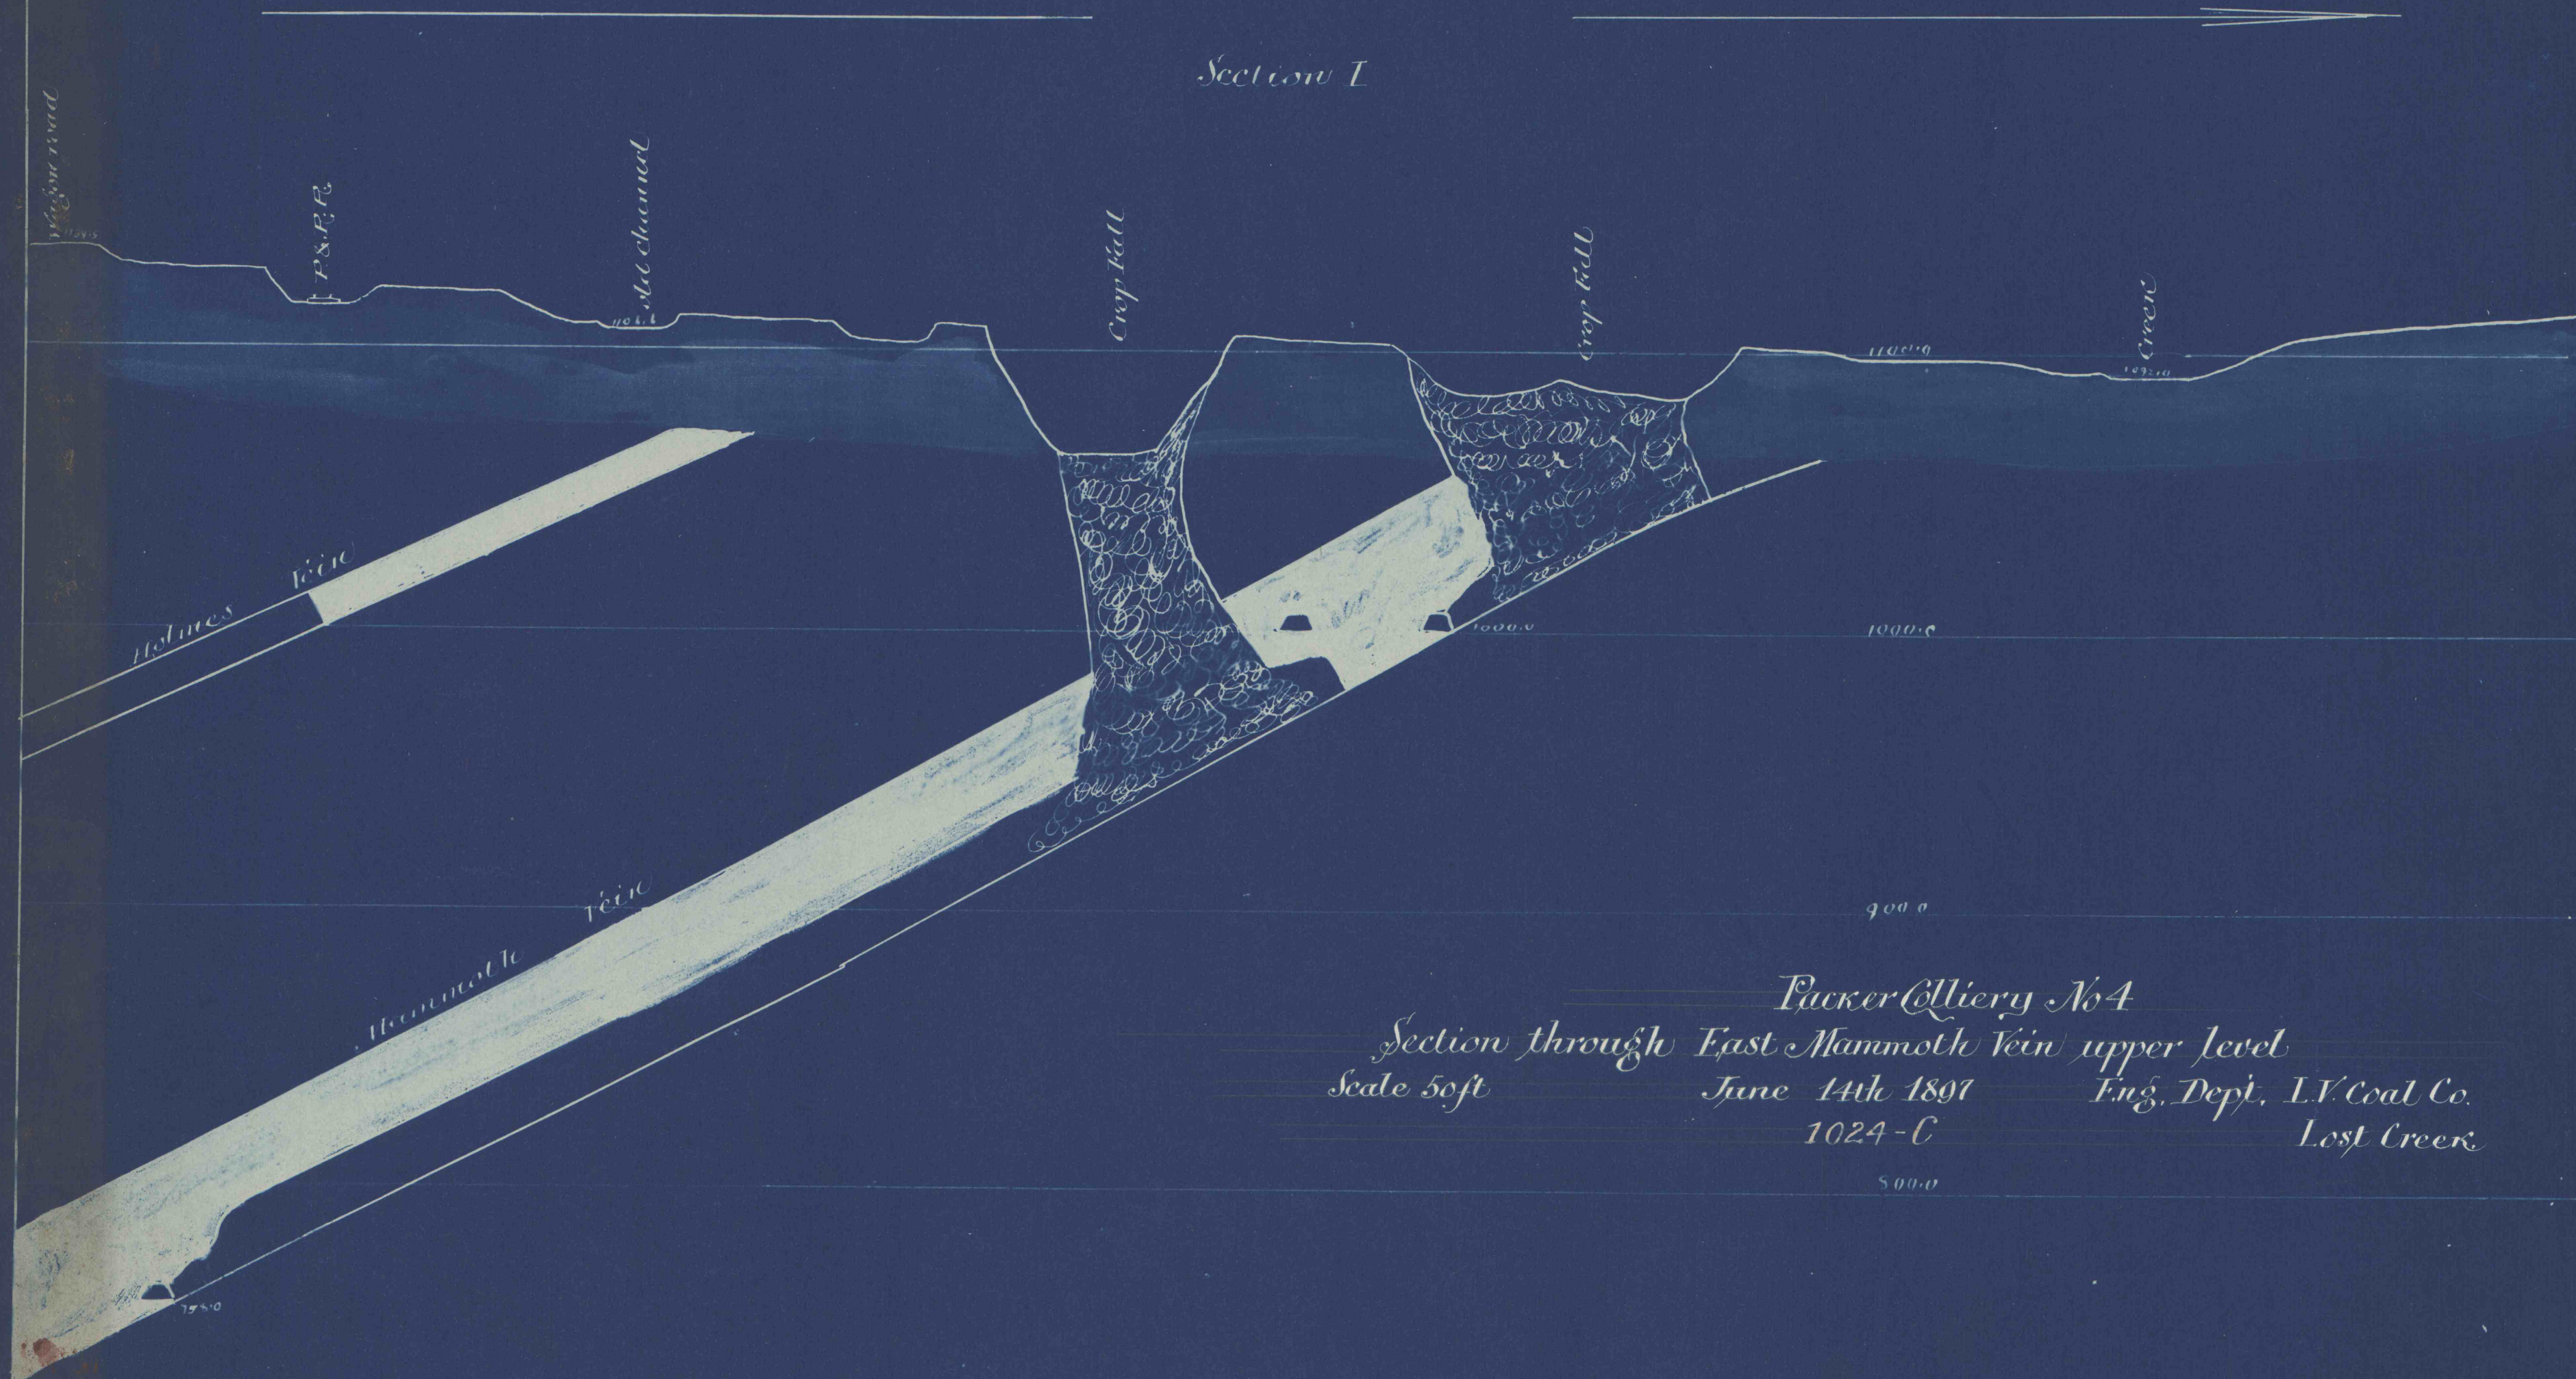

Packer Colliery No 4
Section through East Mammoth Vein upper level
Scale 50ft *June 14th 1897* *Eng. Dept. L.V. Coal Co.*
1024-C *Lost Creek*
500.0