


Section 3

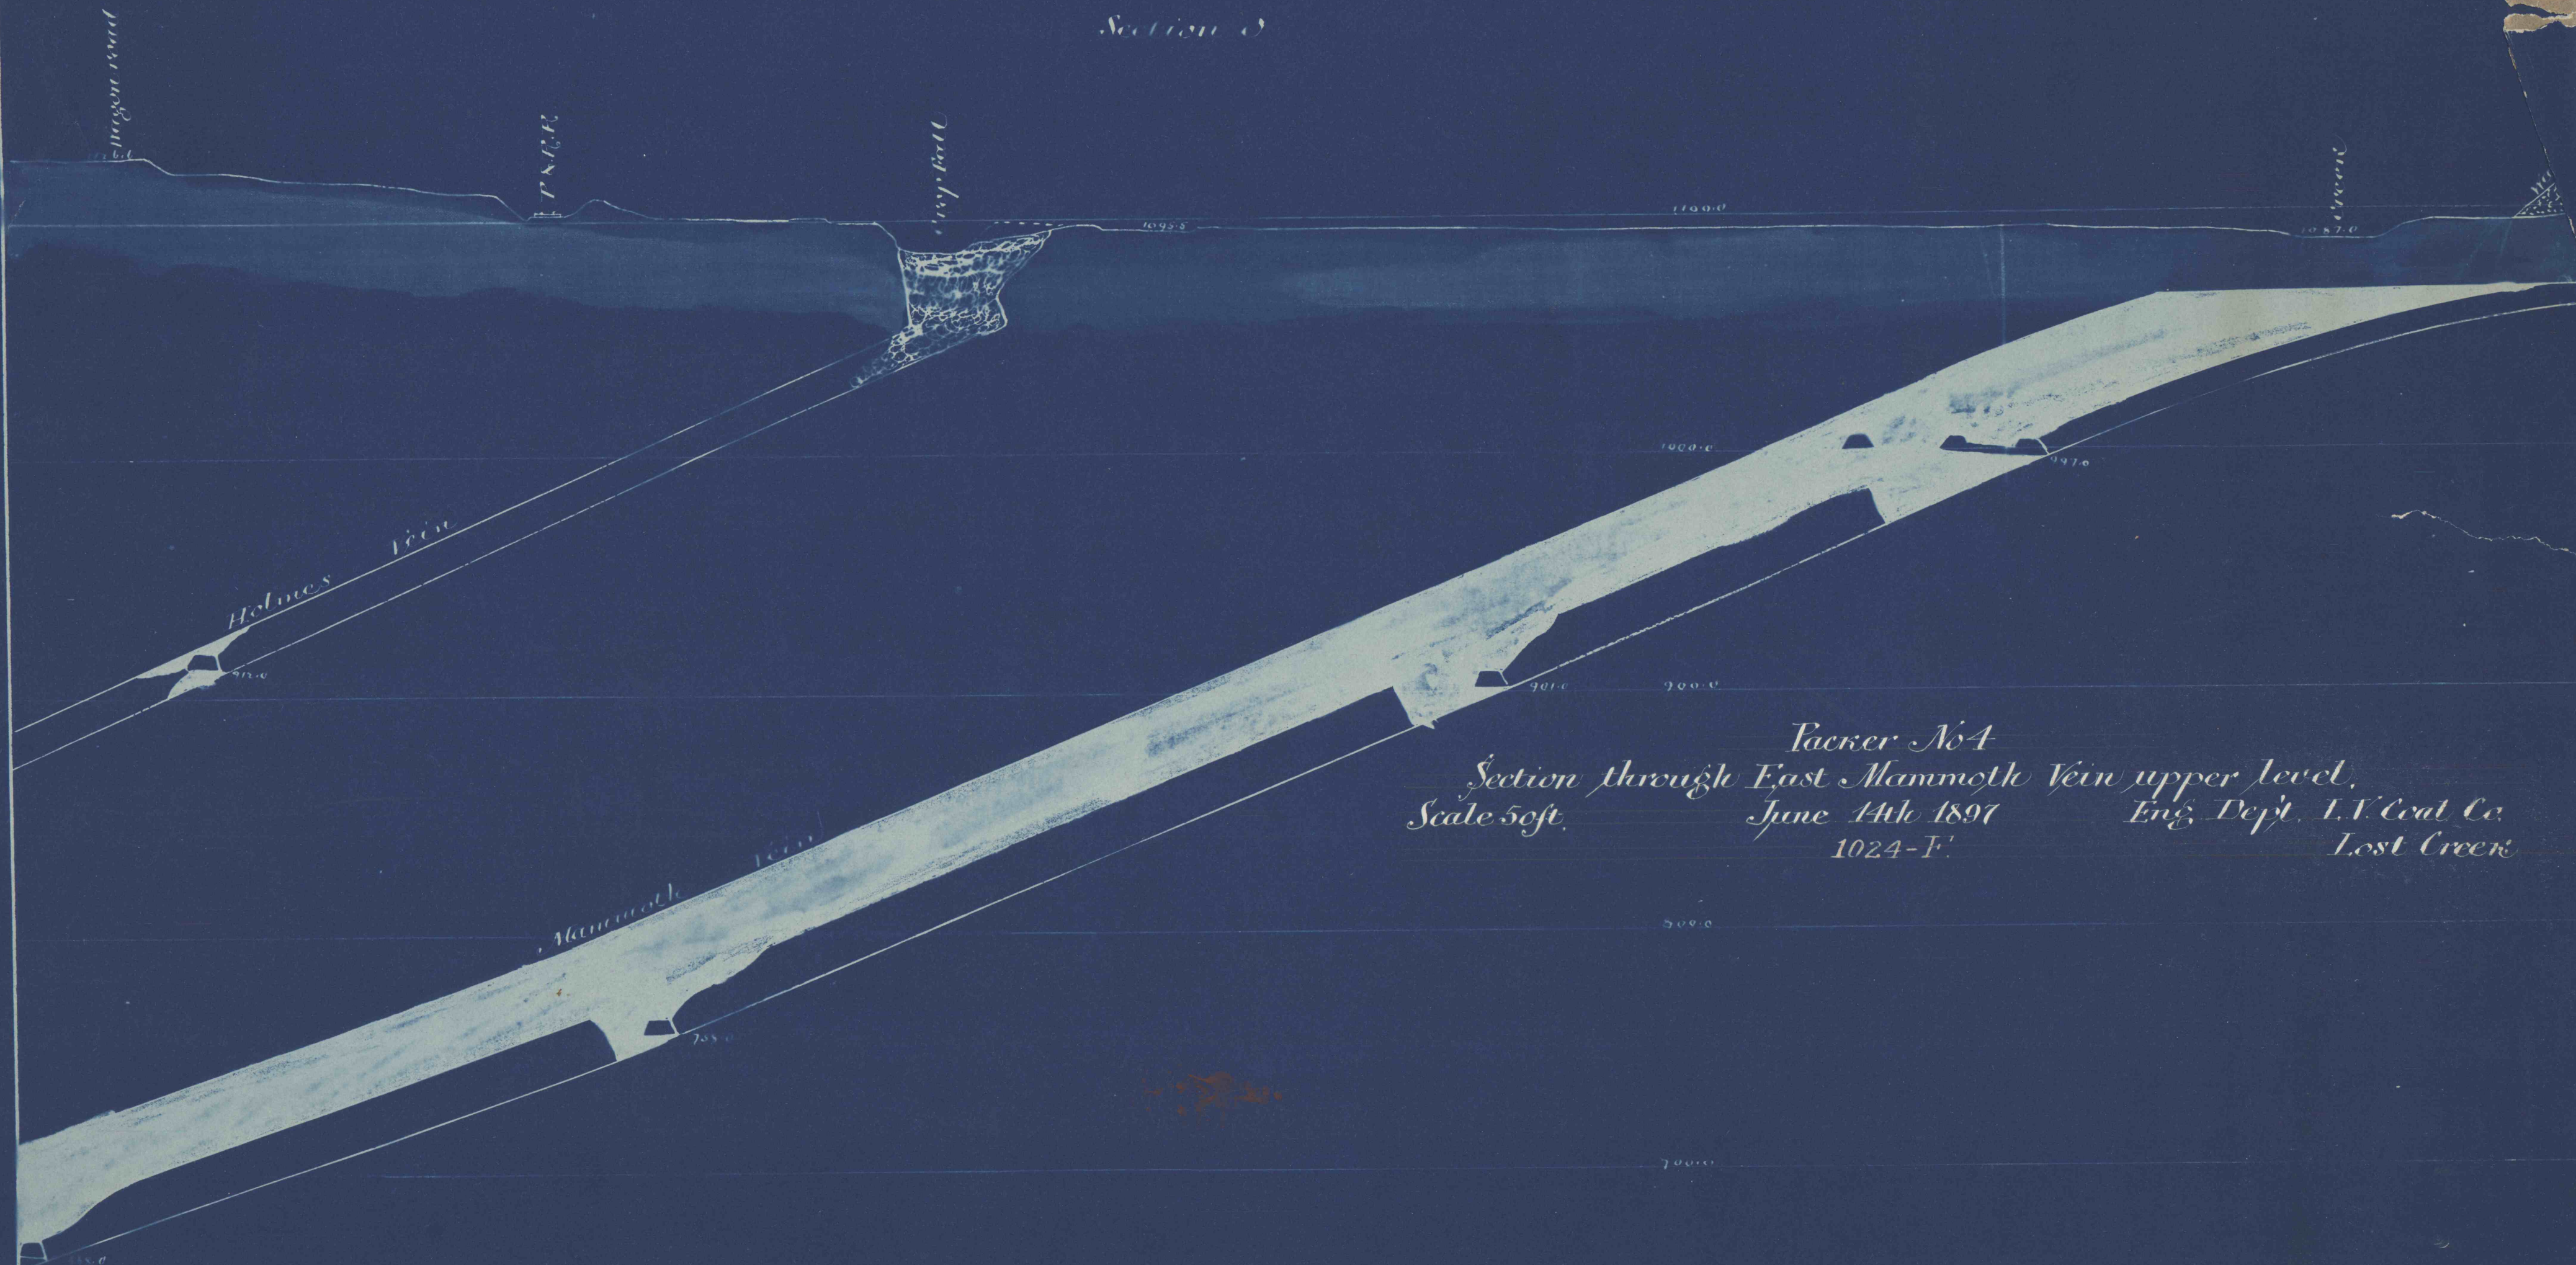

Packer No 4
Section through East Mammoth Vein upper level,
Scale 50ft. June 14th 1897 Eng. Dept. L.V. Coal Co.
1024-F' Lost Creek