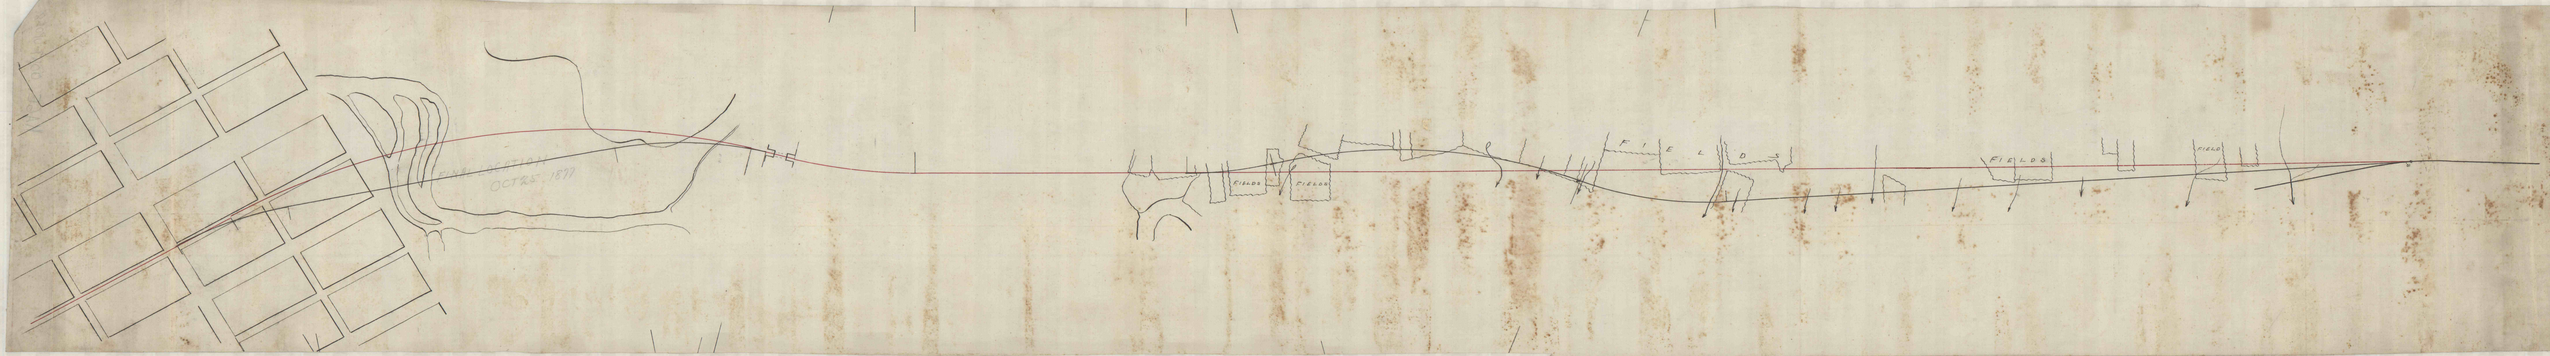
OCT 25 - 1877
FIELDS
FIELDS
F I E L D
FIELDS
FIELD