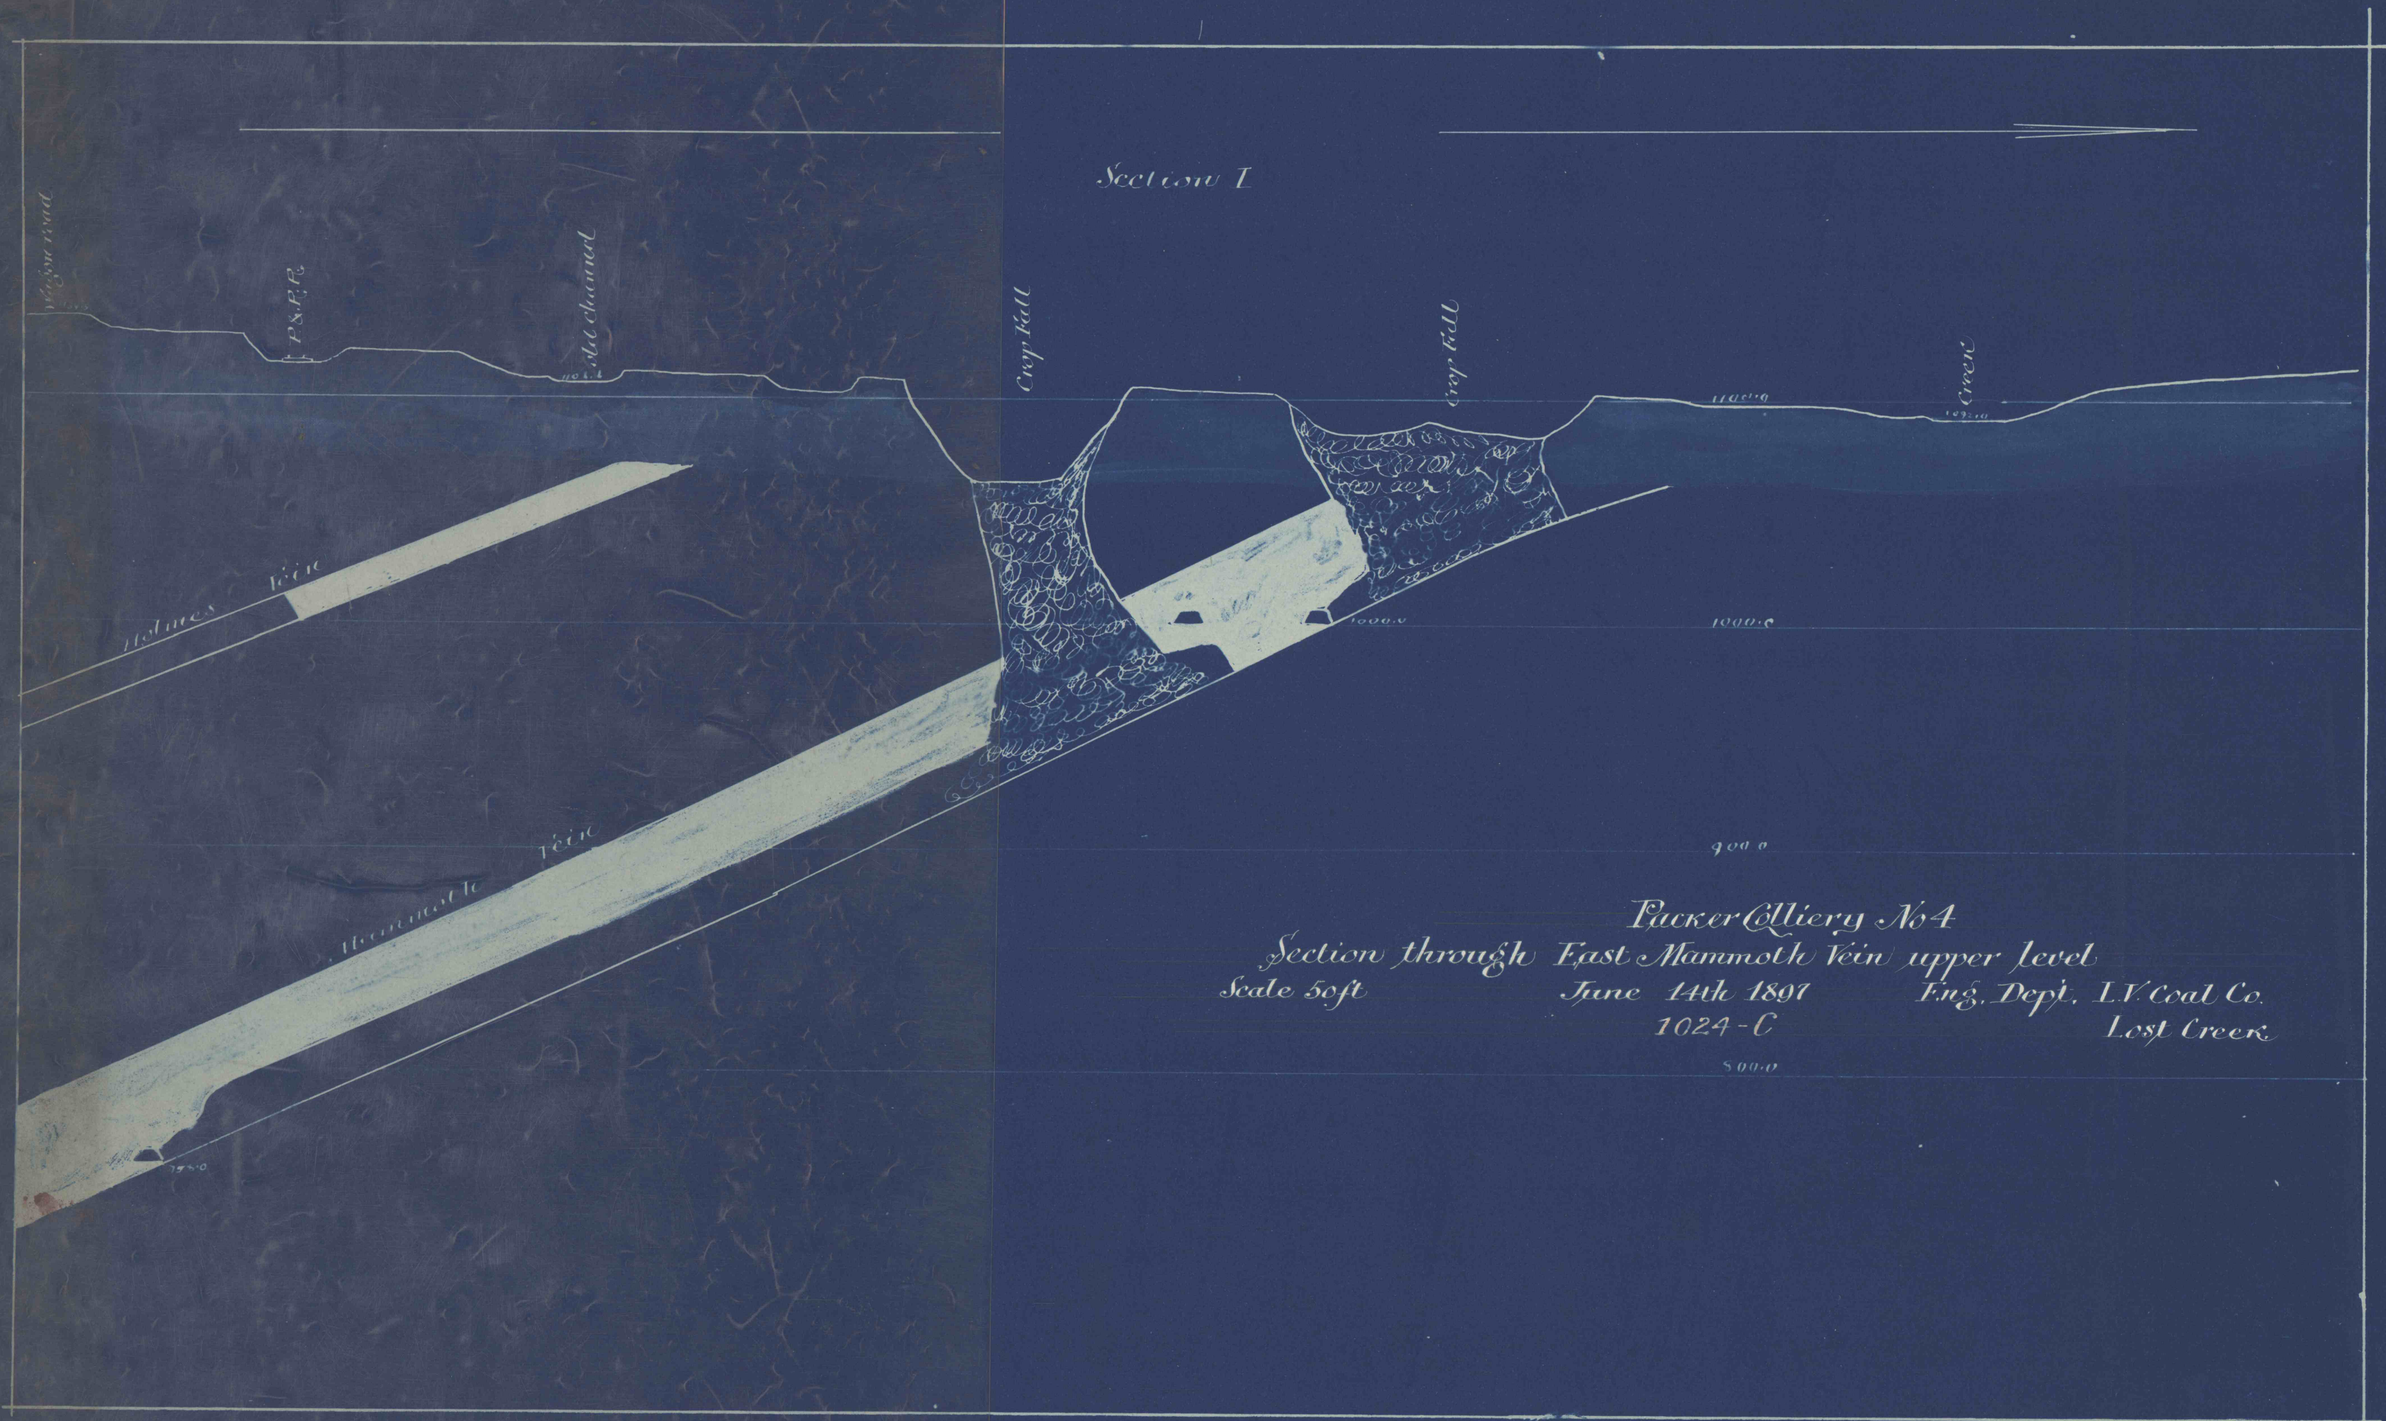


Packer Colliery No 4
Section through East Mammoth Vein upper level
Scale 50ft June 14th 1891 Eng. Dept. L.V. Coal Co.
1024-C Lost Creek