

Section F.

Magnesian

P. & R. F.


Not cleaned

Imp. bed

Crone

Holmes Vein

East Mammoth Vein

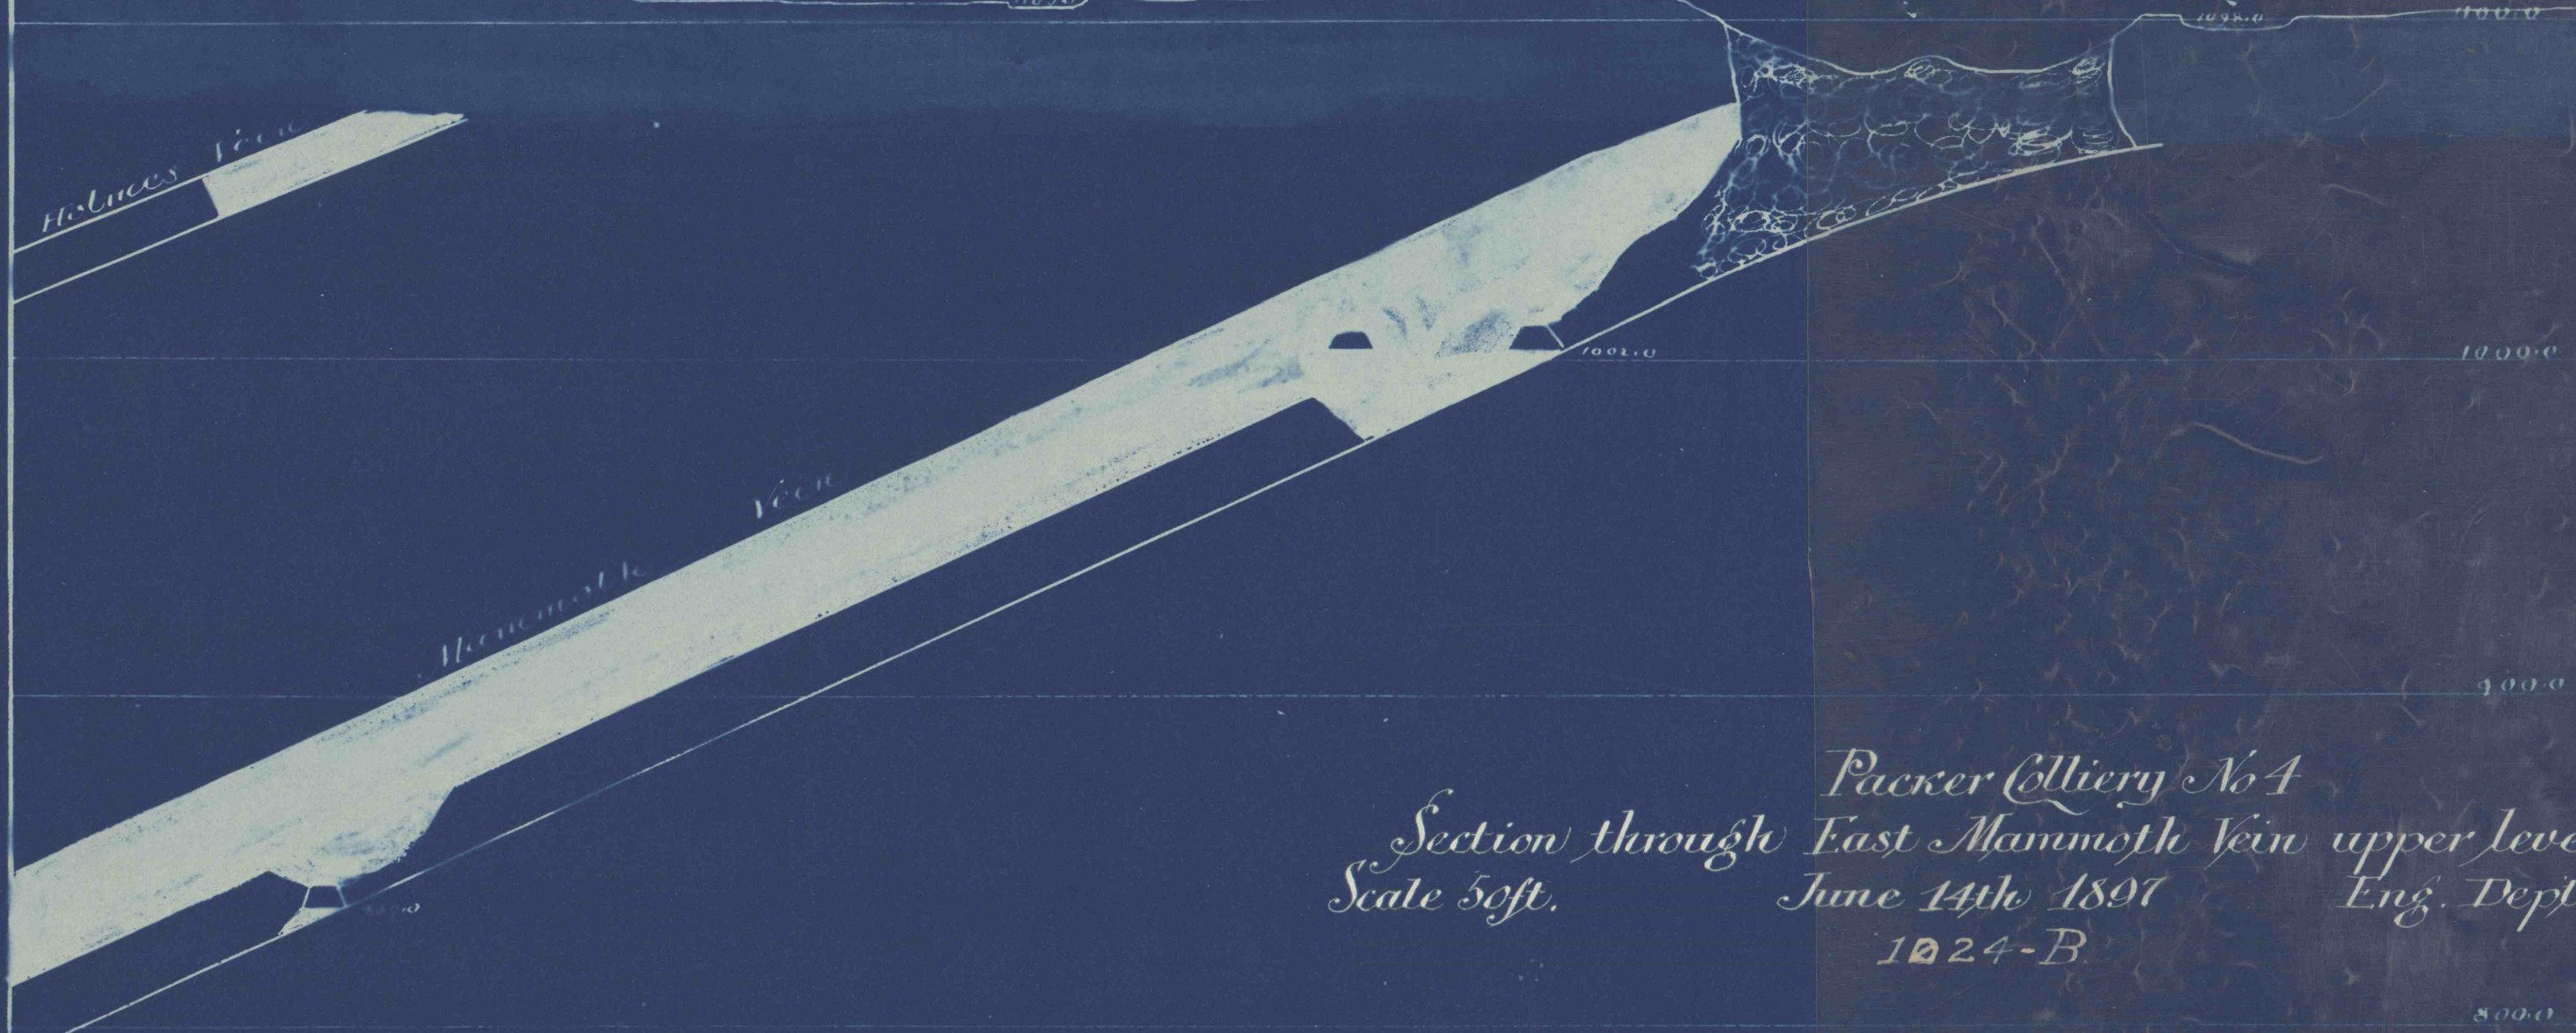

Section through East Mammoth Vein upper level
 Scale 50ft. Packer Colliery No 4
 June 14th 1897 Eng. Dept. L. V. Coal Co.
 1024-B Lost Creek