



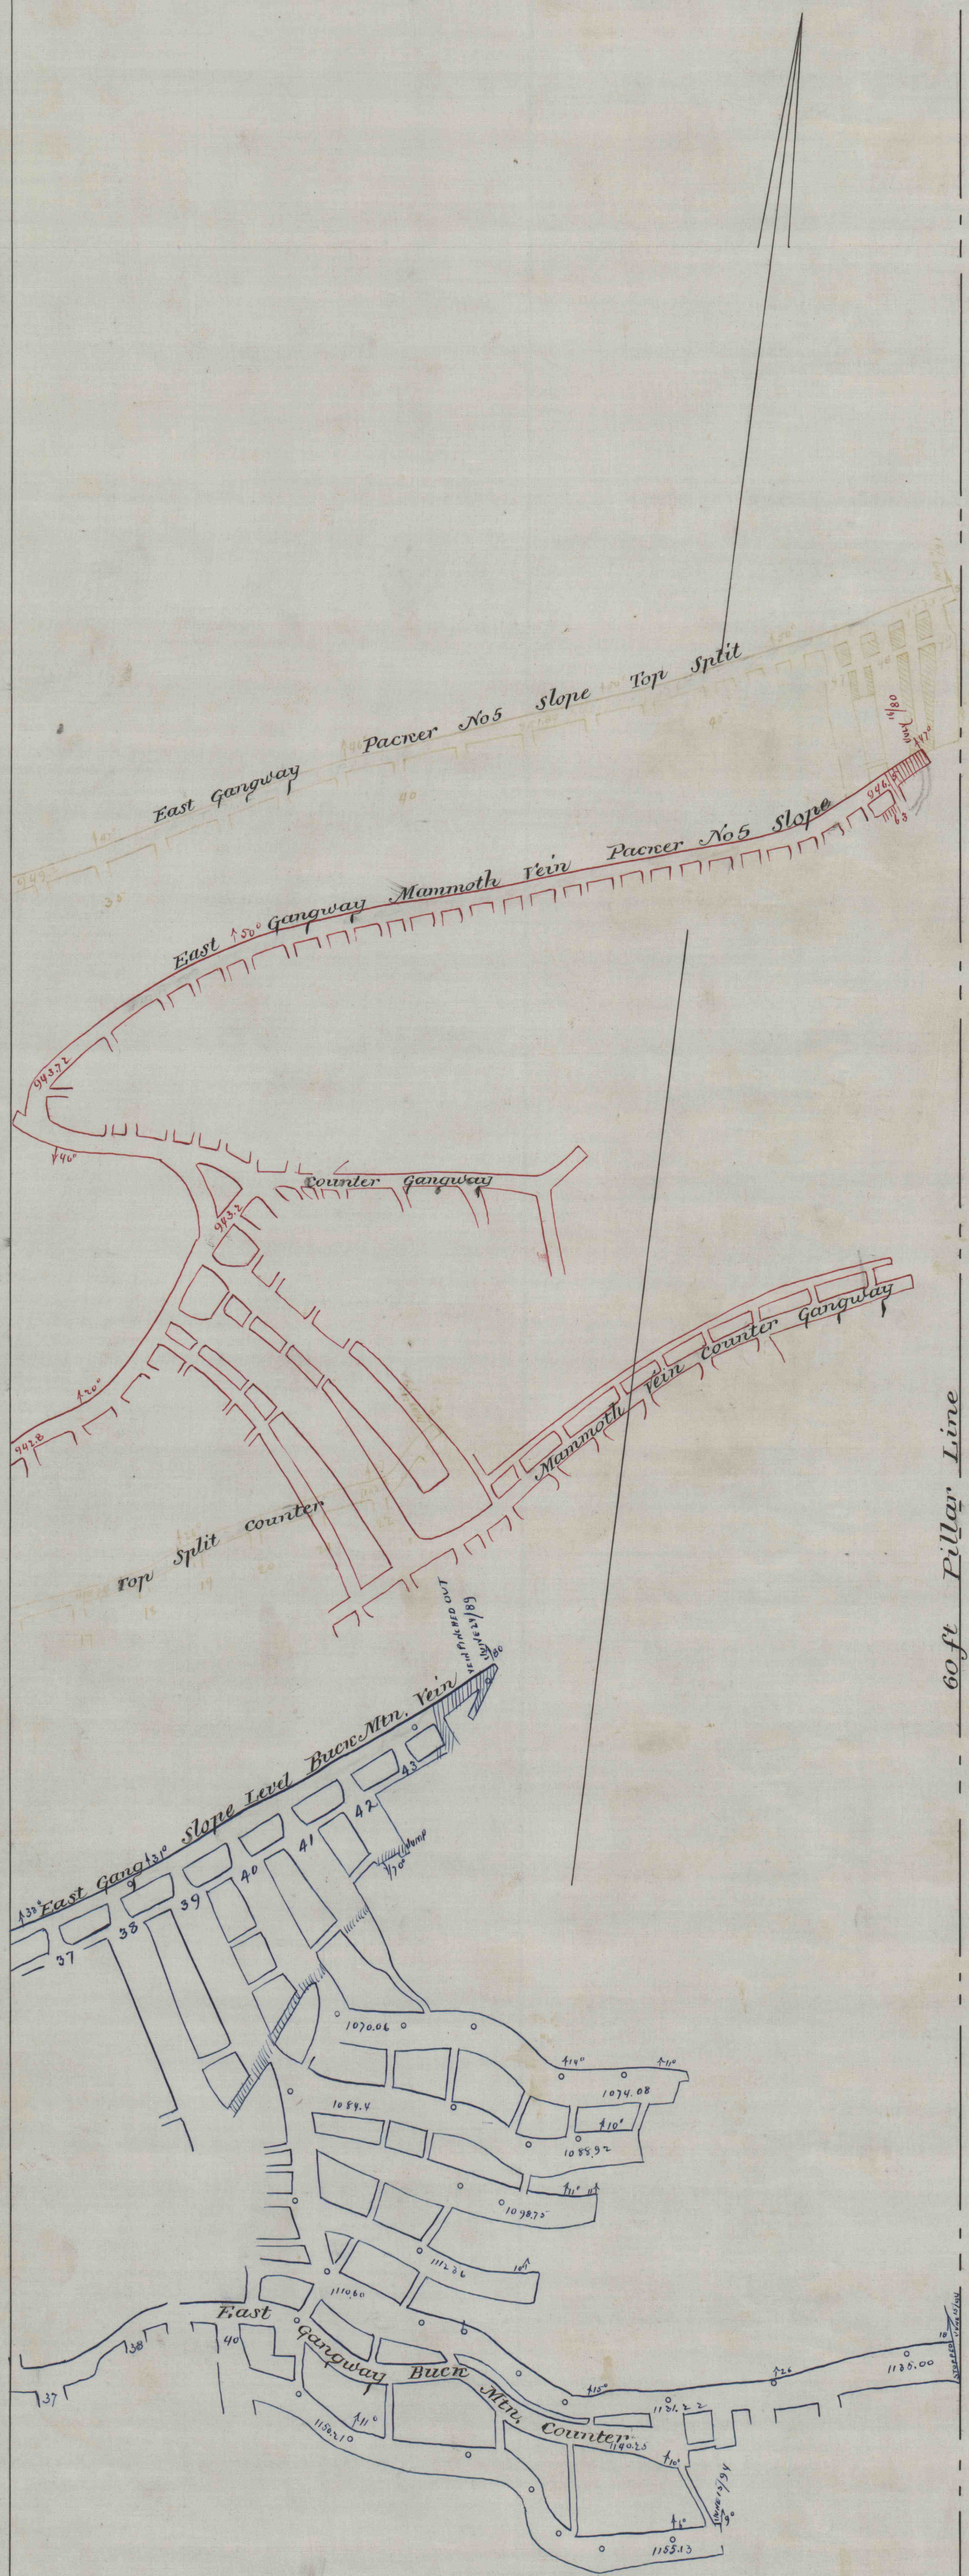

60 ft Pillar Line

Division Line between Packer's Slope workings and Wm. Penn Mine workings

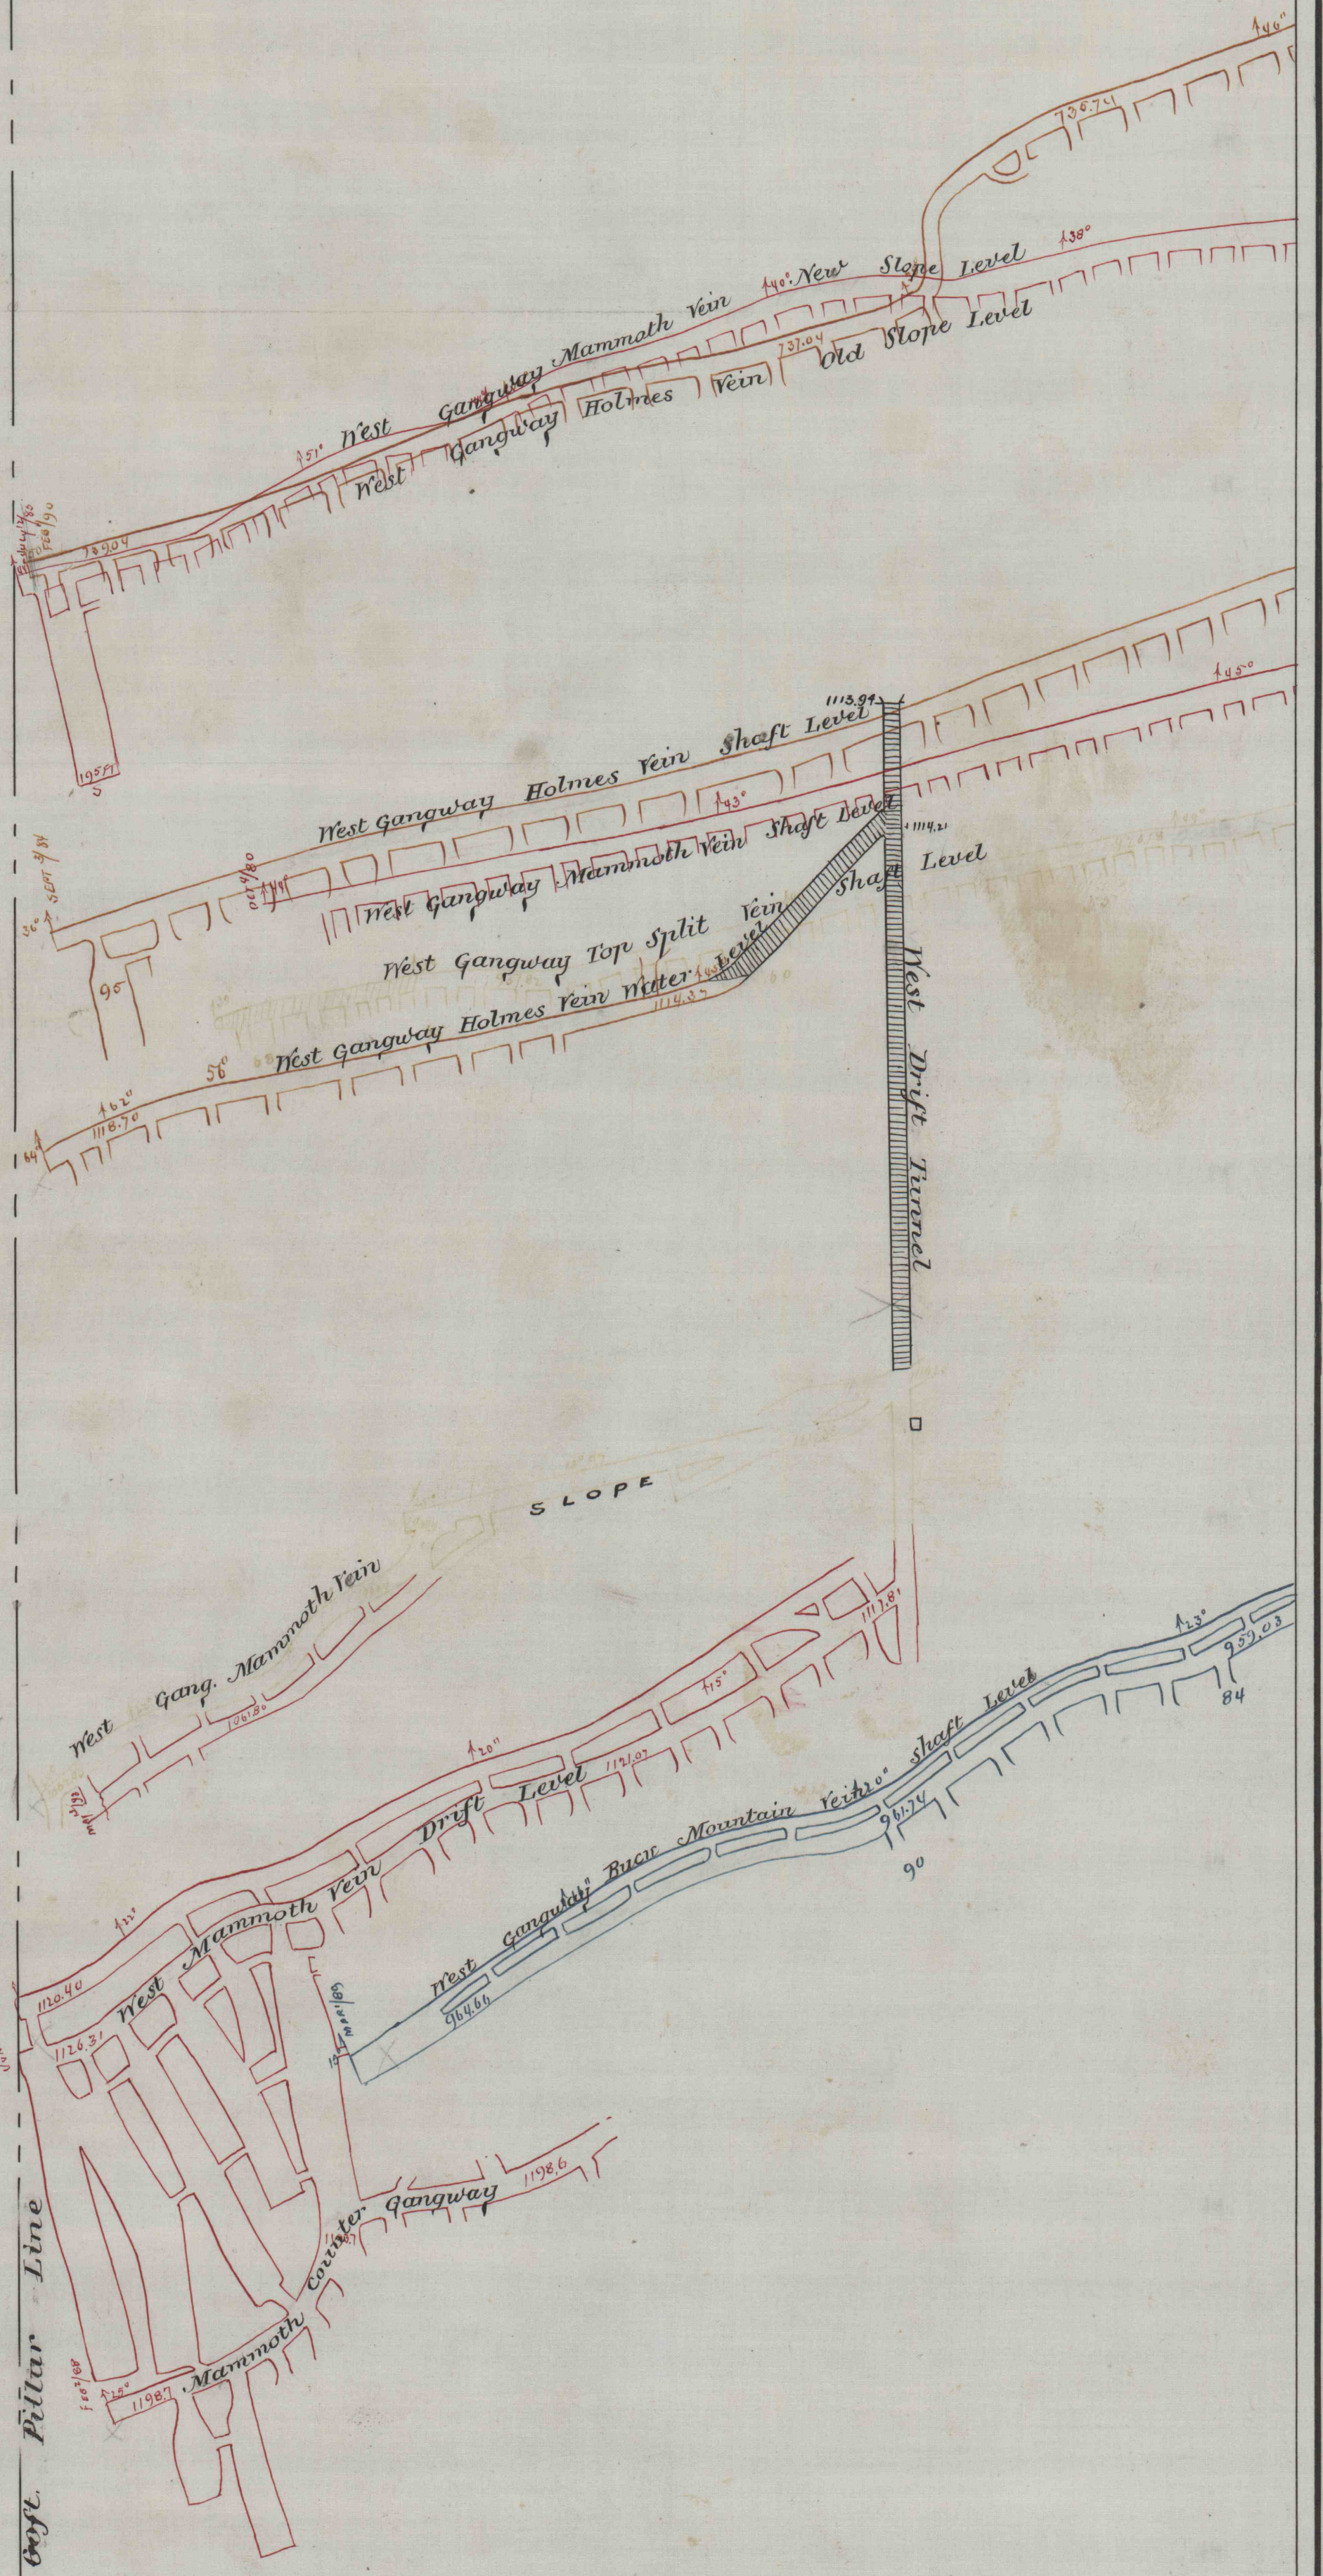

Sketch showing
 Mine Workings of Wm. Penn and Packer No. 5
 Slope in relation to East Line of Packer No. 5 Lease
 Scale 100 ft. = 1 Inch
 F. E. Zerbey Div. Eng. July 1894 W. A. Lathrop Genl. Supt. L. V. Coal Co.
 D. P. Brown Div. " " " " " " " " " " " "