


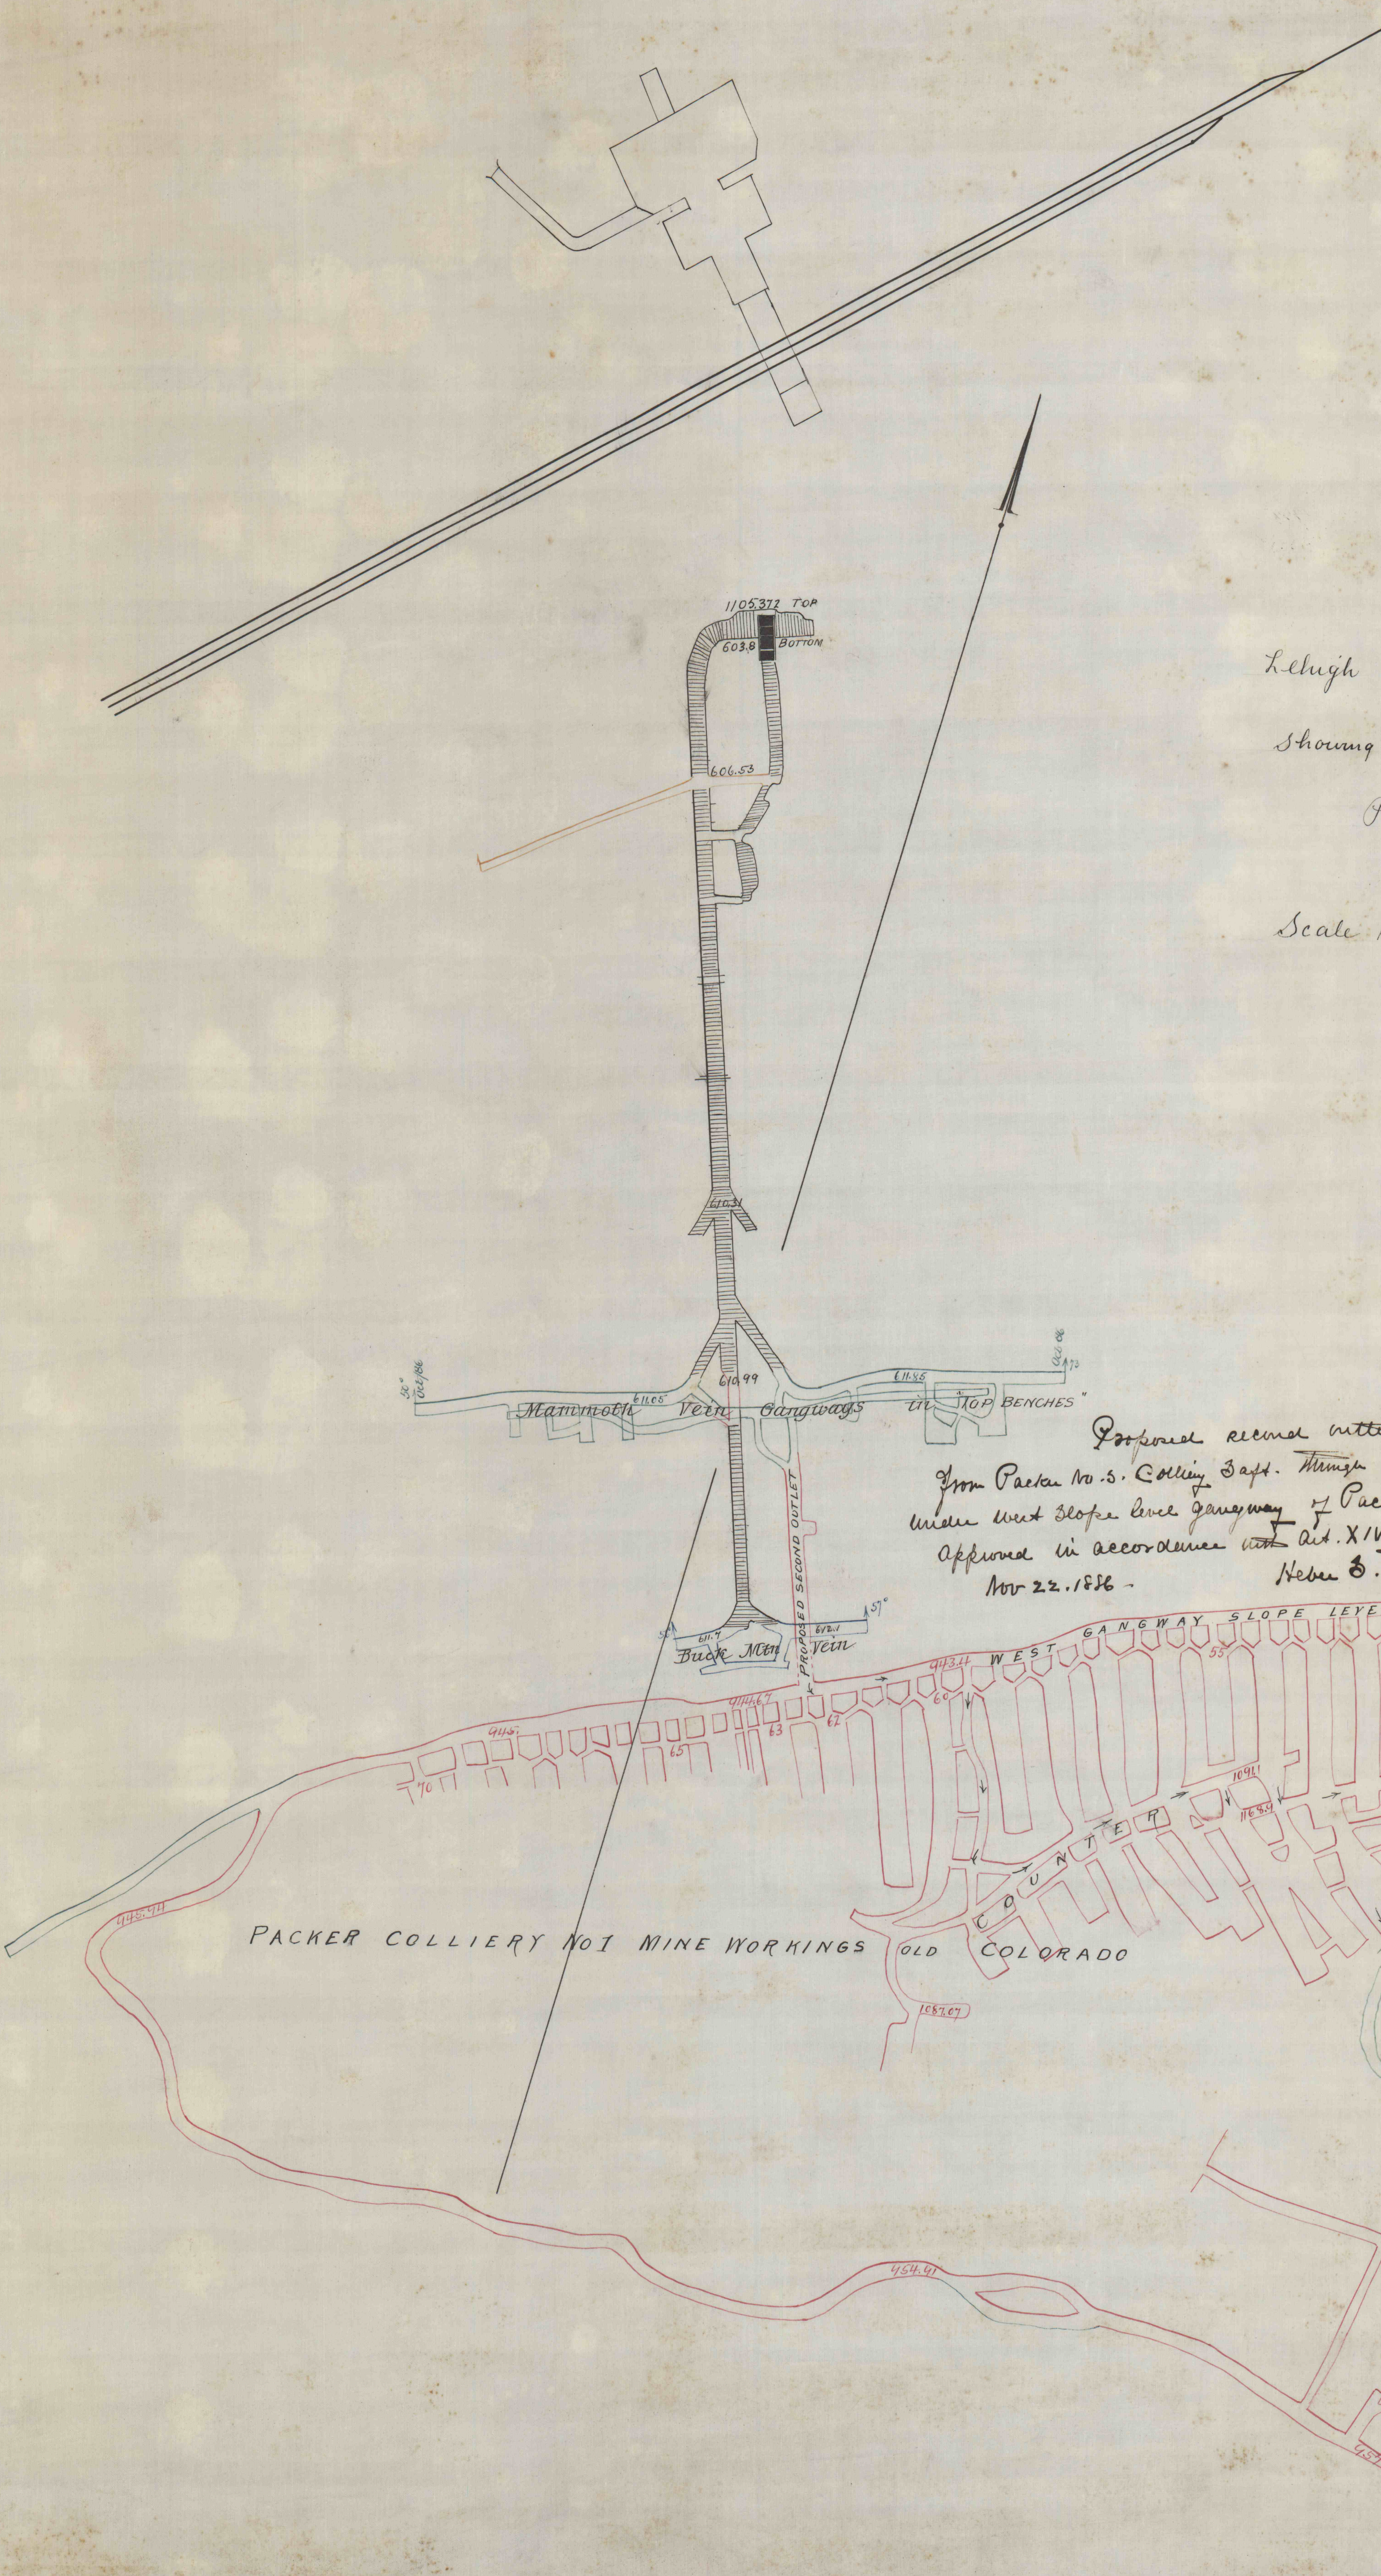

Lehigh Valley Coal Co's Packer Colly' No. 5
 Sketch
 showing proposed second outlet through
 Packer Colliery No. 1.

Scale 100 ft to an Inch

Copied Nov 22nd '86

Col D. P. Brown
 Supt
 Frank E. Clements
 Engineer

Proposed second outlet
 from Packer No. 5 Colliery Supt. through pillars
 under west slope level gangway of Packer No. 1 Colliery
 Approved in accordance with Art. XIV of Coal Lease
 Nov 22, 1886 -
 Heber S. Thompson Engineer & Surveyor

