


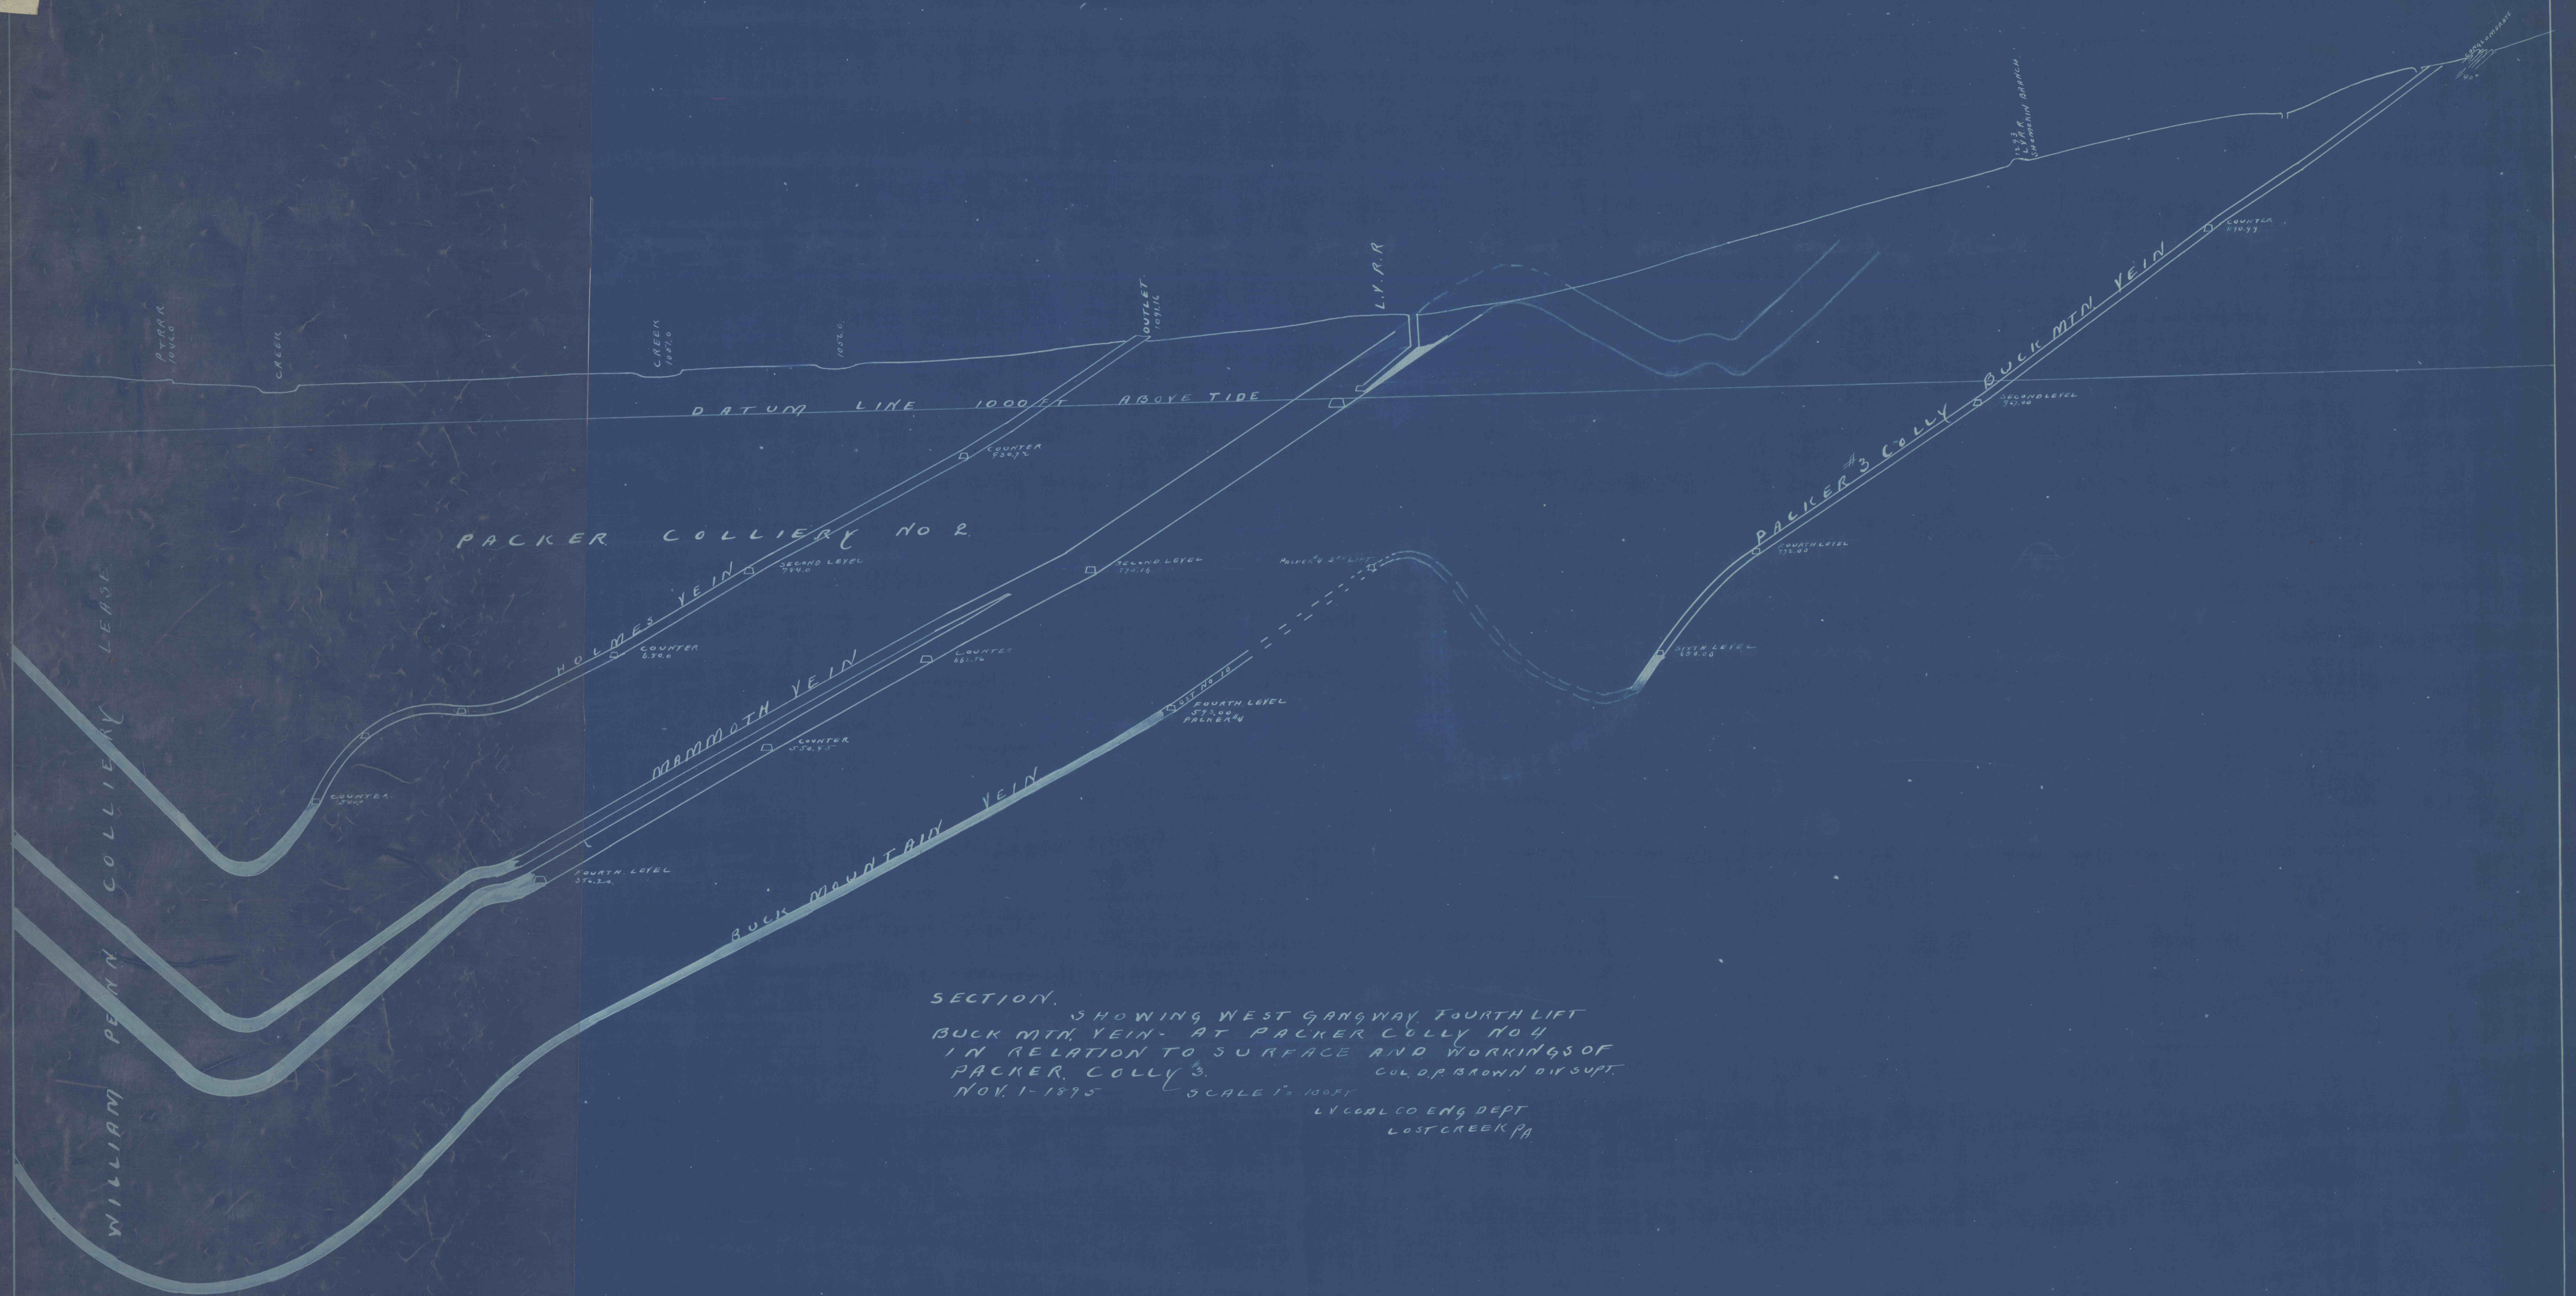

SECTION.
SHOWING WEST GANGWAY FOURTH LIFT
BUCK MTH. VEIN- AT PACKER COLLY NO 4
IN RELATION TO SURFACE AND WORKINGS OF
PACKER COLLY NO 3.
NOV. 1-1895

SCALE 1" = 100 FT
L.V. COAL CO. ENG. DEPT
LOST CREEK PA