


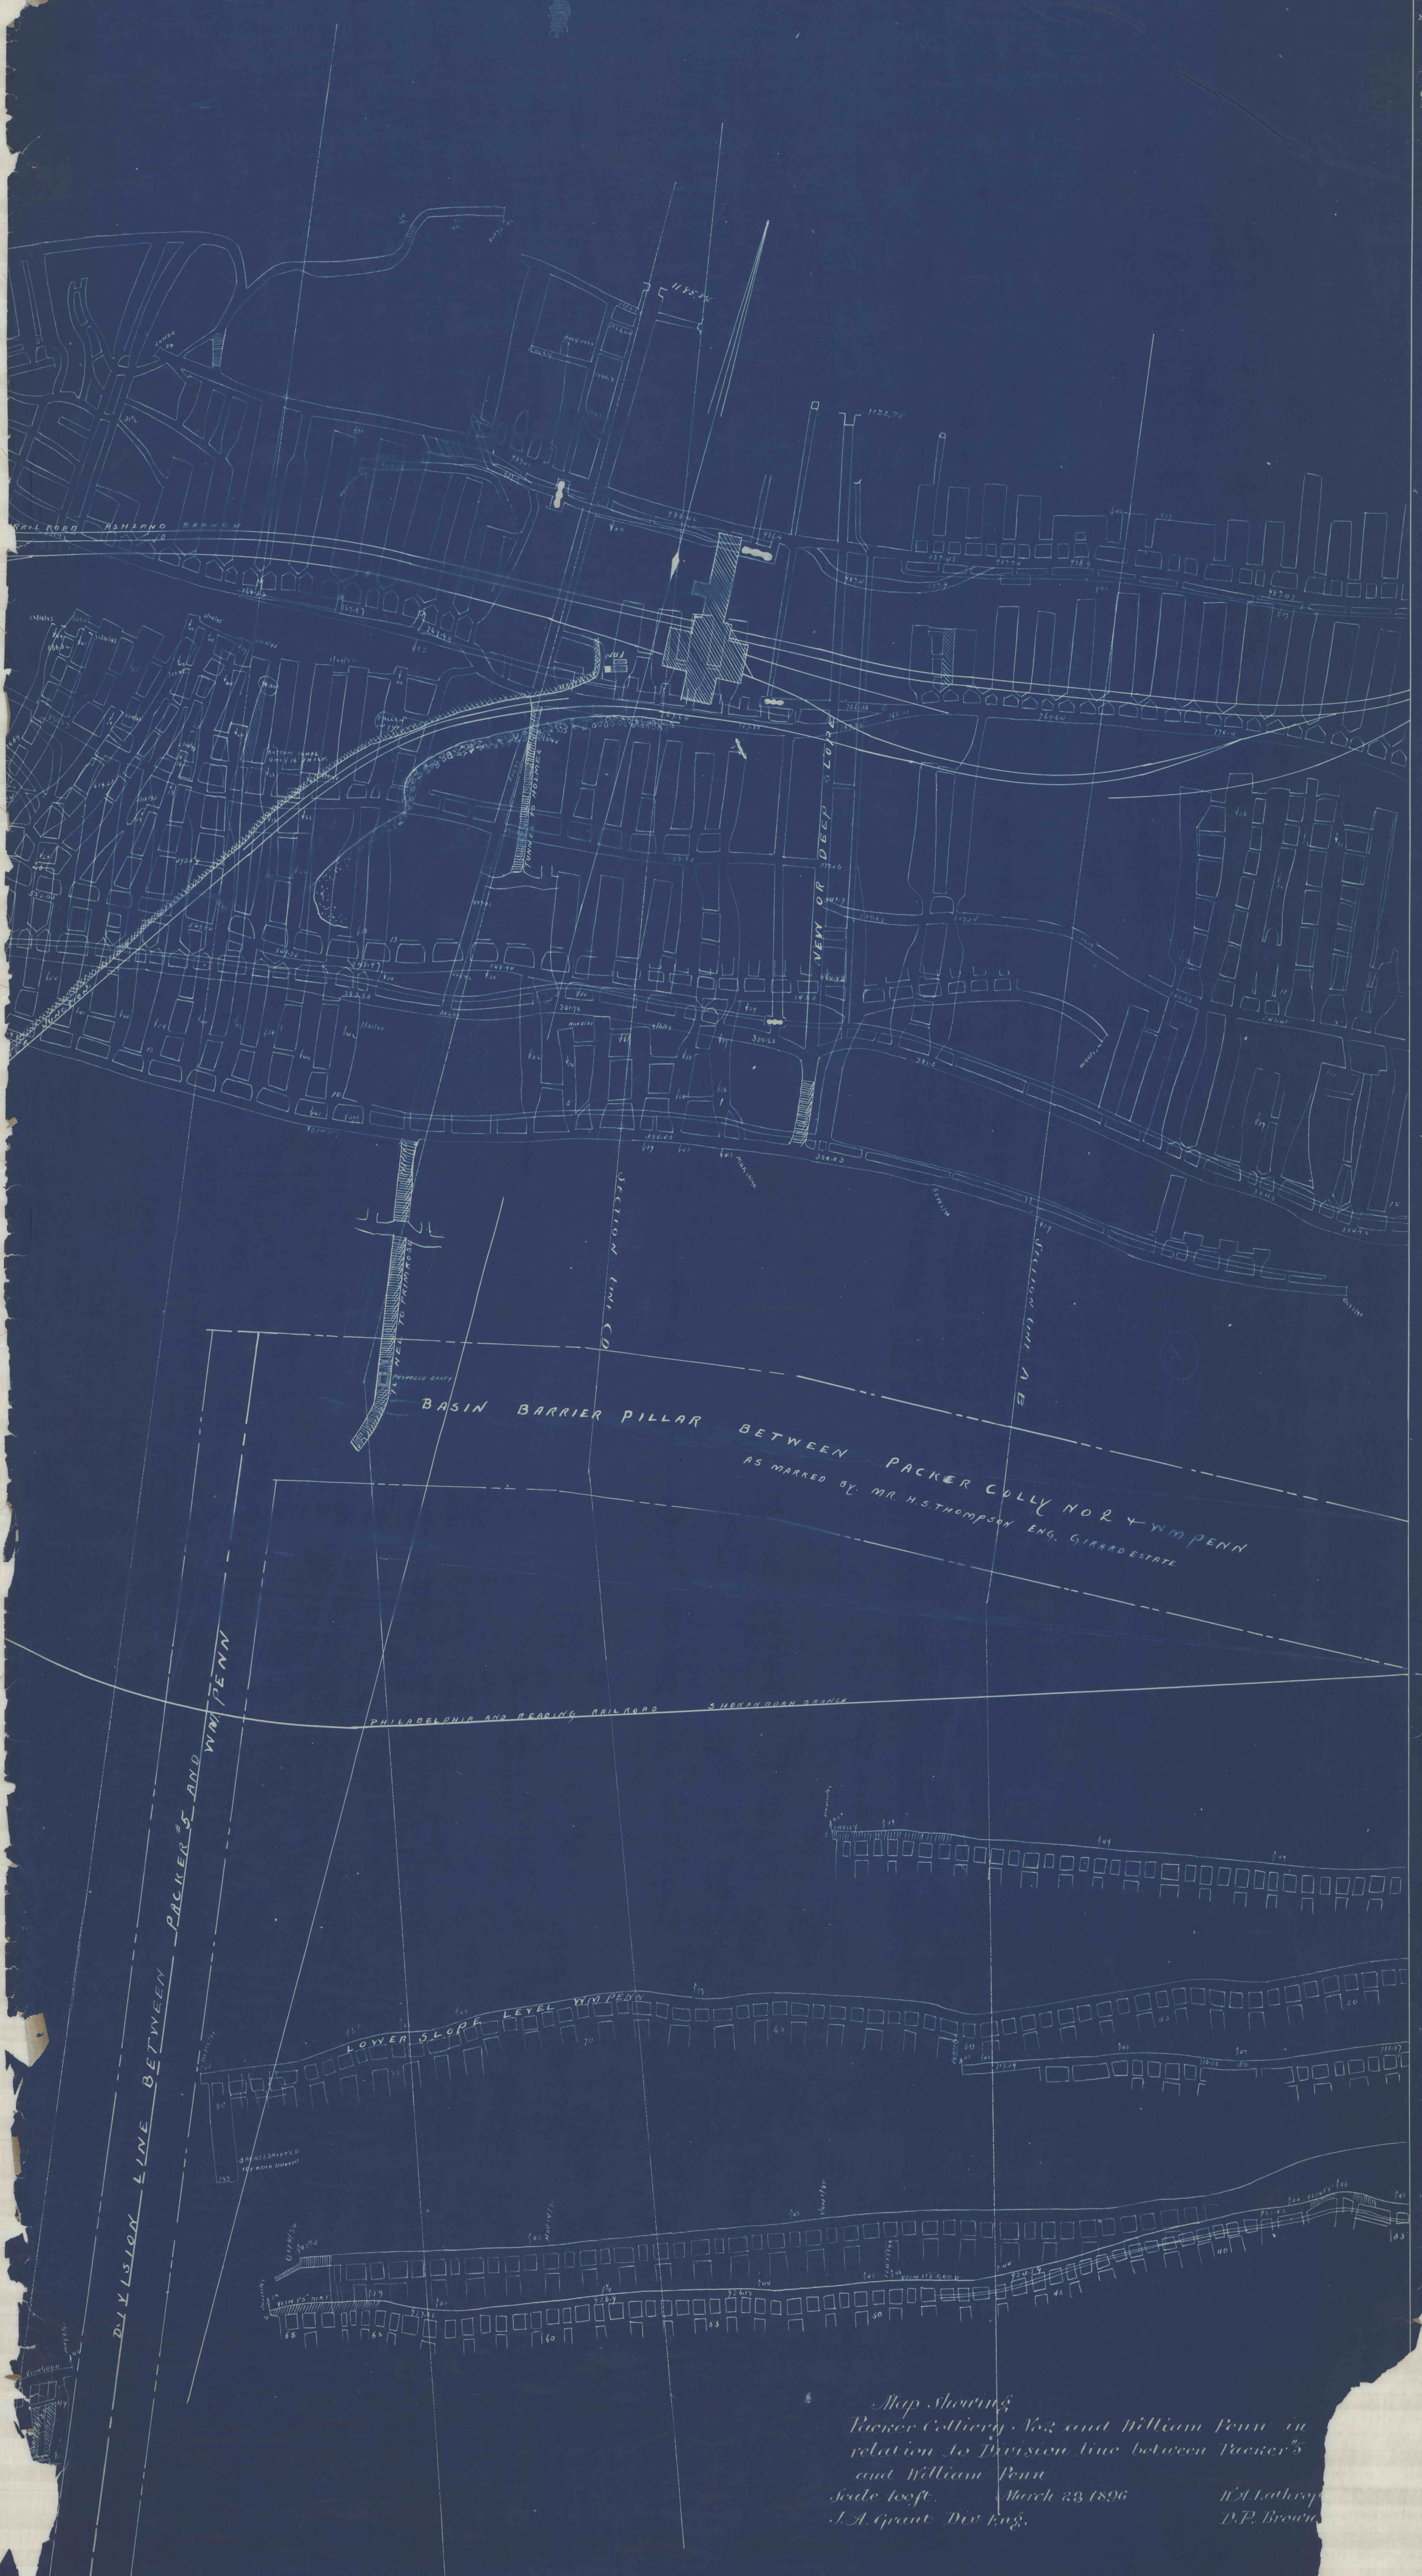

Map showing
Packer Colliery No 2 and William Penn in
relation to Division line between Packer's
and William Penn
Scale 100 ft. March 23 1896
J.A. Grant Dwg. Eng. W.A. Lathrop
D.P. Brown