


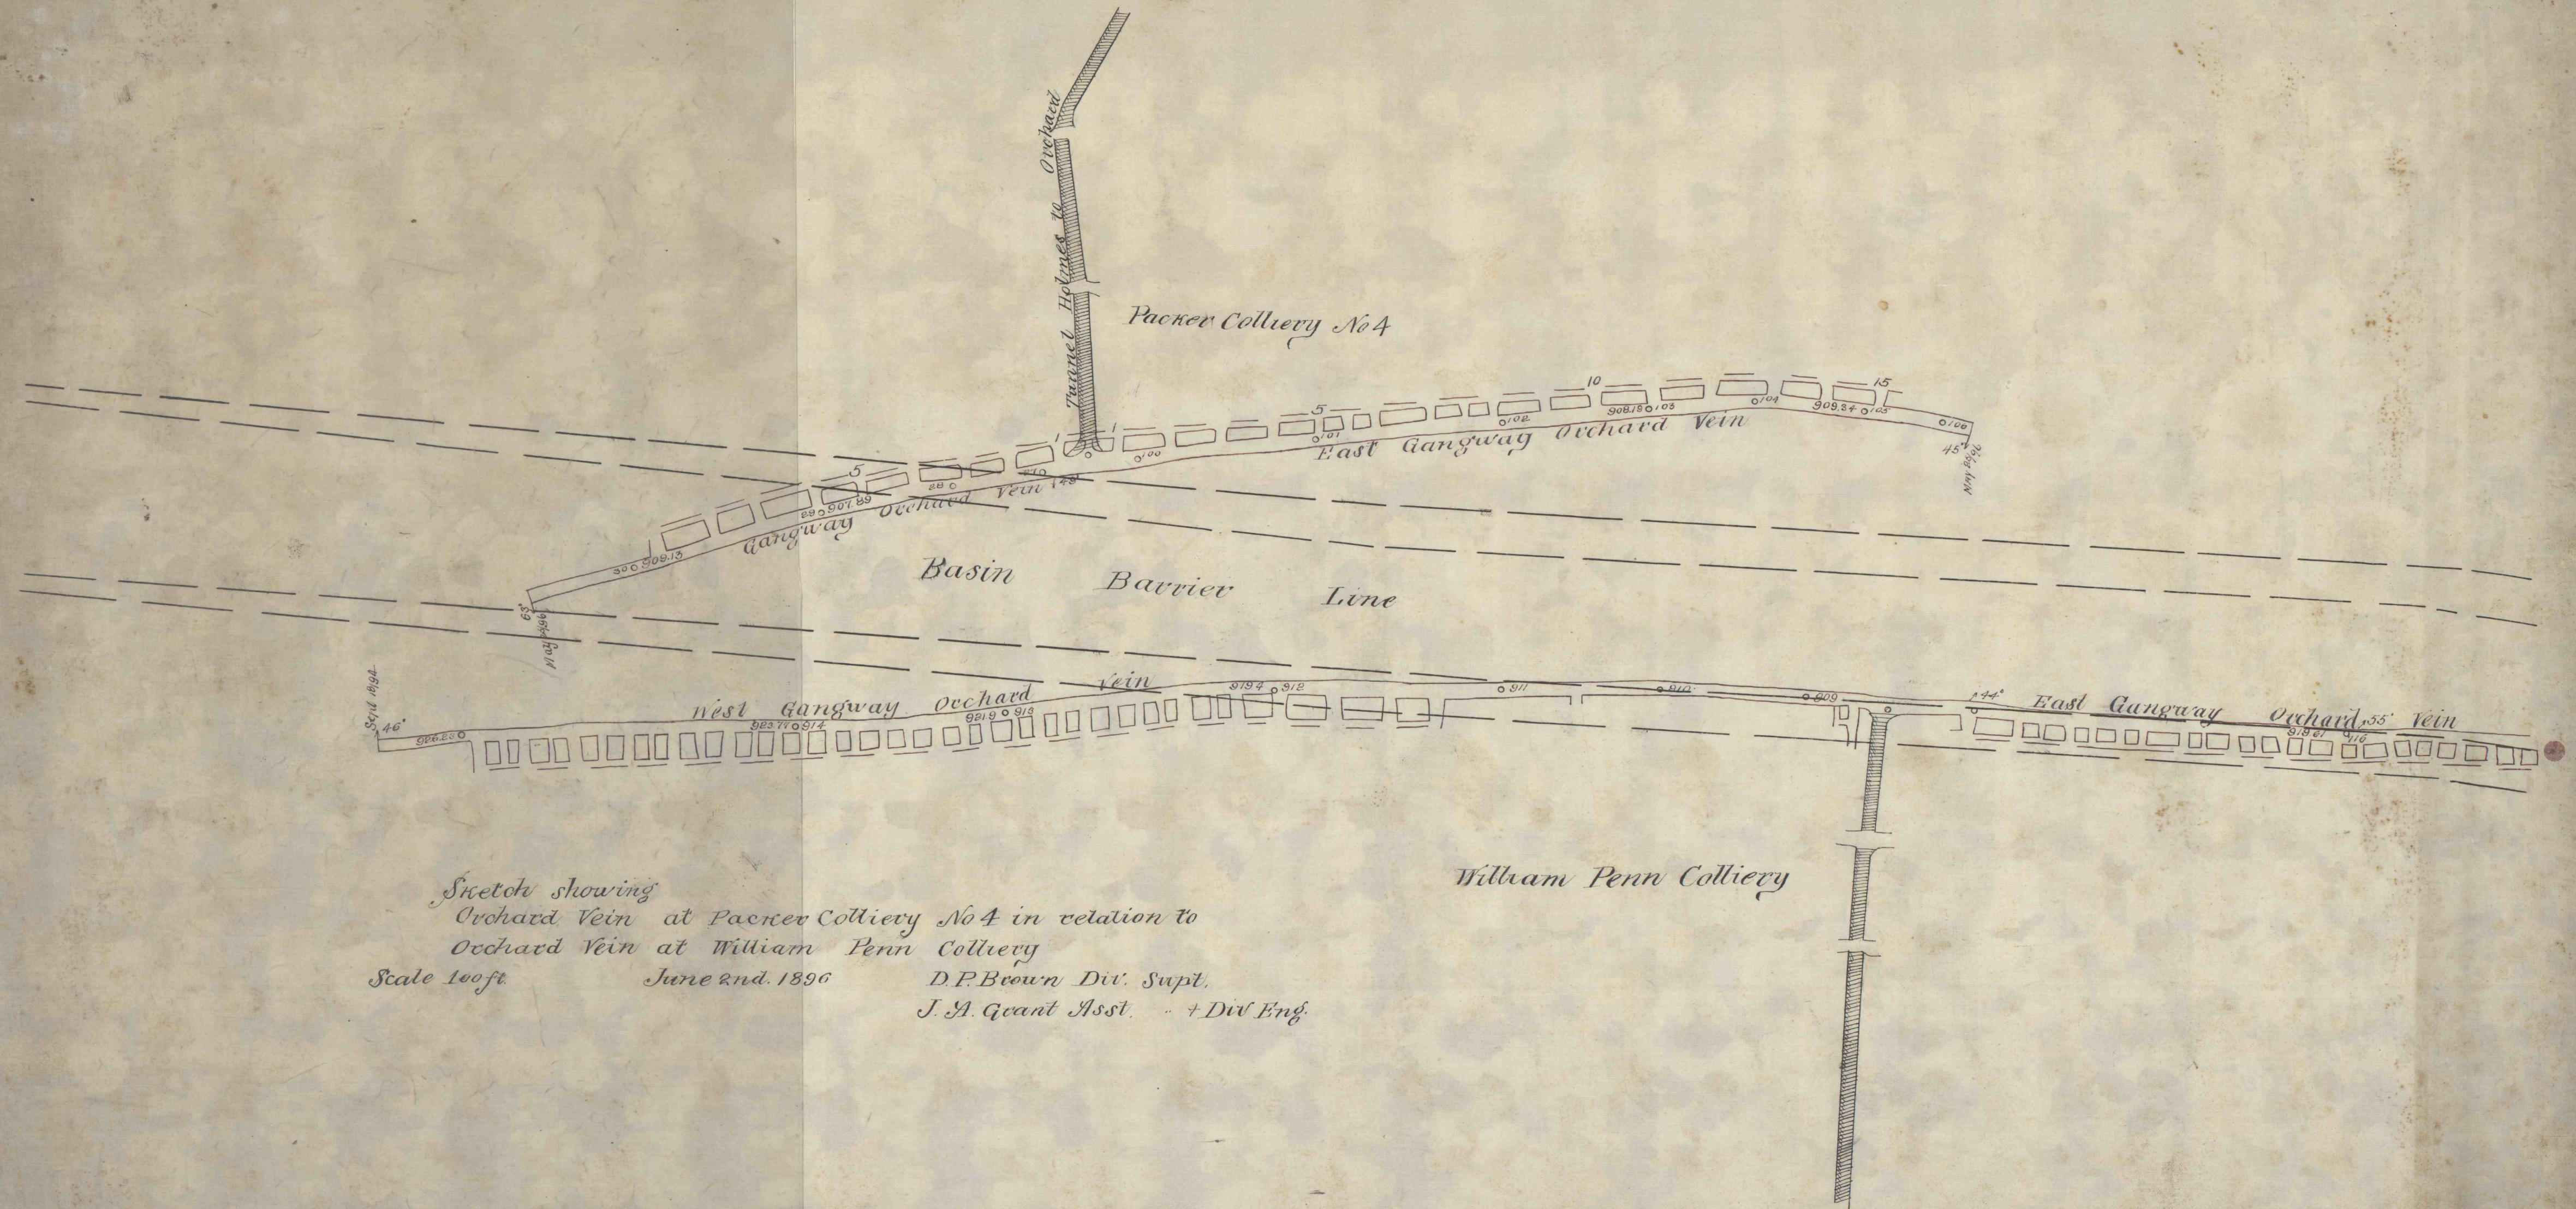

Sketch showing
 Orchard Vein at Packer Colliery No 4 in relation to
 Orchard Vein at William Penn Colliery
 Scale 100 ft. June 2nd, 1896
 D.P. Brown Div. Supt.
 J.A. Grant Asst. " + Div Eng.

William Penn Colliery