


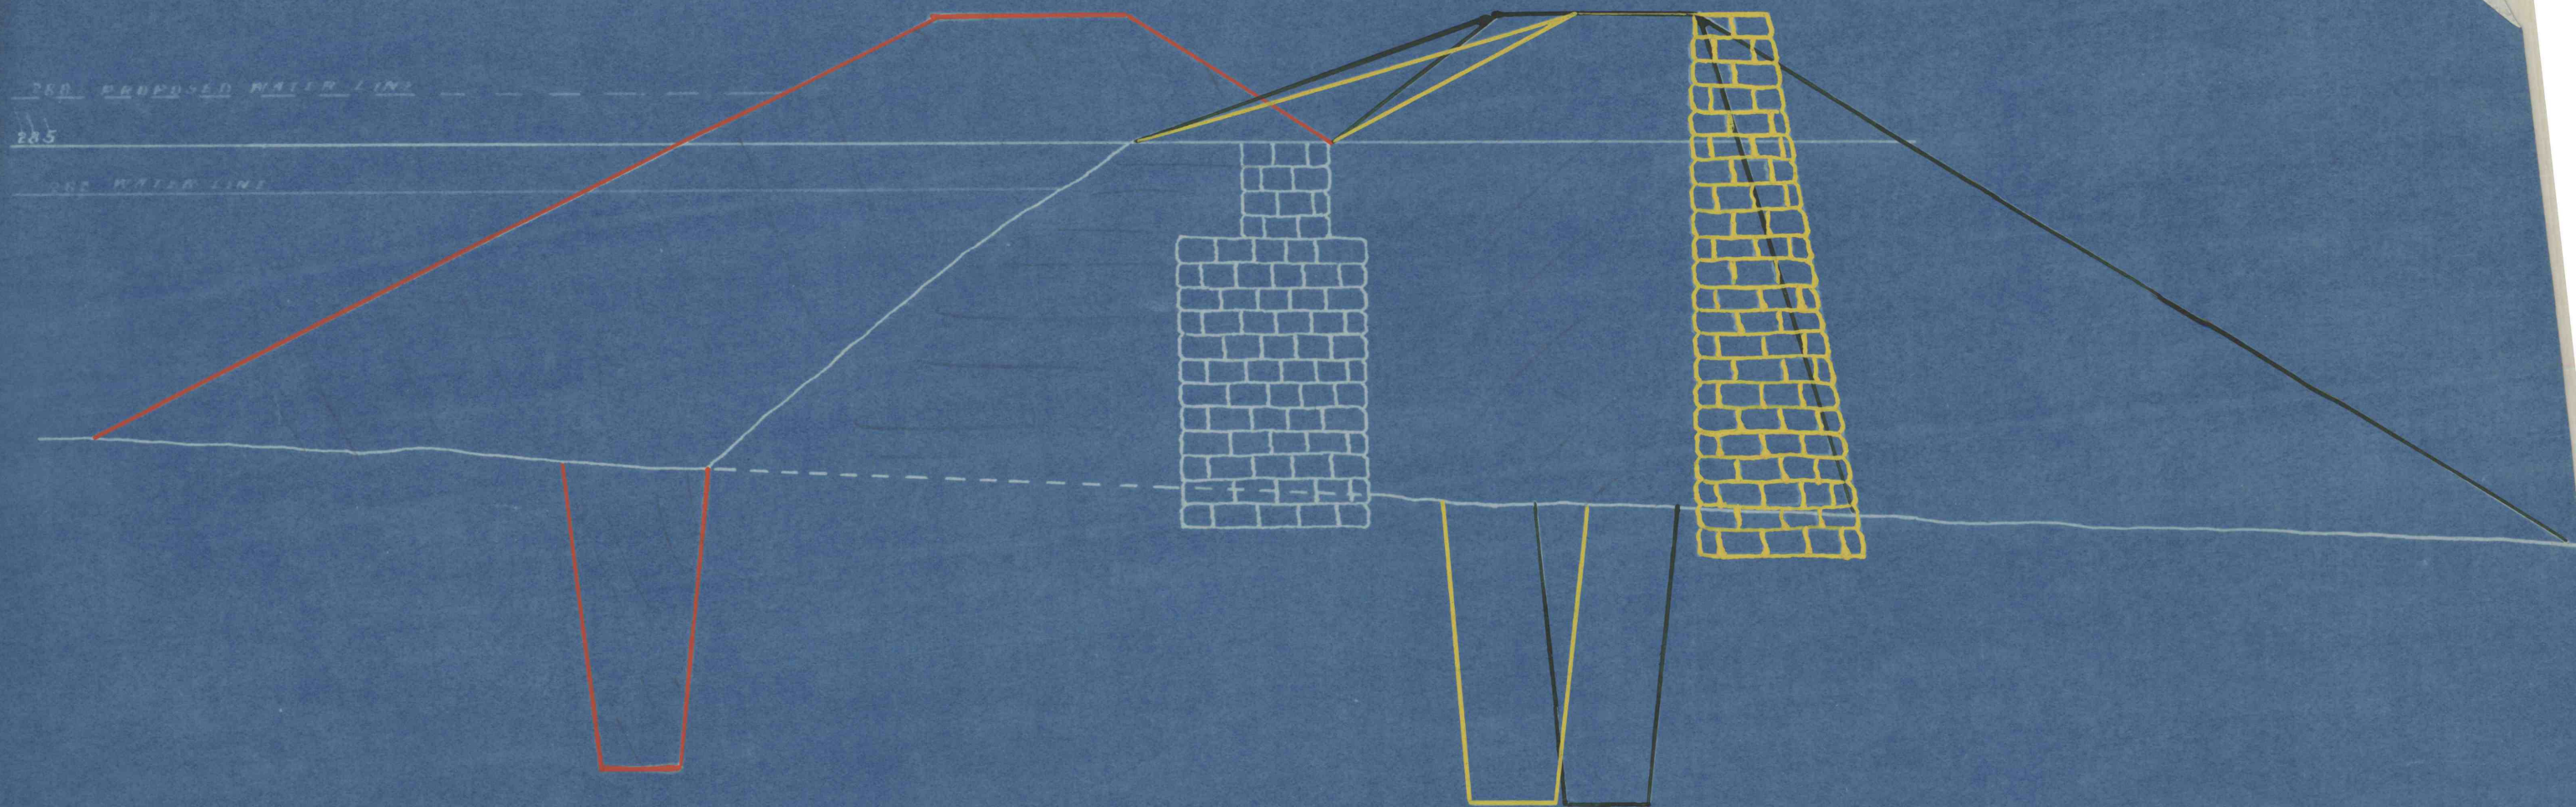

Owl Creek Reservoir of Borough of Tamaqua — 3 Sections superimposed illustrating possible Plans of reinforcing and raising old Embankment

Black - Present embankment

Red - Reinforcement advised by Thompson & Archbald

Yellow  - Reinforcement suggested by Mr. Isaac Christ

Green  - Modification of Mr. Christ suggestion

Scale 1 in. = 10 ft. Heber S. Thompson
James Archbald Jr. ENGINEERS