


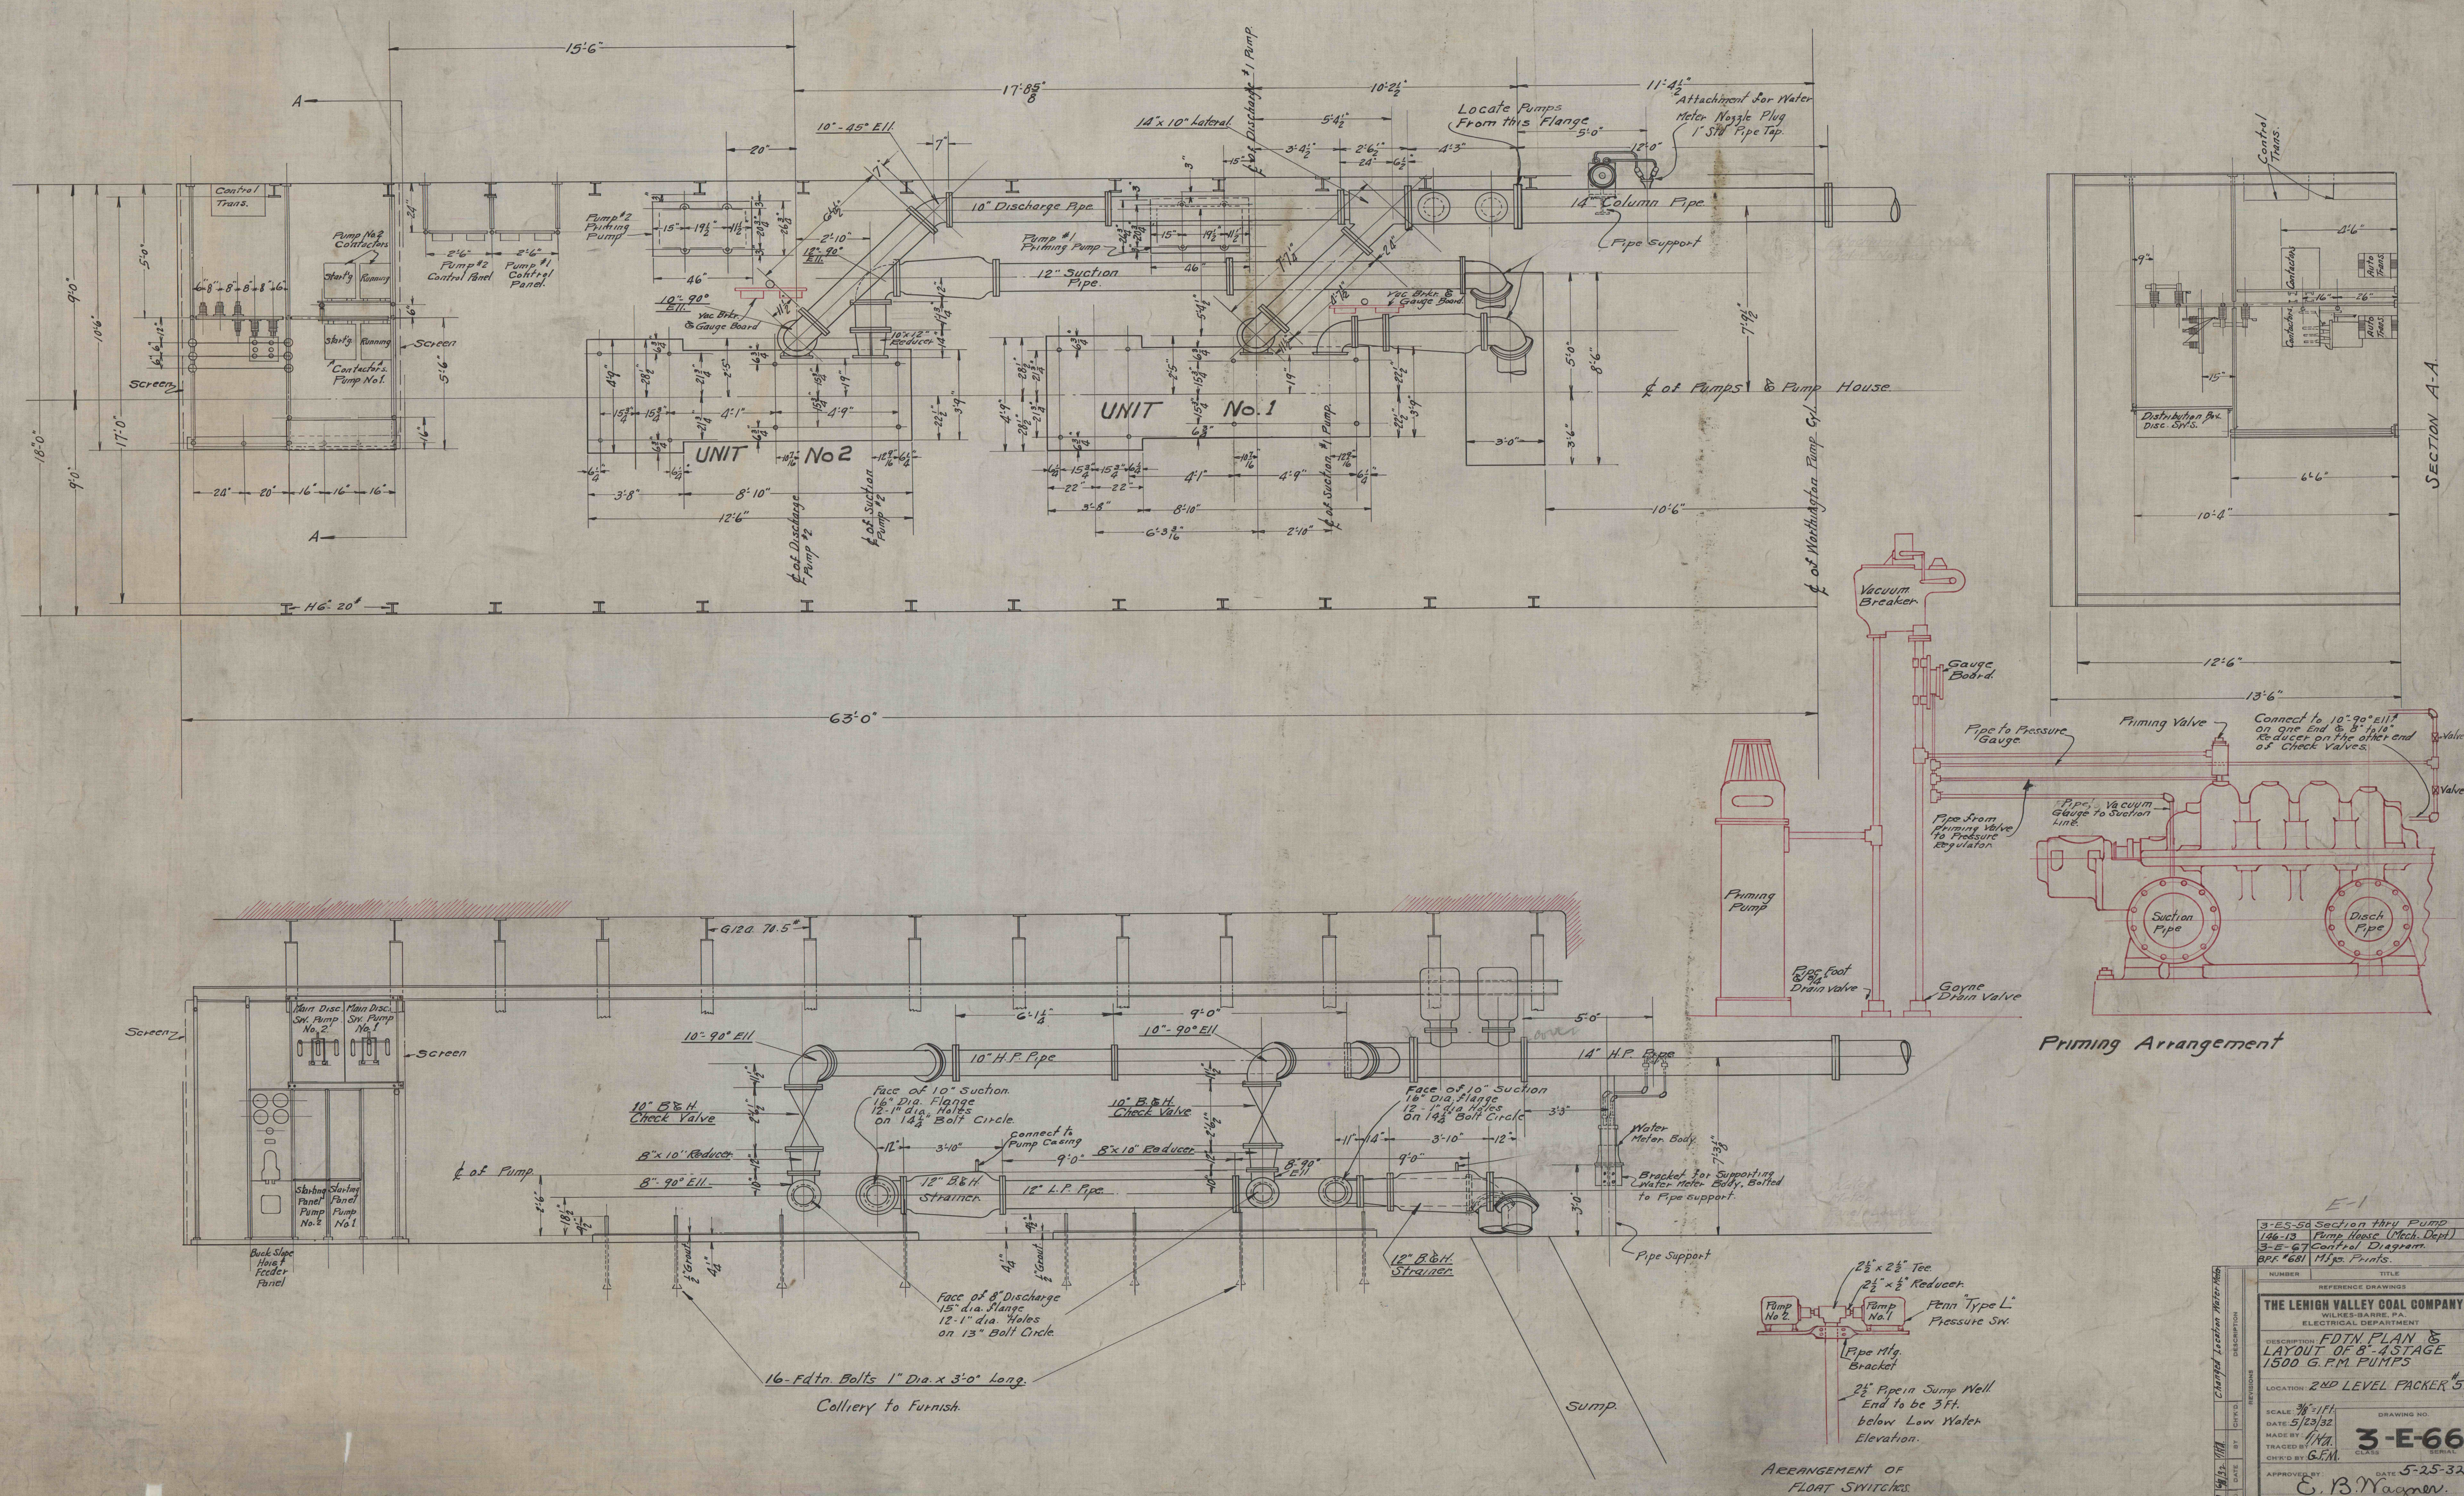

Changed Location Meter-High

NO.	DATE	BY	CHK'D	REVISIONS	DESCRIPTION
1	6/20/82	MH			

NUMBER _____ TITLE _____
REFERENCE DRAWINGS _____
THE LEHIGH VALLEY COAL COMPANY
WILKES-BARRIE, PA.
ELECTRIC DEPARTMENT
DESCRIPTION: **FDTN PLAN &
LAYOUT OF #8-4STAGE
1500 G.P.M. PUMPS**
LOCATION: **2ND LEVEL PACKER #5**
SCALE: **¾" = 1'-1"**
DATE: **5/23/82**
DRAWN BY: _____
CHECKED BY: **H.A.**
3-E-66
CLASS: _____ SERIAL: _____
TRACED BY: _____
CHK'D BY: **G.F.M.**
APPROVED BY: _____ DATE: **5-25-82**
E. B. Wagner
VICE ENGINEER