


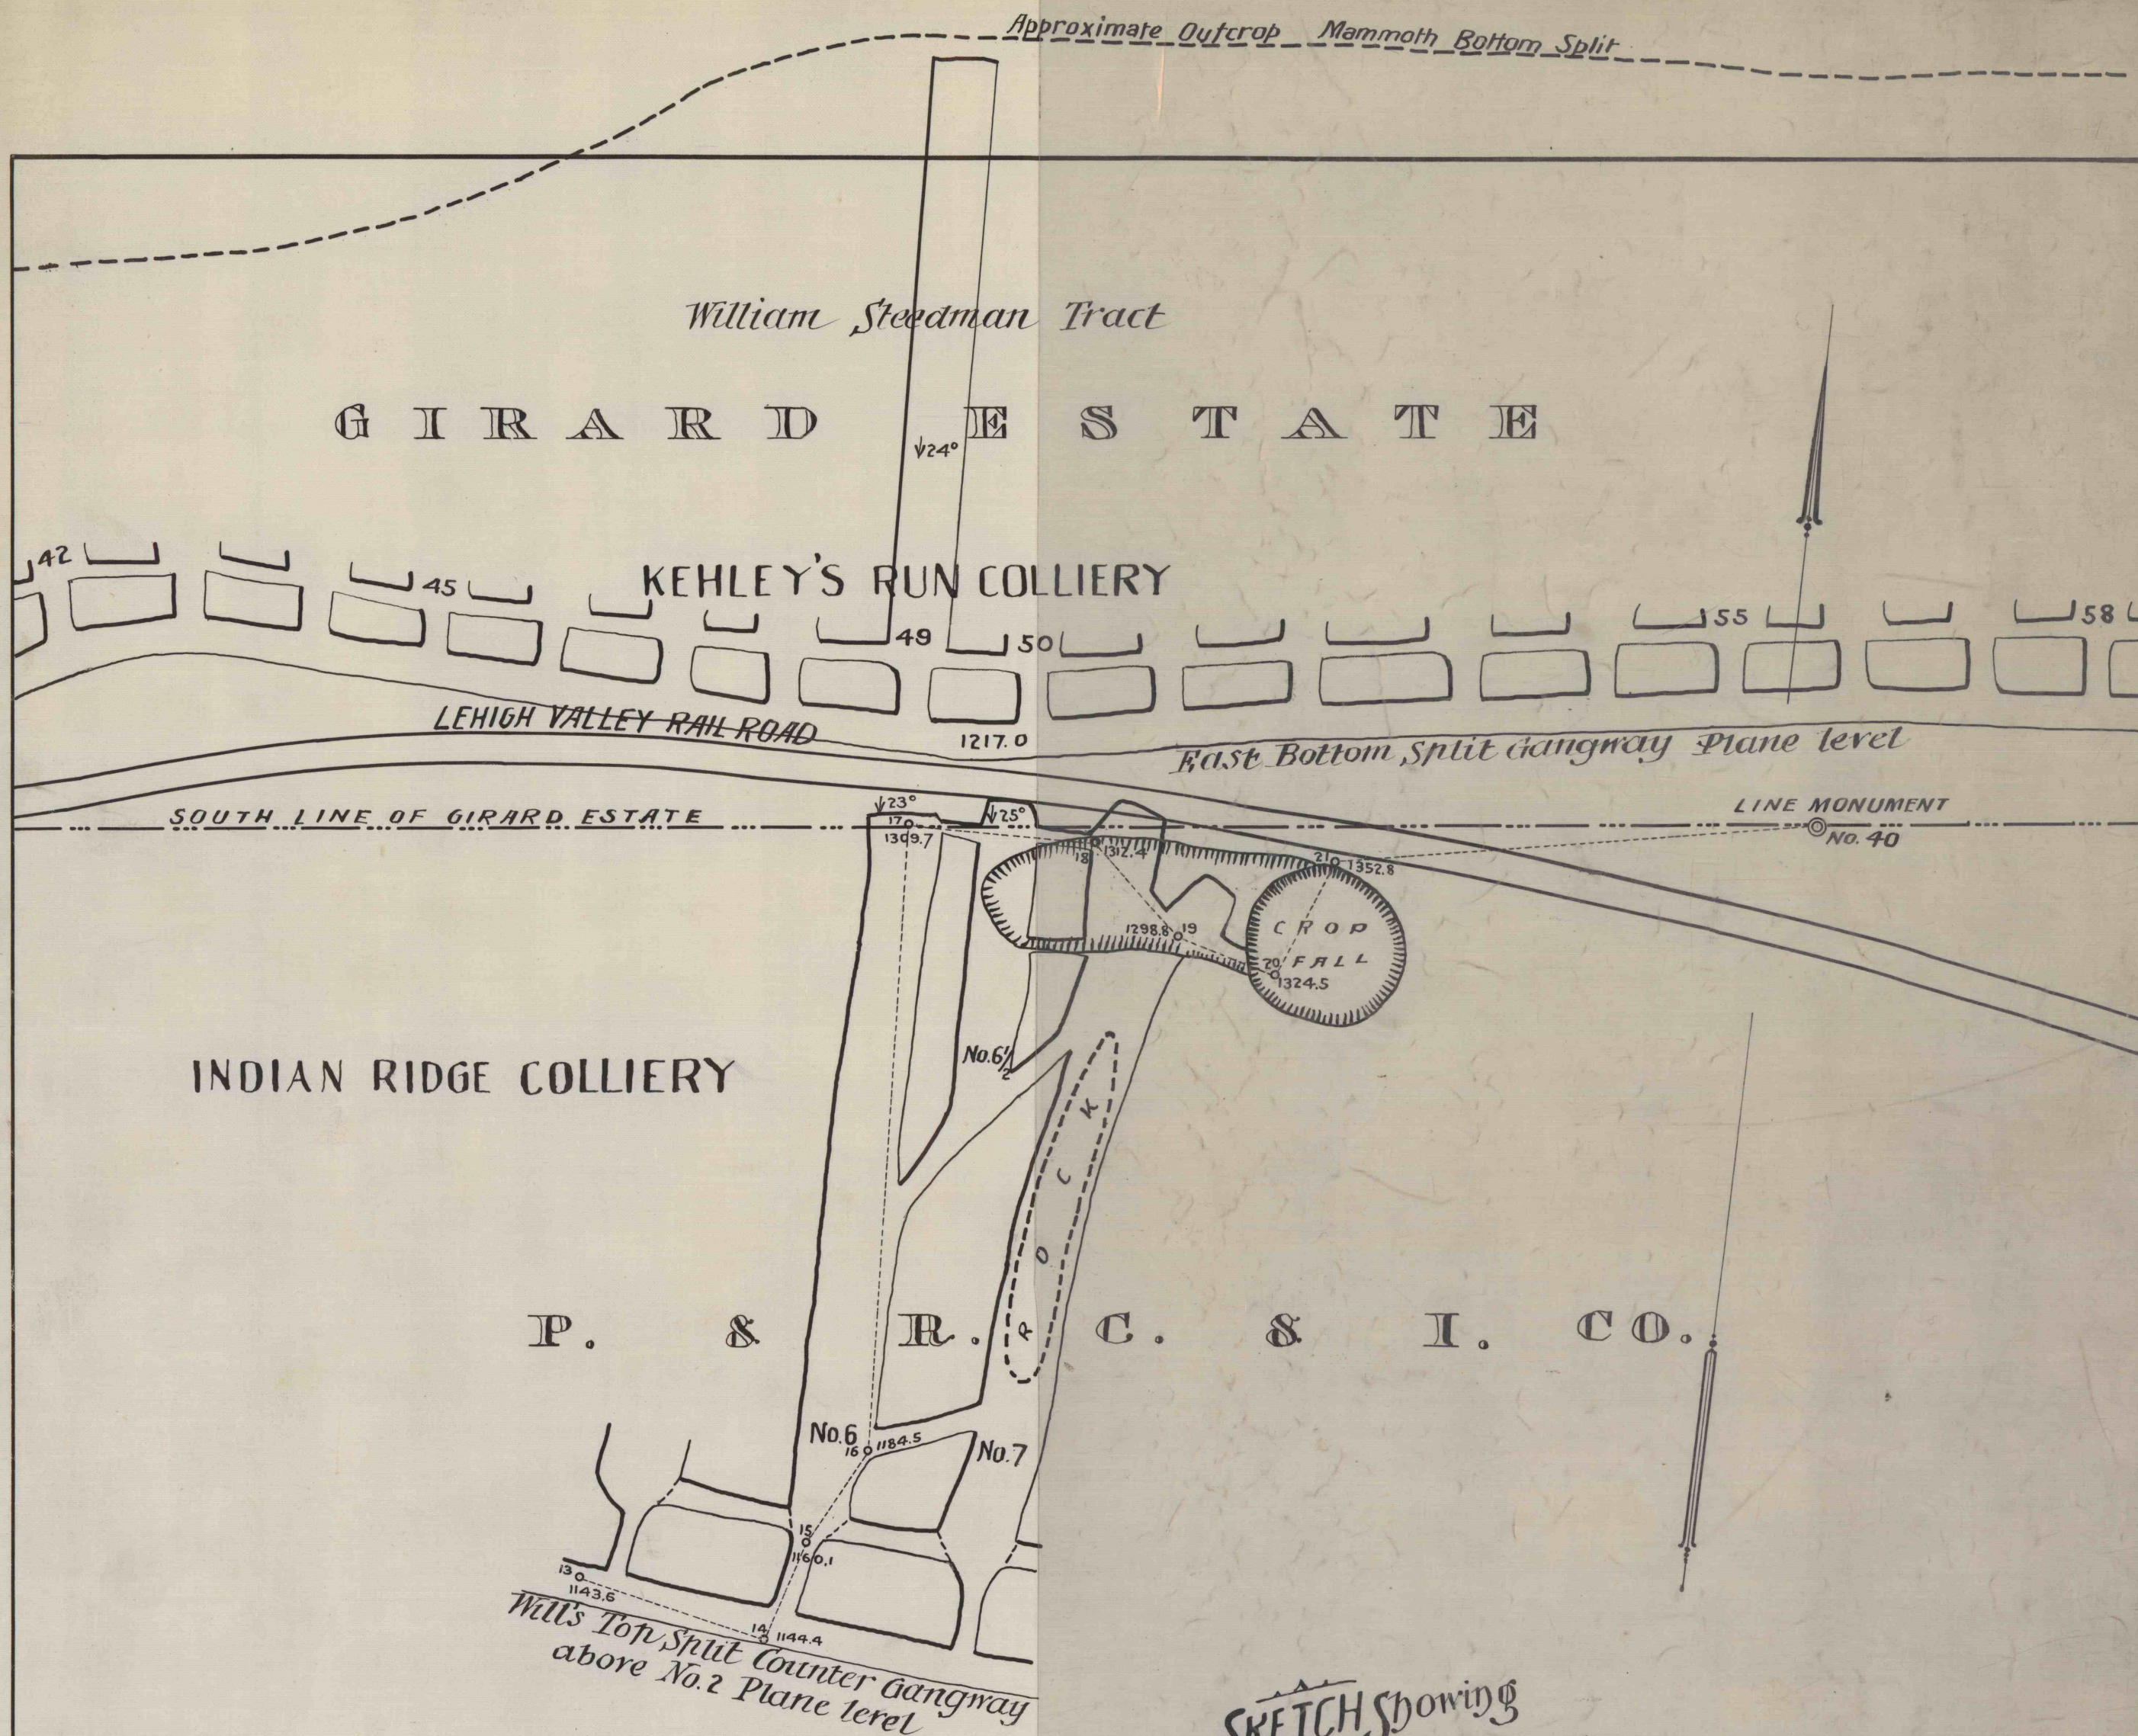

SKETCH showing
 BREASTS NOS. 6, 6½ & 7
 FROM WILLS TOP SPLIT COUNTER

Above the No. 2 Plane level Indian Ridge Colliery, driven
 over the South Line of the Girard Estate.

Scale 1 in. = 50 ft. — Heber S. Thompson
 Poltsville, Pa. July 16, 1898. ENGINEER GIRARD ESTATE