


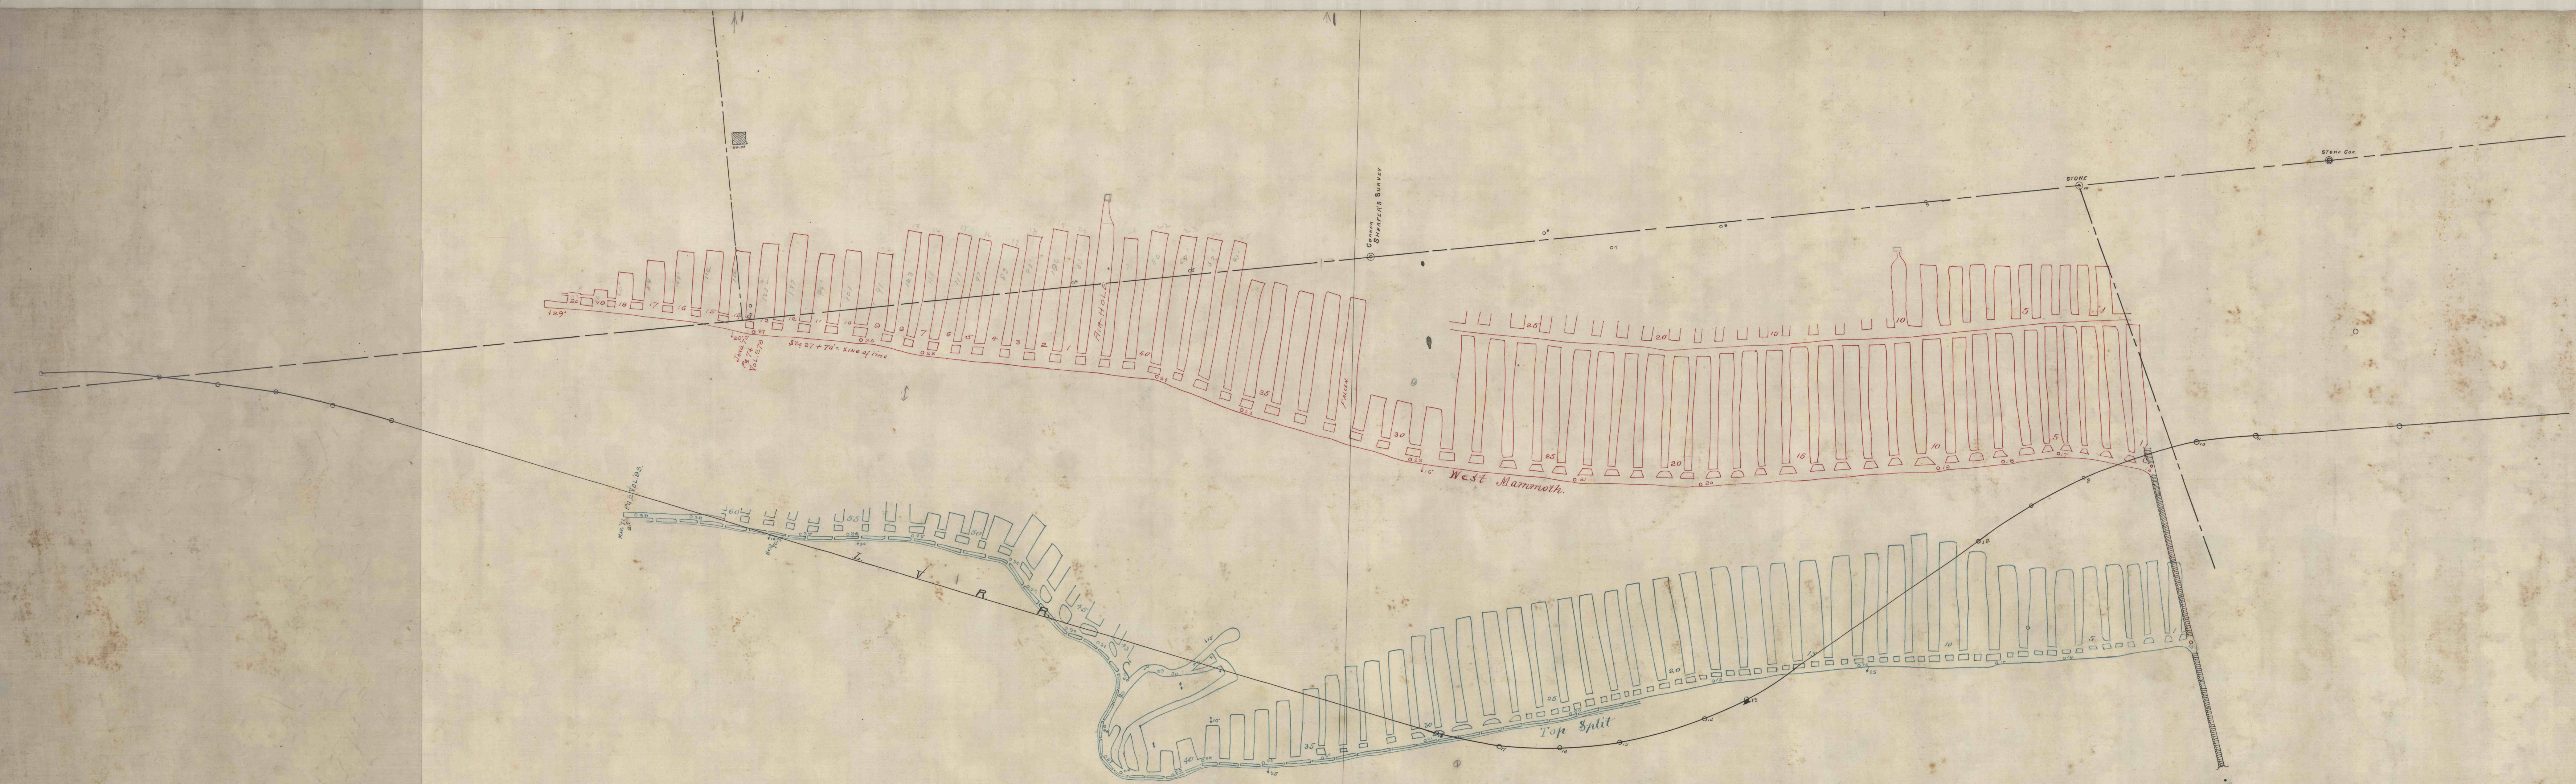

KNICKERBOCKER COLLIERY

SCALE 1 INCH = 100 FT.

Pottsville, Pa. 1870.

Copy of A.J. Womelsdorf's Map.
(Made by Stephen Harris,
held by Womelsdorf.)

1897.

H.S. Thompson,
Eng'g. Gear's Estate.