


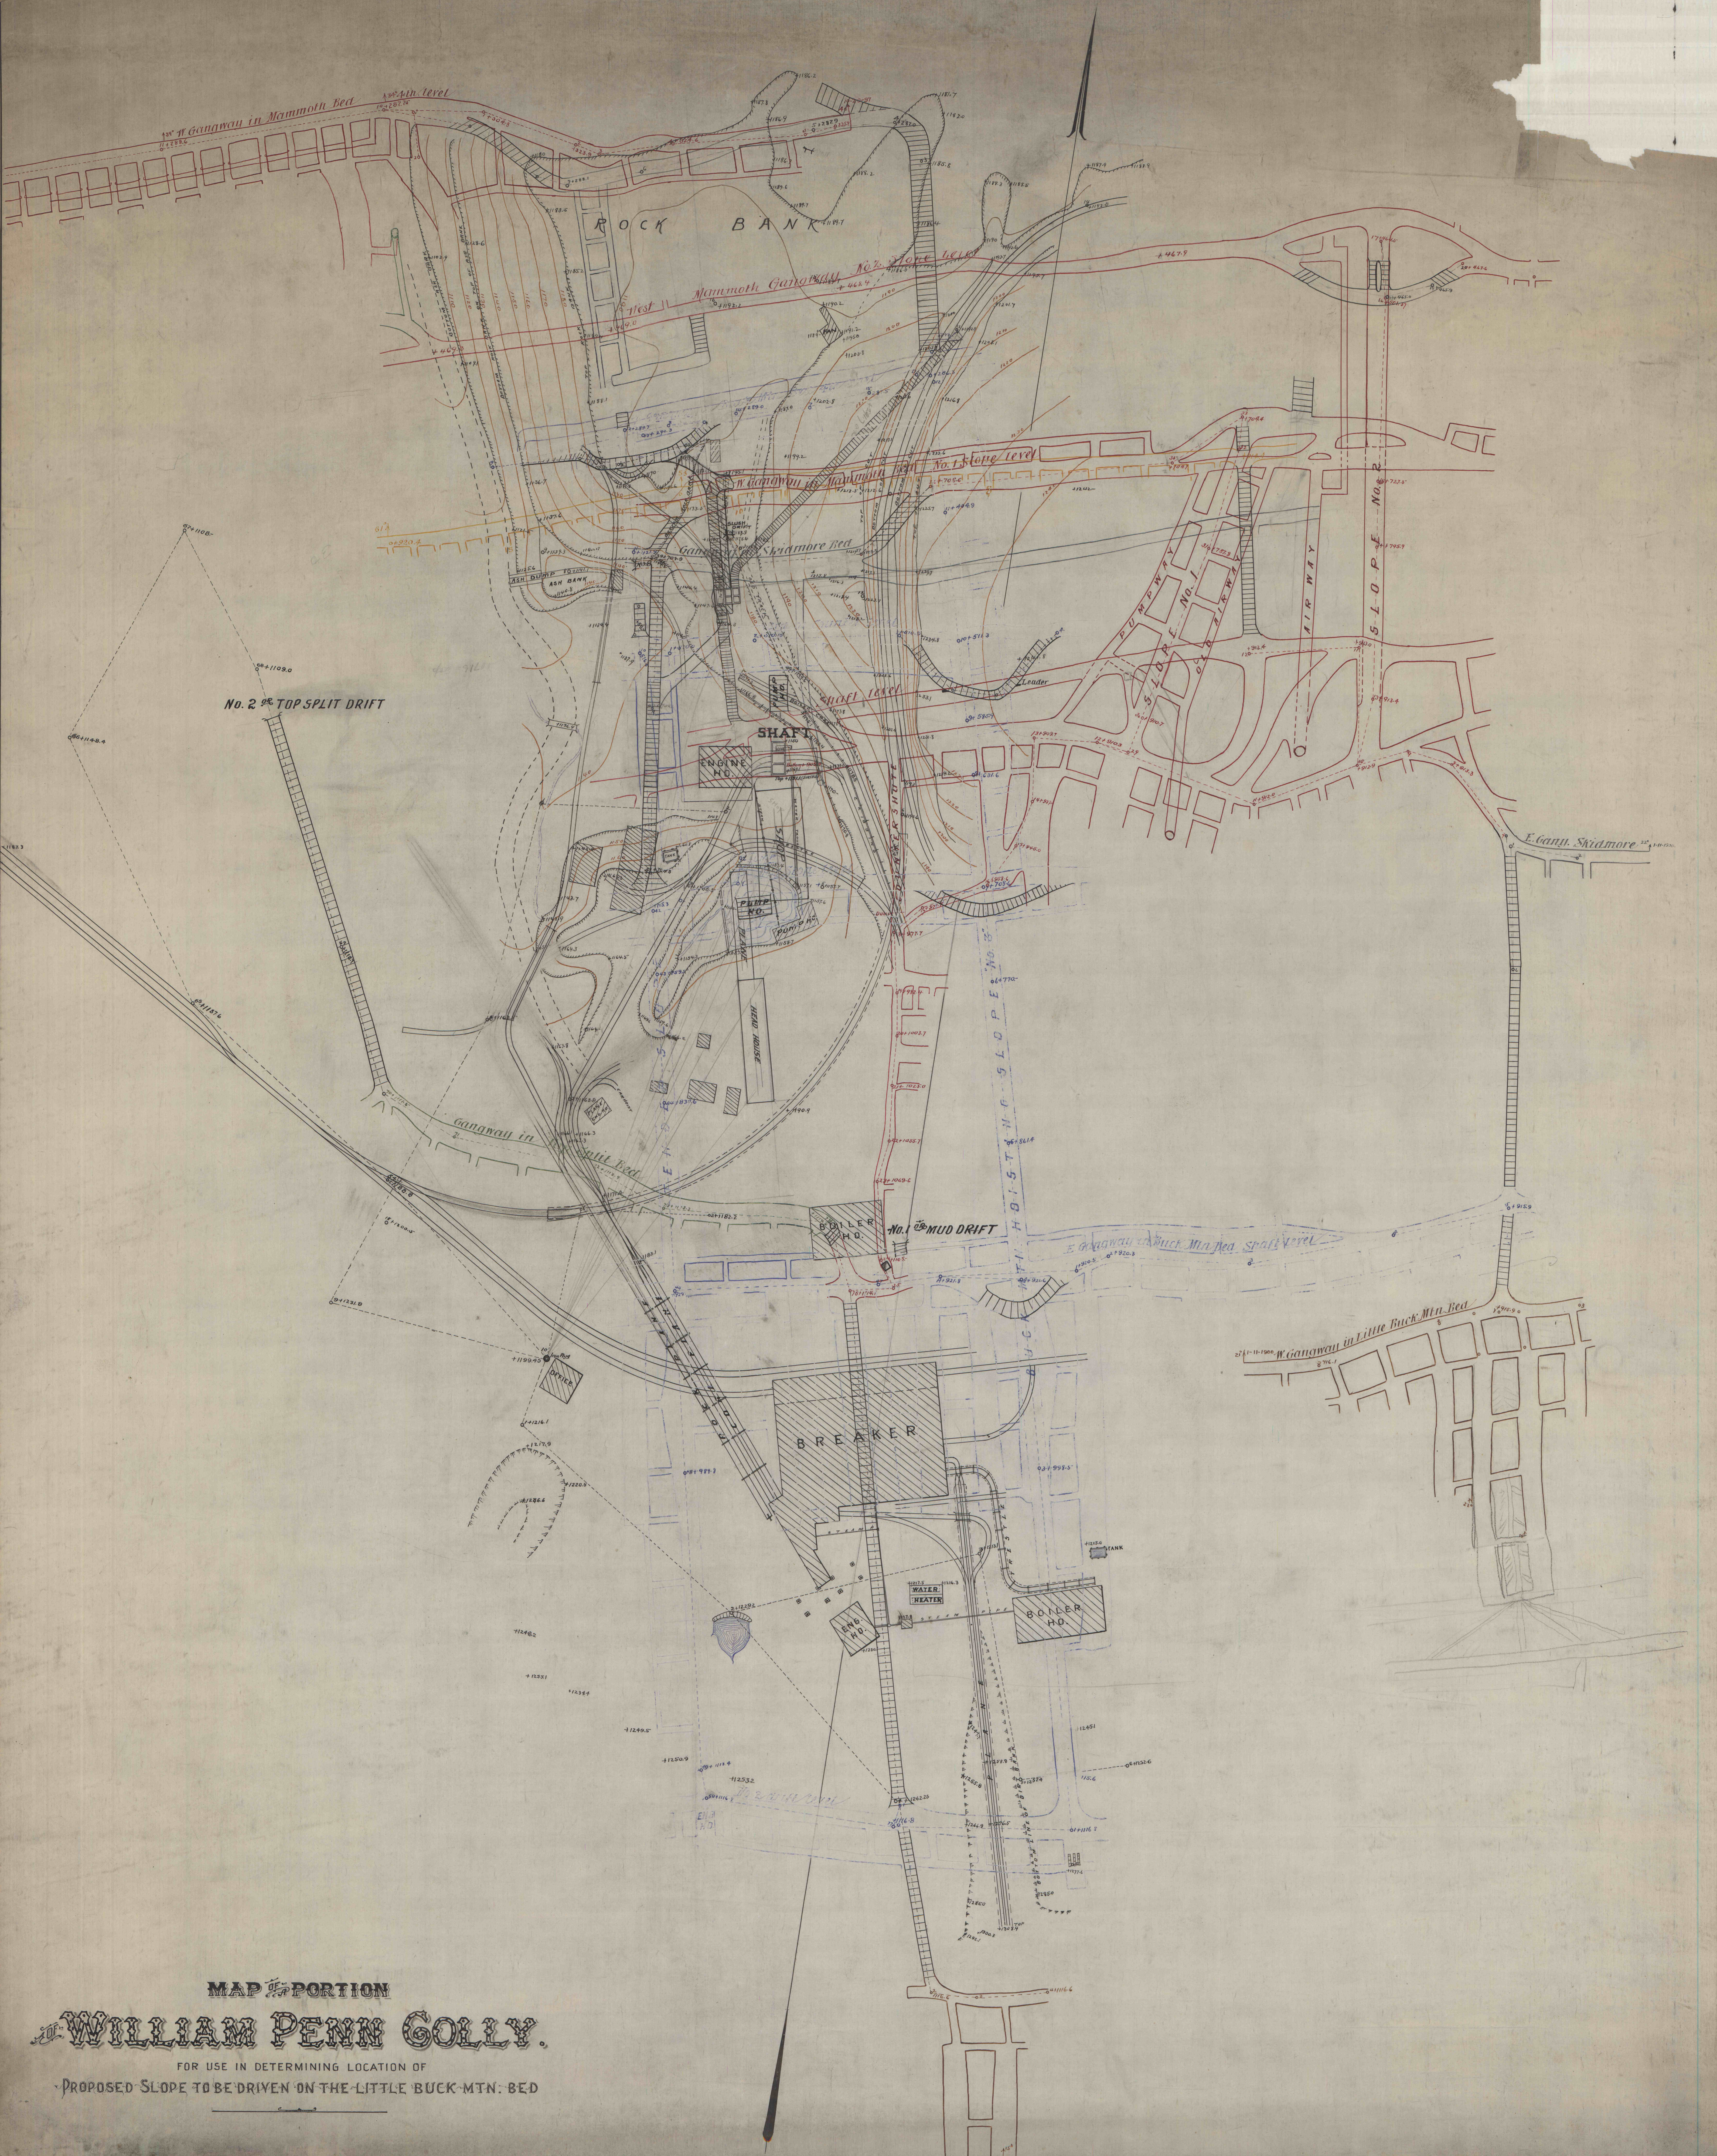

MAP & PORTION

WILLIAM PENN GOLLY.

FOR USE IN DETERMINING LOCATION OF

PROPOSED SLOPE TO BE DRIVEN ON THE LITTLE BUCK-MTN. BED