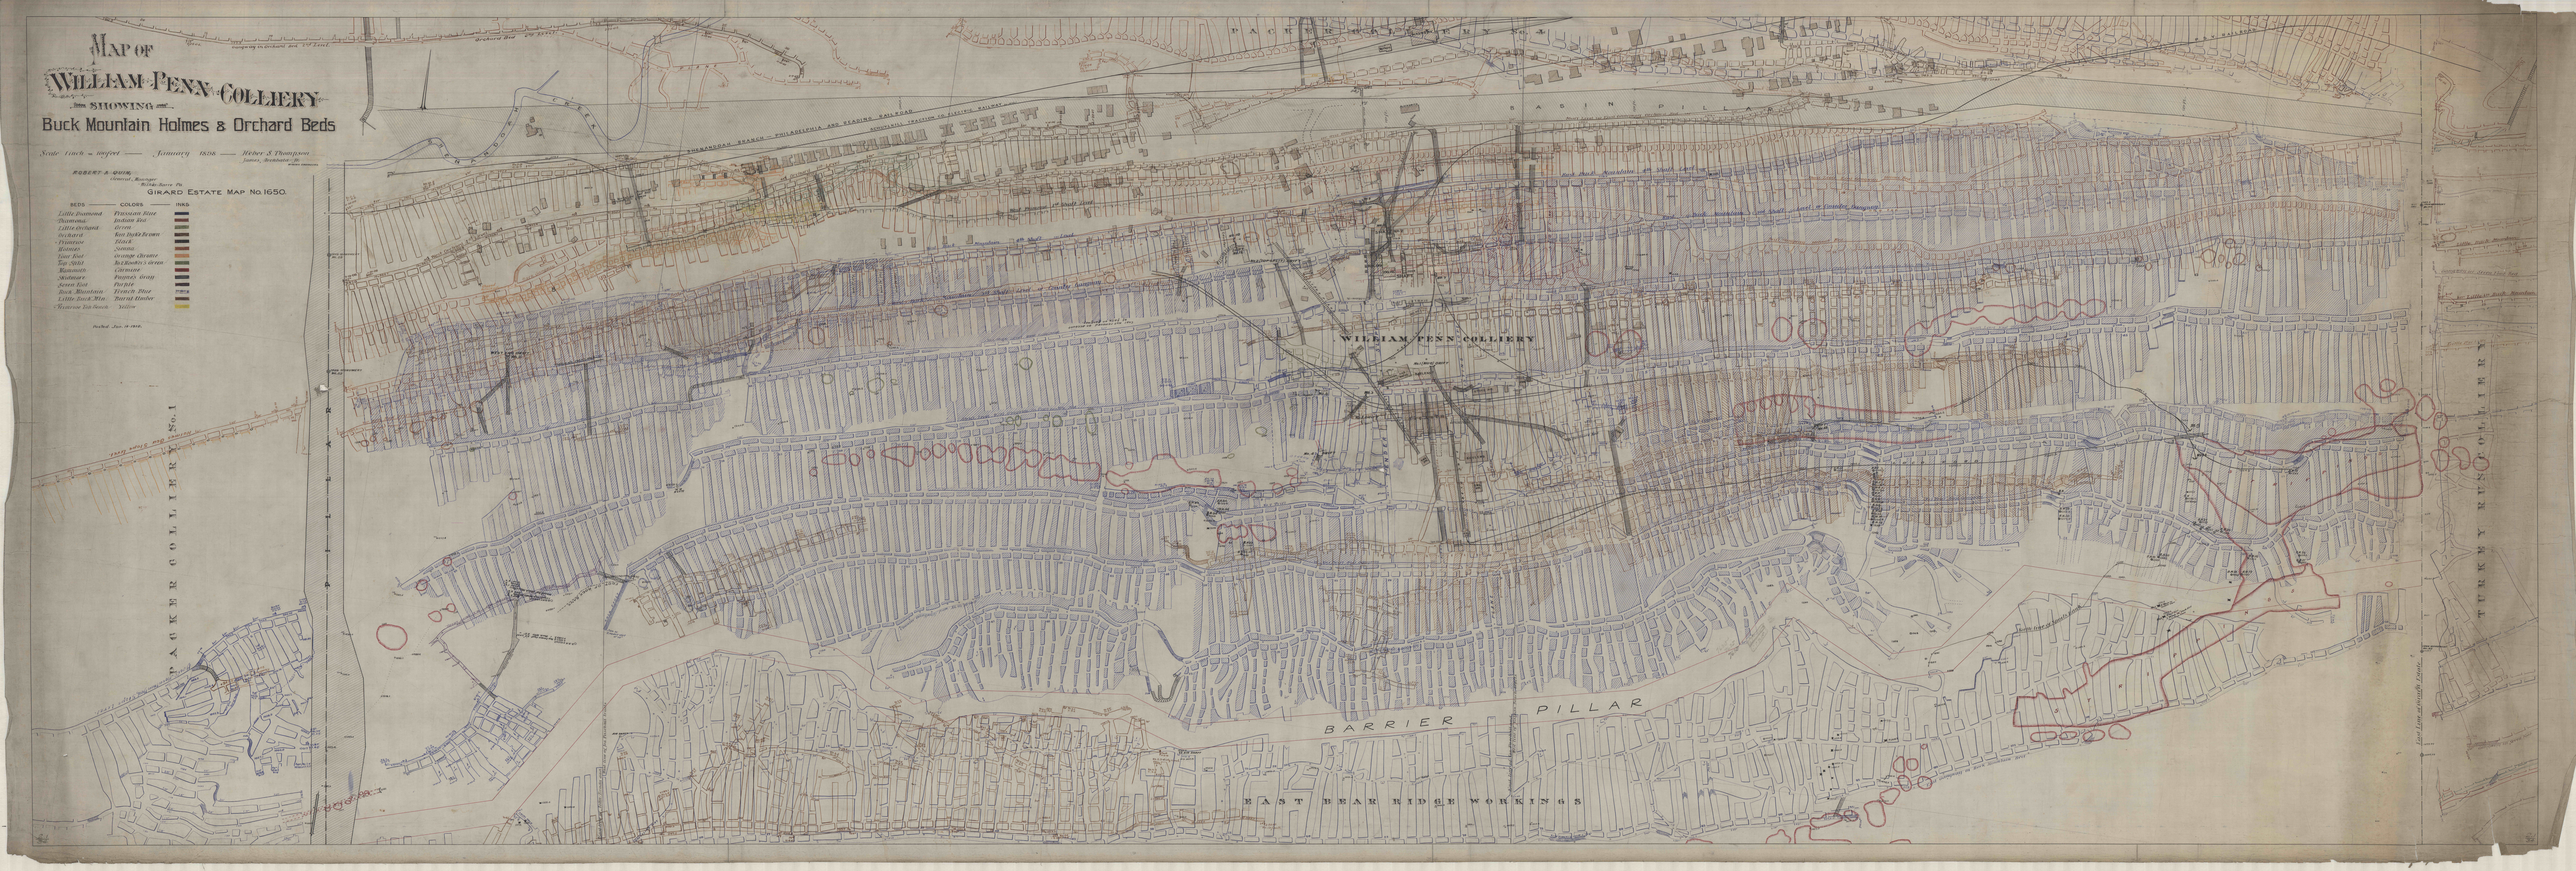

MAP OF
WILLIAM PENN COLLIERY
SHOWING
Buck Mountain Holmes & Orchard Beds

Scale 1 inch = 100 feet —— January 1898 —— Heber S. Thompson
James Archbald Jr.
MINING ENGINEERS

ROBERT A. QUIN,
General Manager
Wilkes-Barre Pa.

GIRARD ESTATE MAP No. 1650.

BEDS	COLORS	INKS
Little Diamond	Prussian Blue	▬
Diamond	Indian Red	▬
Little Orchard	Green	▬
Orchard	Van Dyke Brown	▬
* Primrose	Black	▬
Holmes	Sienna	▬
Four Foot	Orange Chrome	▬
Top Split	No. 2 Hooker's Green	▬
Mammoth	Carmine	▬
Skidmore	Payne's Gray	▬
Seven Foot	Purple	▬
Buck Mountain	French Blue	▬
Little Buck Mtn.	Burnt Umber	▬
* Primrose Top Bench	Yellow	▬

Posted. Jan. 14-1910.

Gangway in Orchard Bed 2nd Level.
PLANE
SHENANDOAH CREEK
SHENANDOAH BRANCH — PHILADELPHIA AND READING RAILROAD
SCHUYLKILL TRACTION CO. ELECTRIC RAILWAY
PACKER COLLIERY No. 4
WASHERY
Boilers
BLACKSMITH
BASIN PILLAR
Shaft Level 1st East Gangway Orchard Bed
Orchard 1st Level
West Primrose 1st Shaft Level
East Buck Mountain 4th Shaft Level
East Buck Mountain 3rd Shaft Level or Counter Gangway
Shaft Level East Gangway Holmes Bed
P. S. V. RAILROAD
120 ft.
WILLIAM PENN COLLIERY
SHAFT No. 2
IRON MONUMENT No. 58
IRON MONUMENT No. 59
Little Buck Mountain
Gangway in Seven Foot Bed
Little Buck Mt.
LOCO. ROAD
STRIPPINGS
PILLAR
PACKER COLLIERY No. 1
BARRIER PILLAR
EAST BEAR RIDGE WORKINGS
TURKEY RUN COLLIERY