


*PLAN Showing location of the Mahanoy Plane Tail Track Mahanoy & Shamokin Br. of the P. & R. R. P. through Lands of the City of Philadelphia.*

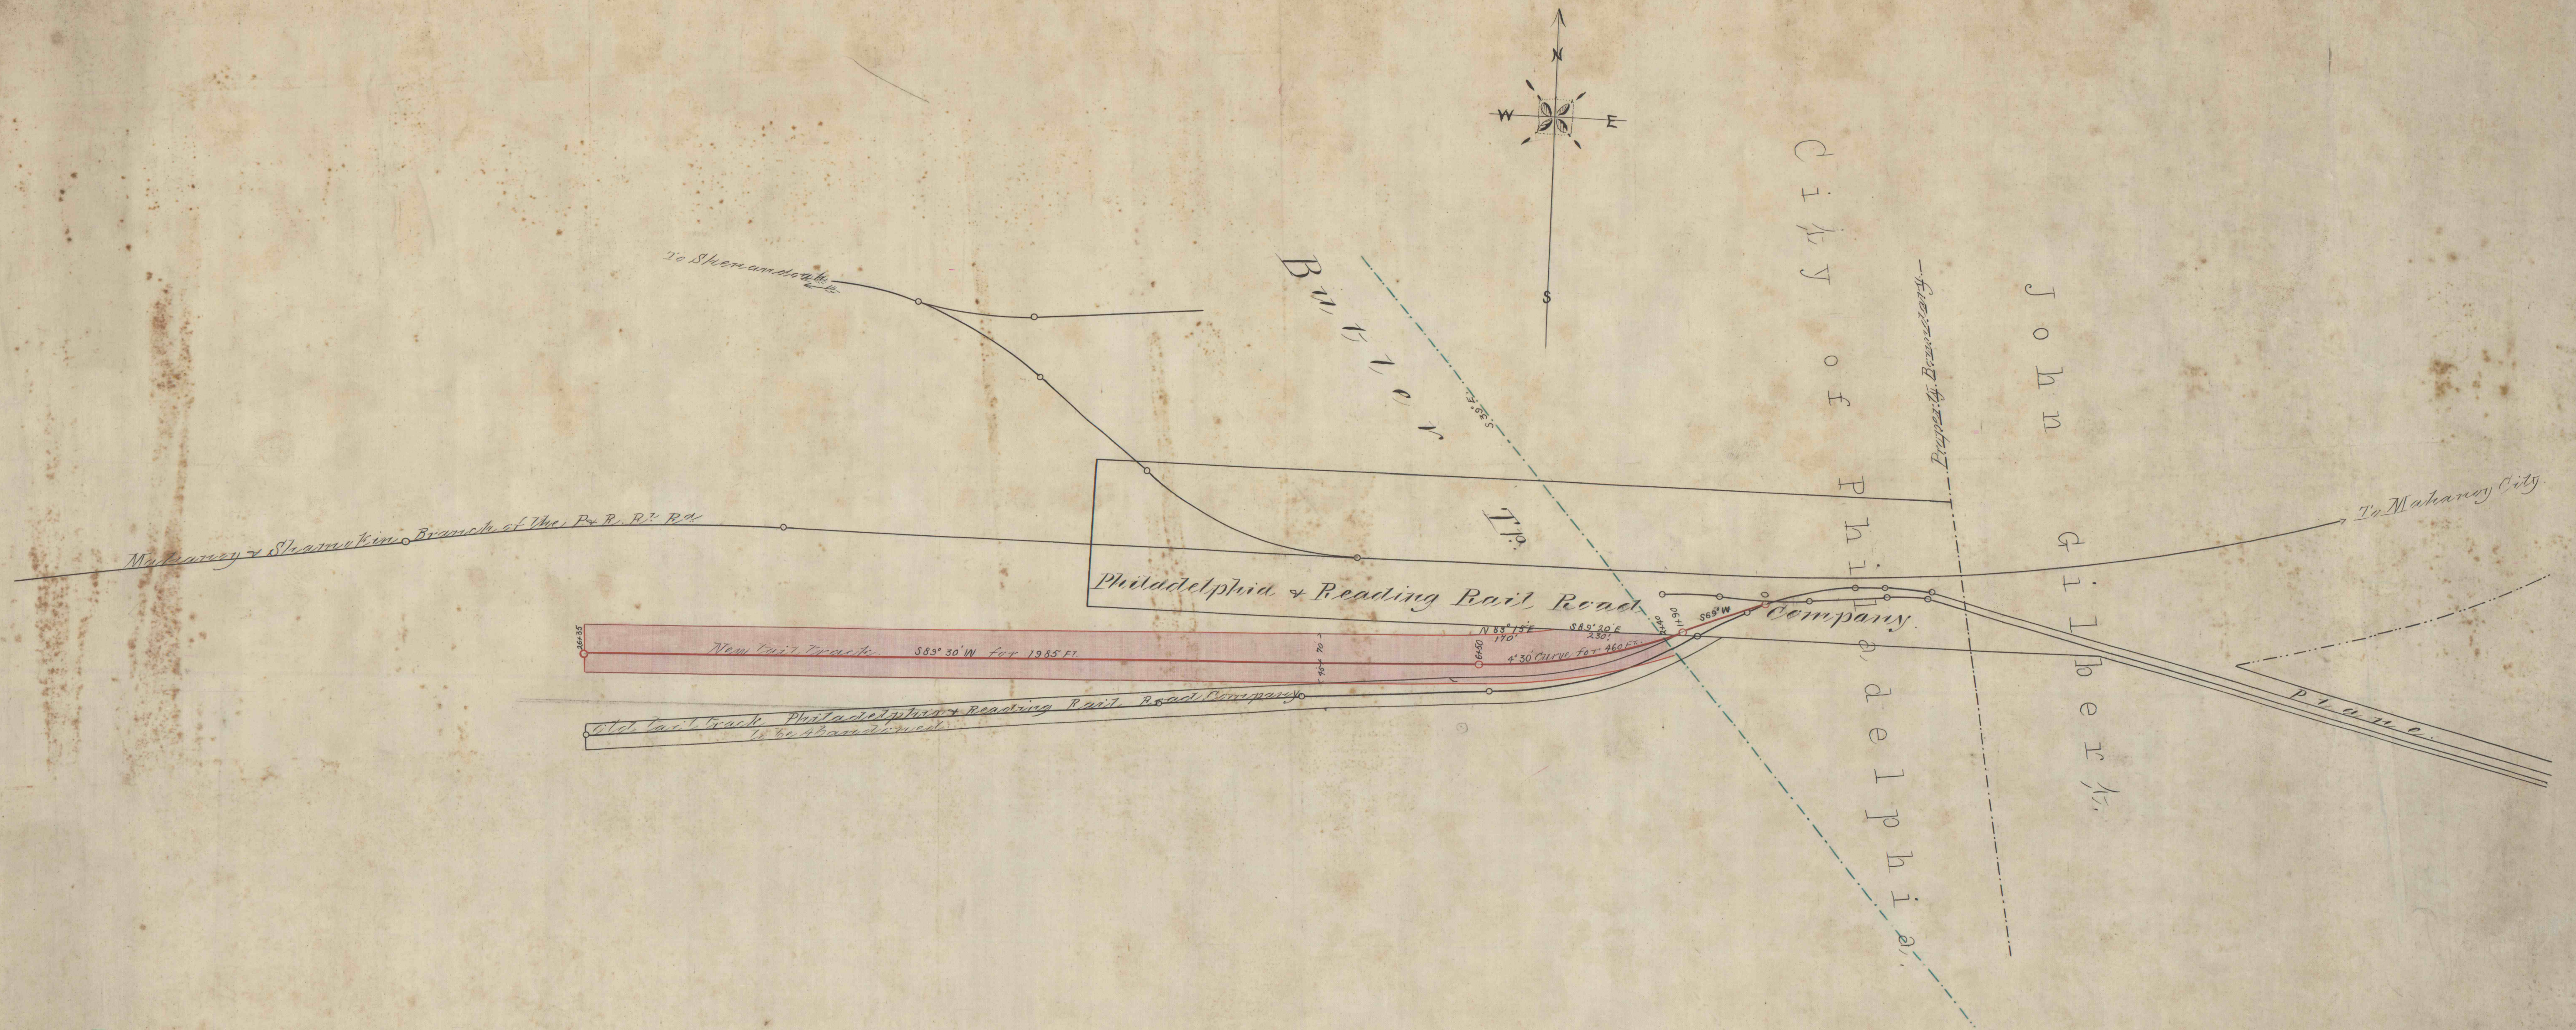

Scale, 200 Feet to 1 Inch.